NOTE: OHIO TURNPIKE COMMISSION RIGHT OF WAY IS ON A CURVE, RADIUS = 5,849.58', WITH AN EXISTING WIRE FENCE BUILT ON STRAIGHT LINE CHORDS, ABOUT 300' EACH, WITH 4-INCH DIAM. STEEL POSTS AT ANGLE POINTS. USED POINTS 0.50 FEET FROM EACH POST, SHOWN AS: 1F, 2F, 3F, 5F, 6F, 7F, 8F, 9F.

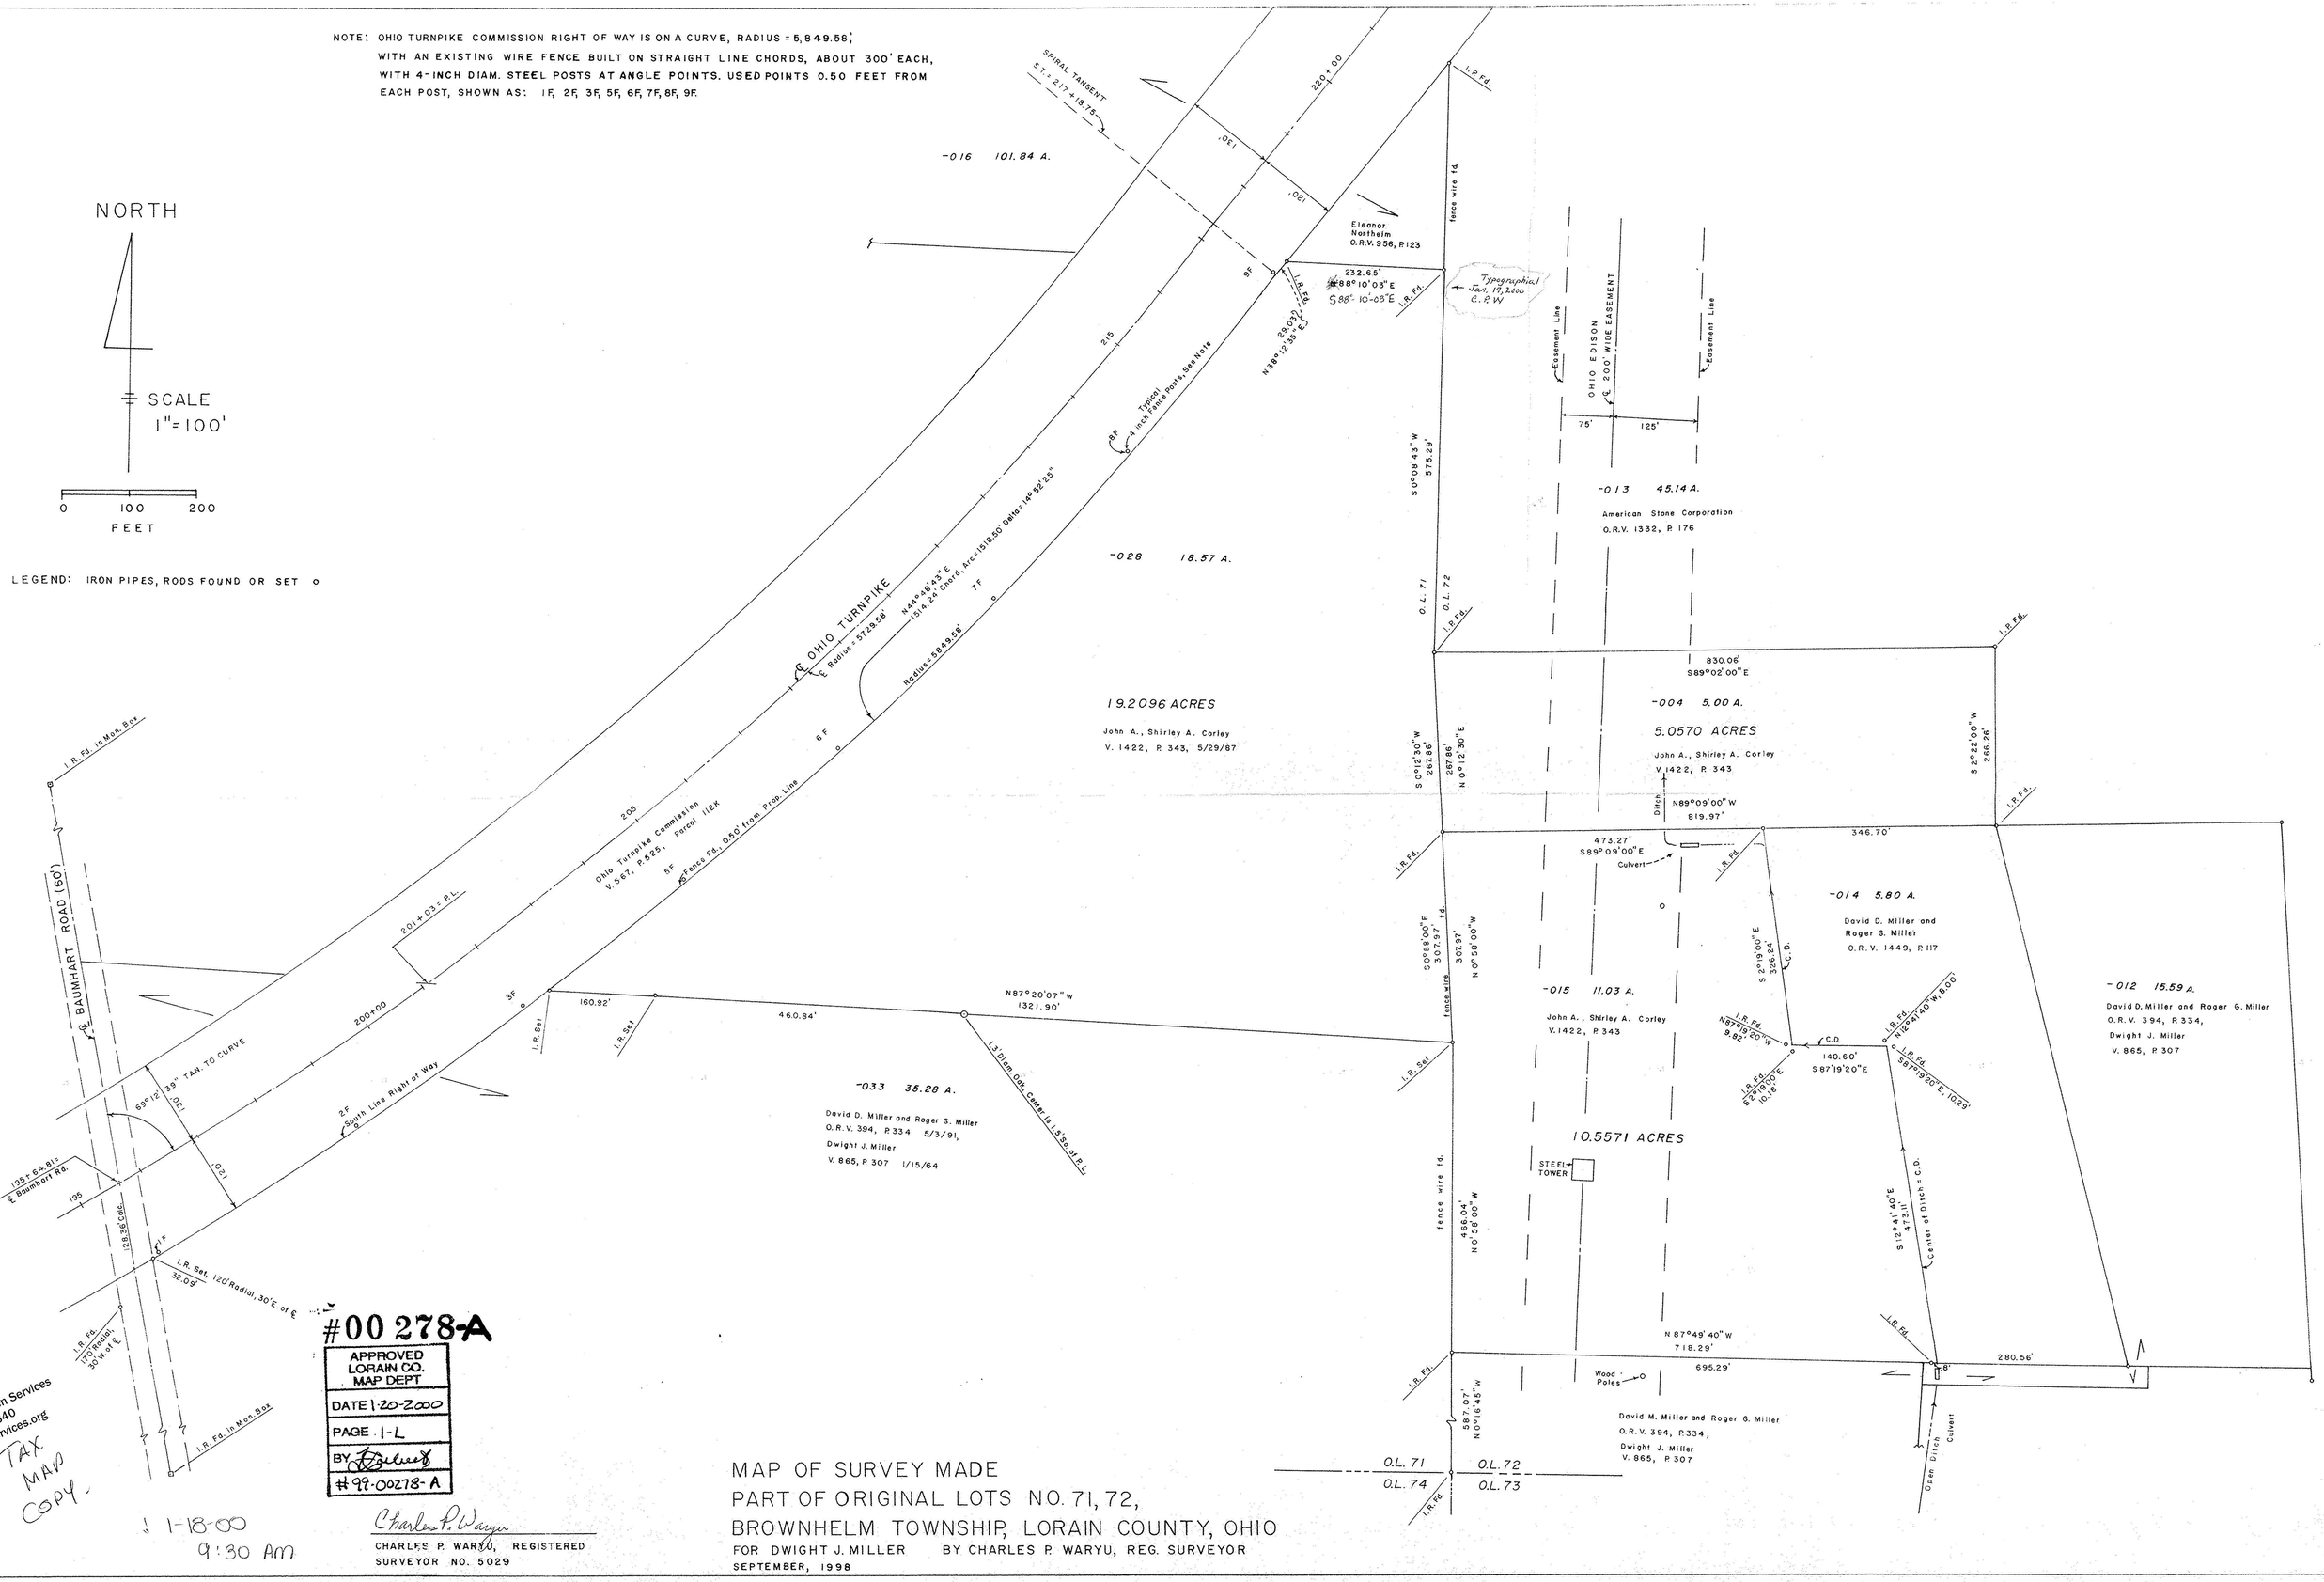

#00 278-A

APPROVED LORAIN CO. MAP DEPT

DATE 1-20-2000

PAGE 1-L

BY

#99-00278-A

Children Services 29-5340 enservices.org

TAX MAP COPY.

1-18-00 9:30 AM

Charles P. Waryu

CHARLES P. WARYU, REGISTERED SURVEYOR NO. 5029

MAP OF SURVEY MADE
PART OF ORIGINAL LOTS NO. 71, 72,
BROWNHELM TOWNSHIP, LORAIN COUNTY, OHIO
FOR DWIGHT J. MILLER BY CHARLES P. WARYU, REG. SURVEYOR
SEPTEMBER, 1998