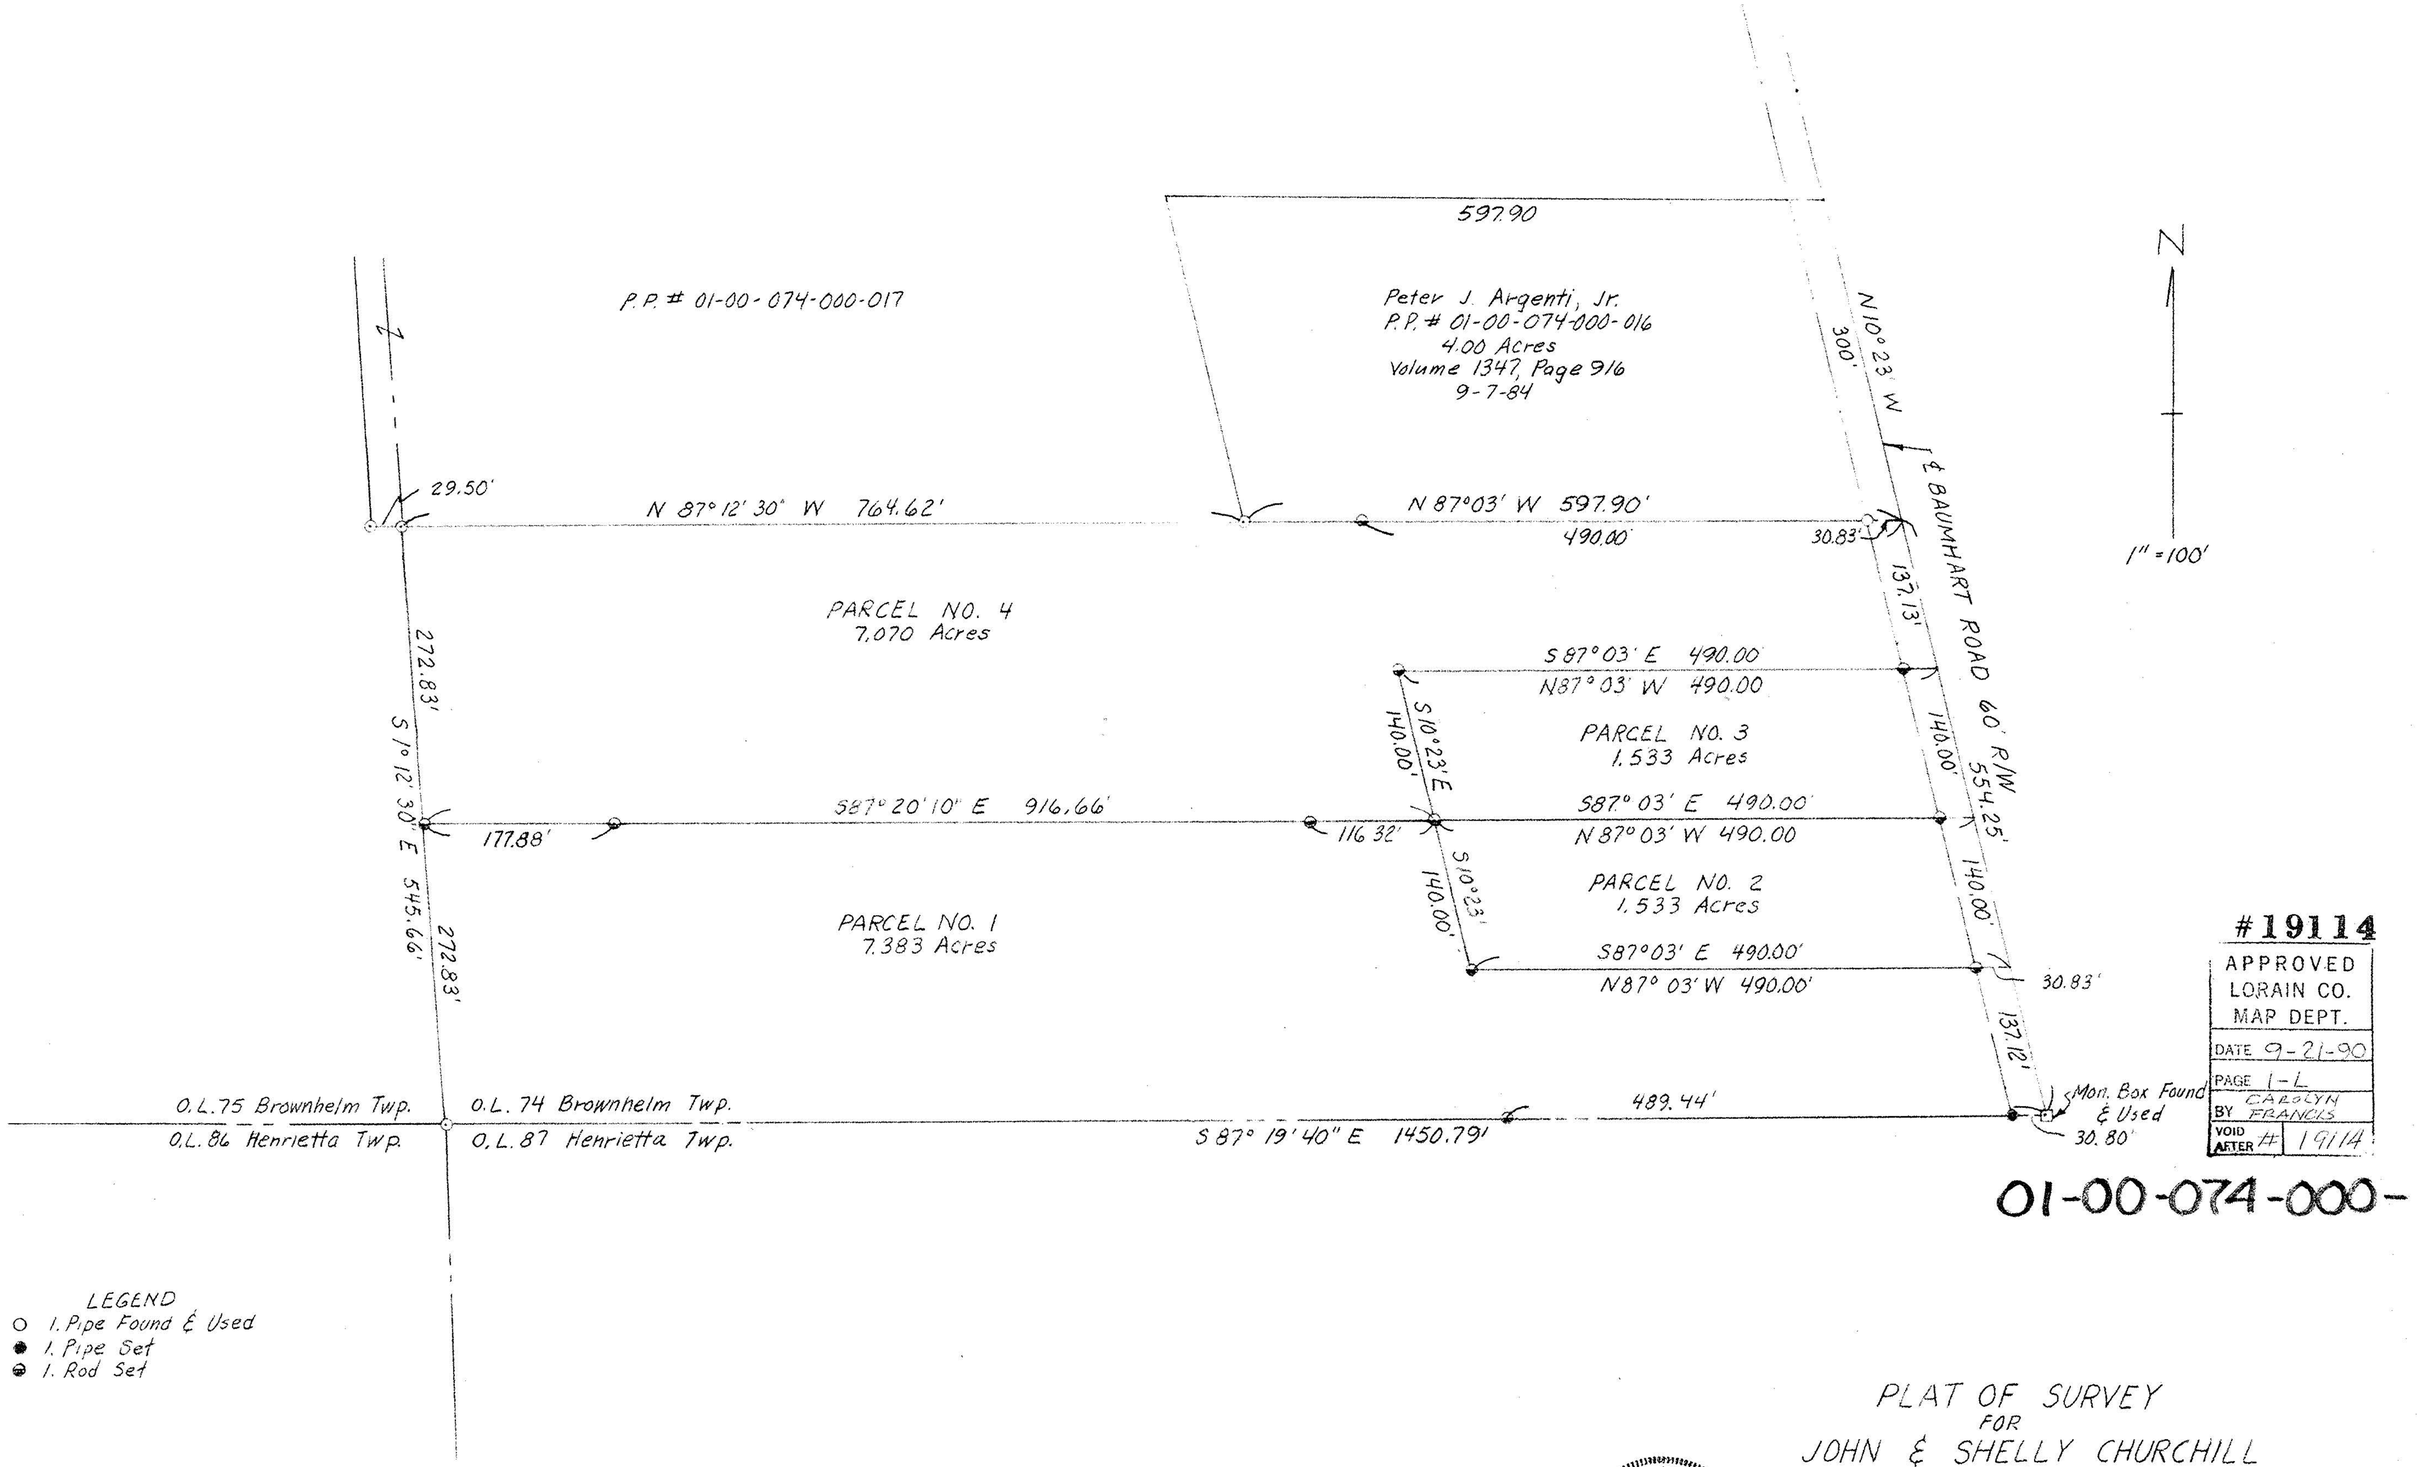


#19114

APPROVED
LORAIN CO.
MAP DEPT.
DATE 9-21-90
PAGE 1-L
BY CAROLYN FRANCIS
VOID AFTER # 19114

01-00-074-000-

STATE OF OHIO
LAWRENCE V. McGLINCHY
4970
REGISTERED
SURVEYOR

PLAT OF SURVEY
FOR
JOHN & SHELLY CHURCHILL

O.L. 74 BROWNHELM TOWNSHIP
LORAIN COUNTY, OHIO

McGLINCHY & ASSOCIATES
PROFESSIONAL ENGINEER & SURVEYOR
AMHERST, OHIO 216-988-2394
Job No. 908797 August 5, 1990