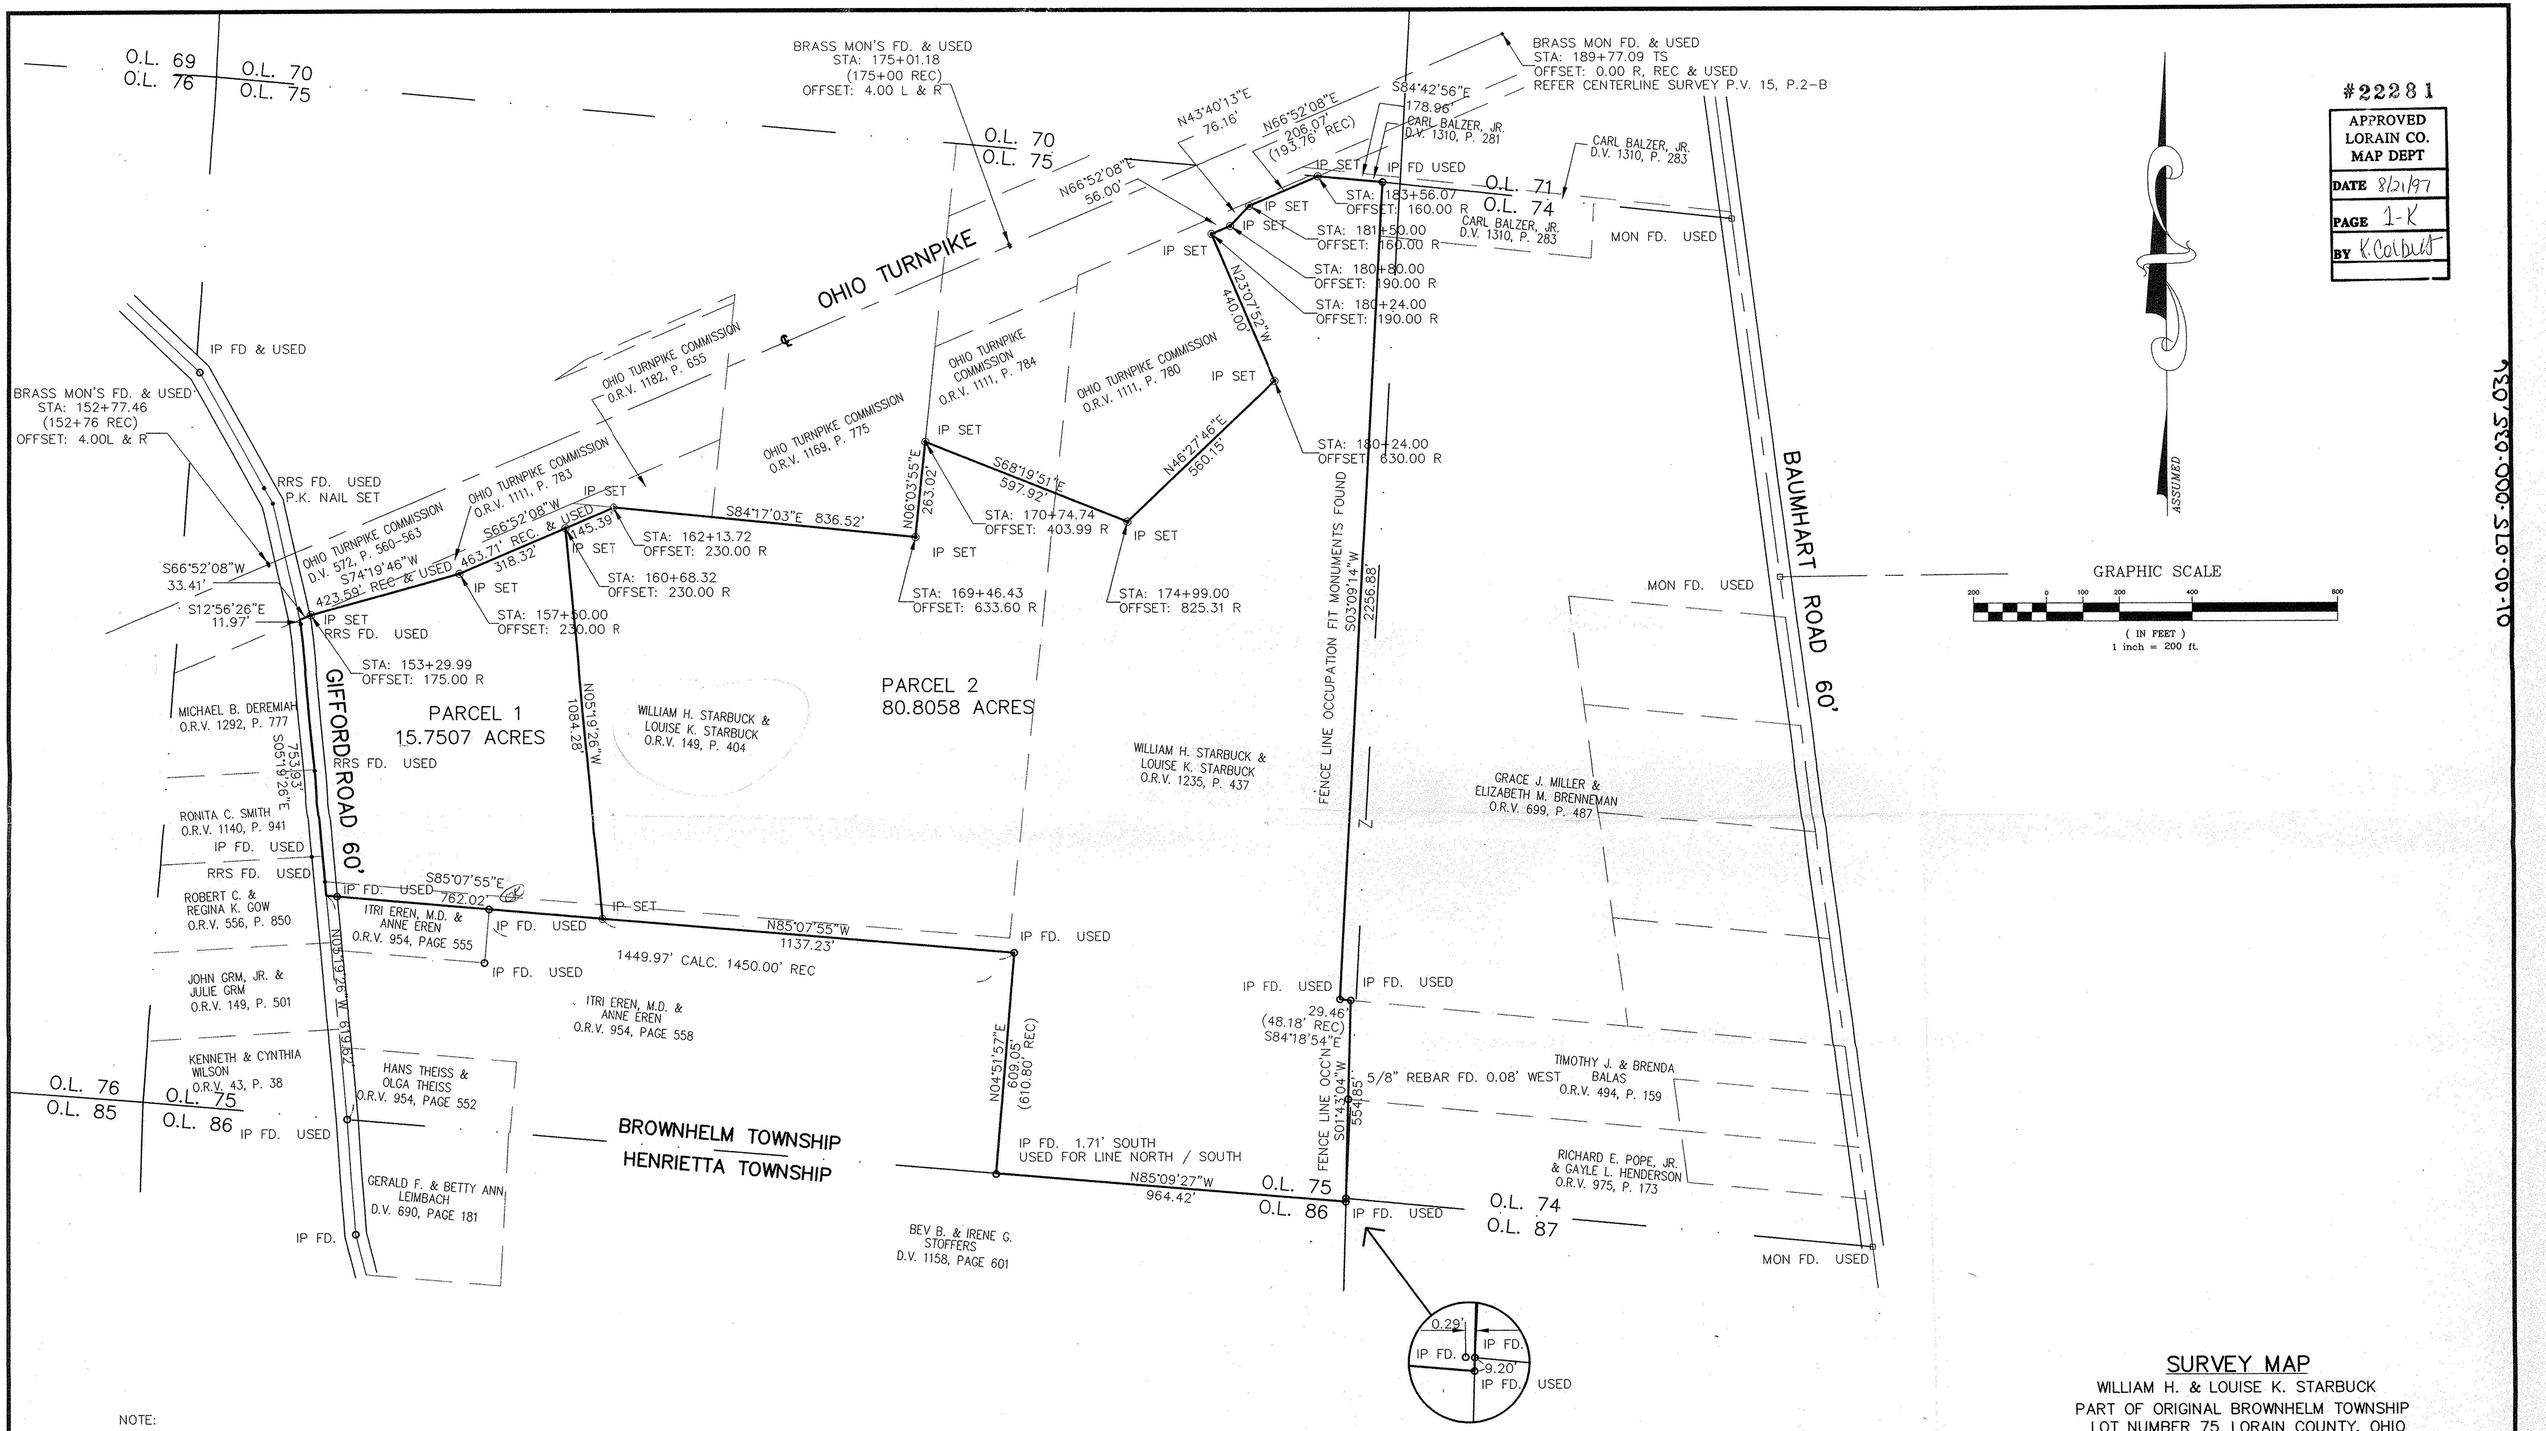

#22281

APPROVED
LORAIN CO.
MAP DEPT

DATE 8/21/97

PAGE 1-K

BY K. Colbert

01-00-075.000-035,036

NOTE:

CENTERLINE OF GIFFORD ROAD ESTABLISHED BY RECOVERING MONUMENTS NOTED IN THE CENTERLINE SURVEY OF GIFFORD ROAD DATED SEPT. 1962, ON FILE AT THE LORAIN COUNTY ENGINEER'S OFFICE.

STATE OF OHIO
PHILLIP A. ROSEBECK
No. 6696
REGISTERED SURVEYOR

BEARINGS SHOWN ARE TO AN ASSUMED MERIDIAN AND ARE FOR THE PURPOSE OF DESCRIBING ANGLES ONLY. THE UNADJUSTED ERROR OF CLOSURE EXCEEDED 1 : 10,000.

PHIL A. ROSEBECK, REGISTERED SURVEYOR #6696

SURVEY MAP

WILLIAM H. & LOUISE K. STARBUCK

PART OF ORIGINAL BROWNHELM TOWNSHIP
LOT NUMBER 75 LORAIN COUNTY, OHIO

SCALE : 1" = 200' JULY 1997

P. A. ROSEBECK & ASSOCIATES
REGISTERED SURVEYOR
705 WILLOW CREEK DRIVE
AMHERST, OH 44001
PH: (216) 988-4657