01-20-026-000-037

#19060

Map of Part of Lot 26 Gore Strip Brownhelm Twp. Lorain Co. Ohio
Scale 1" 200' March 31, 1979

By Arnold F. Koepp Reg. Surveyor No 4306

revised Aug. 3, 1979 easement
Schmalz property

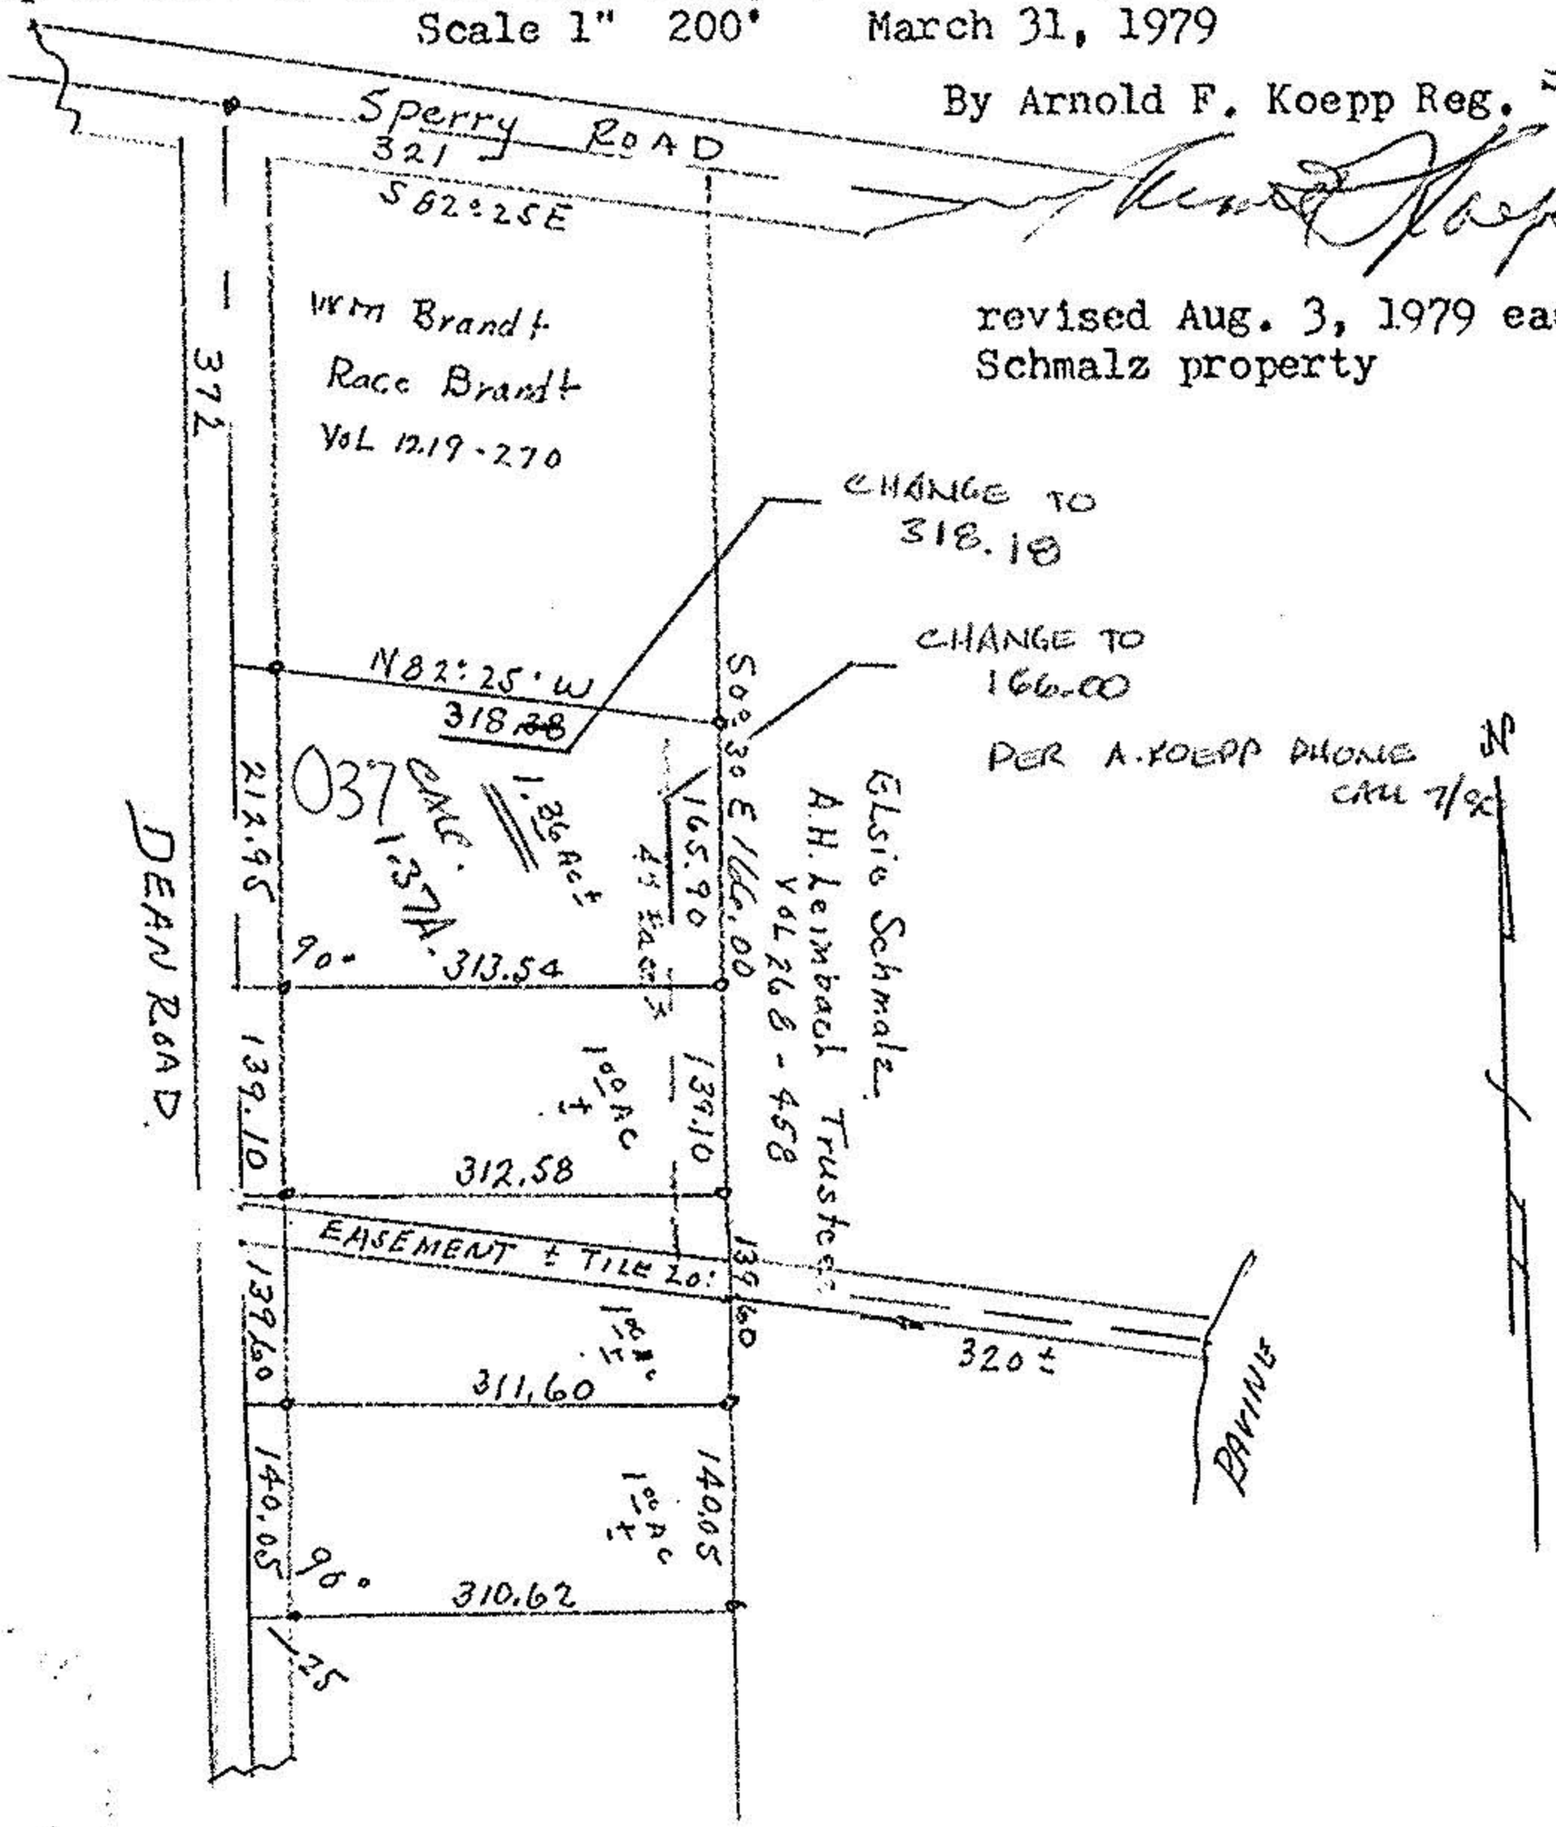

● Indicated iron pins set

#19060

APPROVED
LORAIN CO.
MAP DEPT.

DATE 7-30-90

PAGE 1-I

BY CAROLYN FRANCIS

VOID AFTER # 19060

REZONE
7-31-90
1-I
T. McClain

#19060

1-I