


OK-20-017
OK-20-027-112-010

1-00-016-A

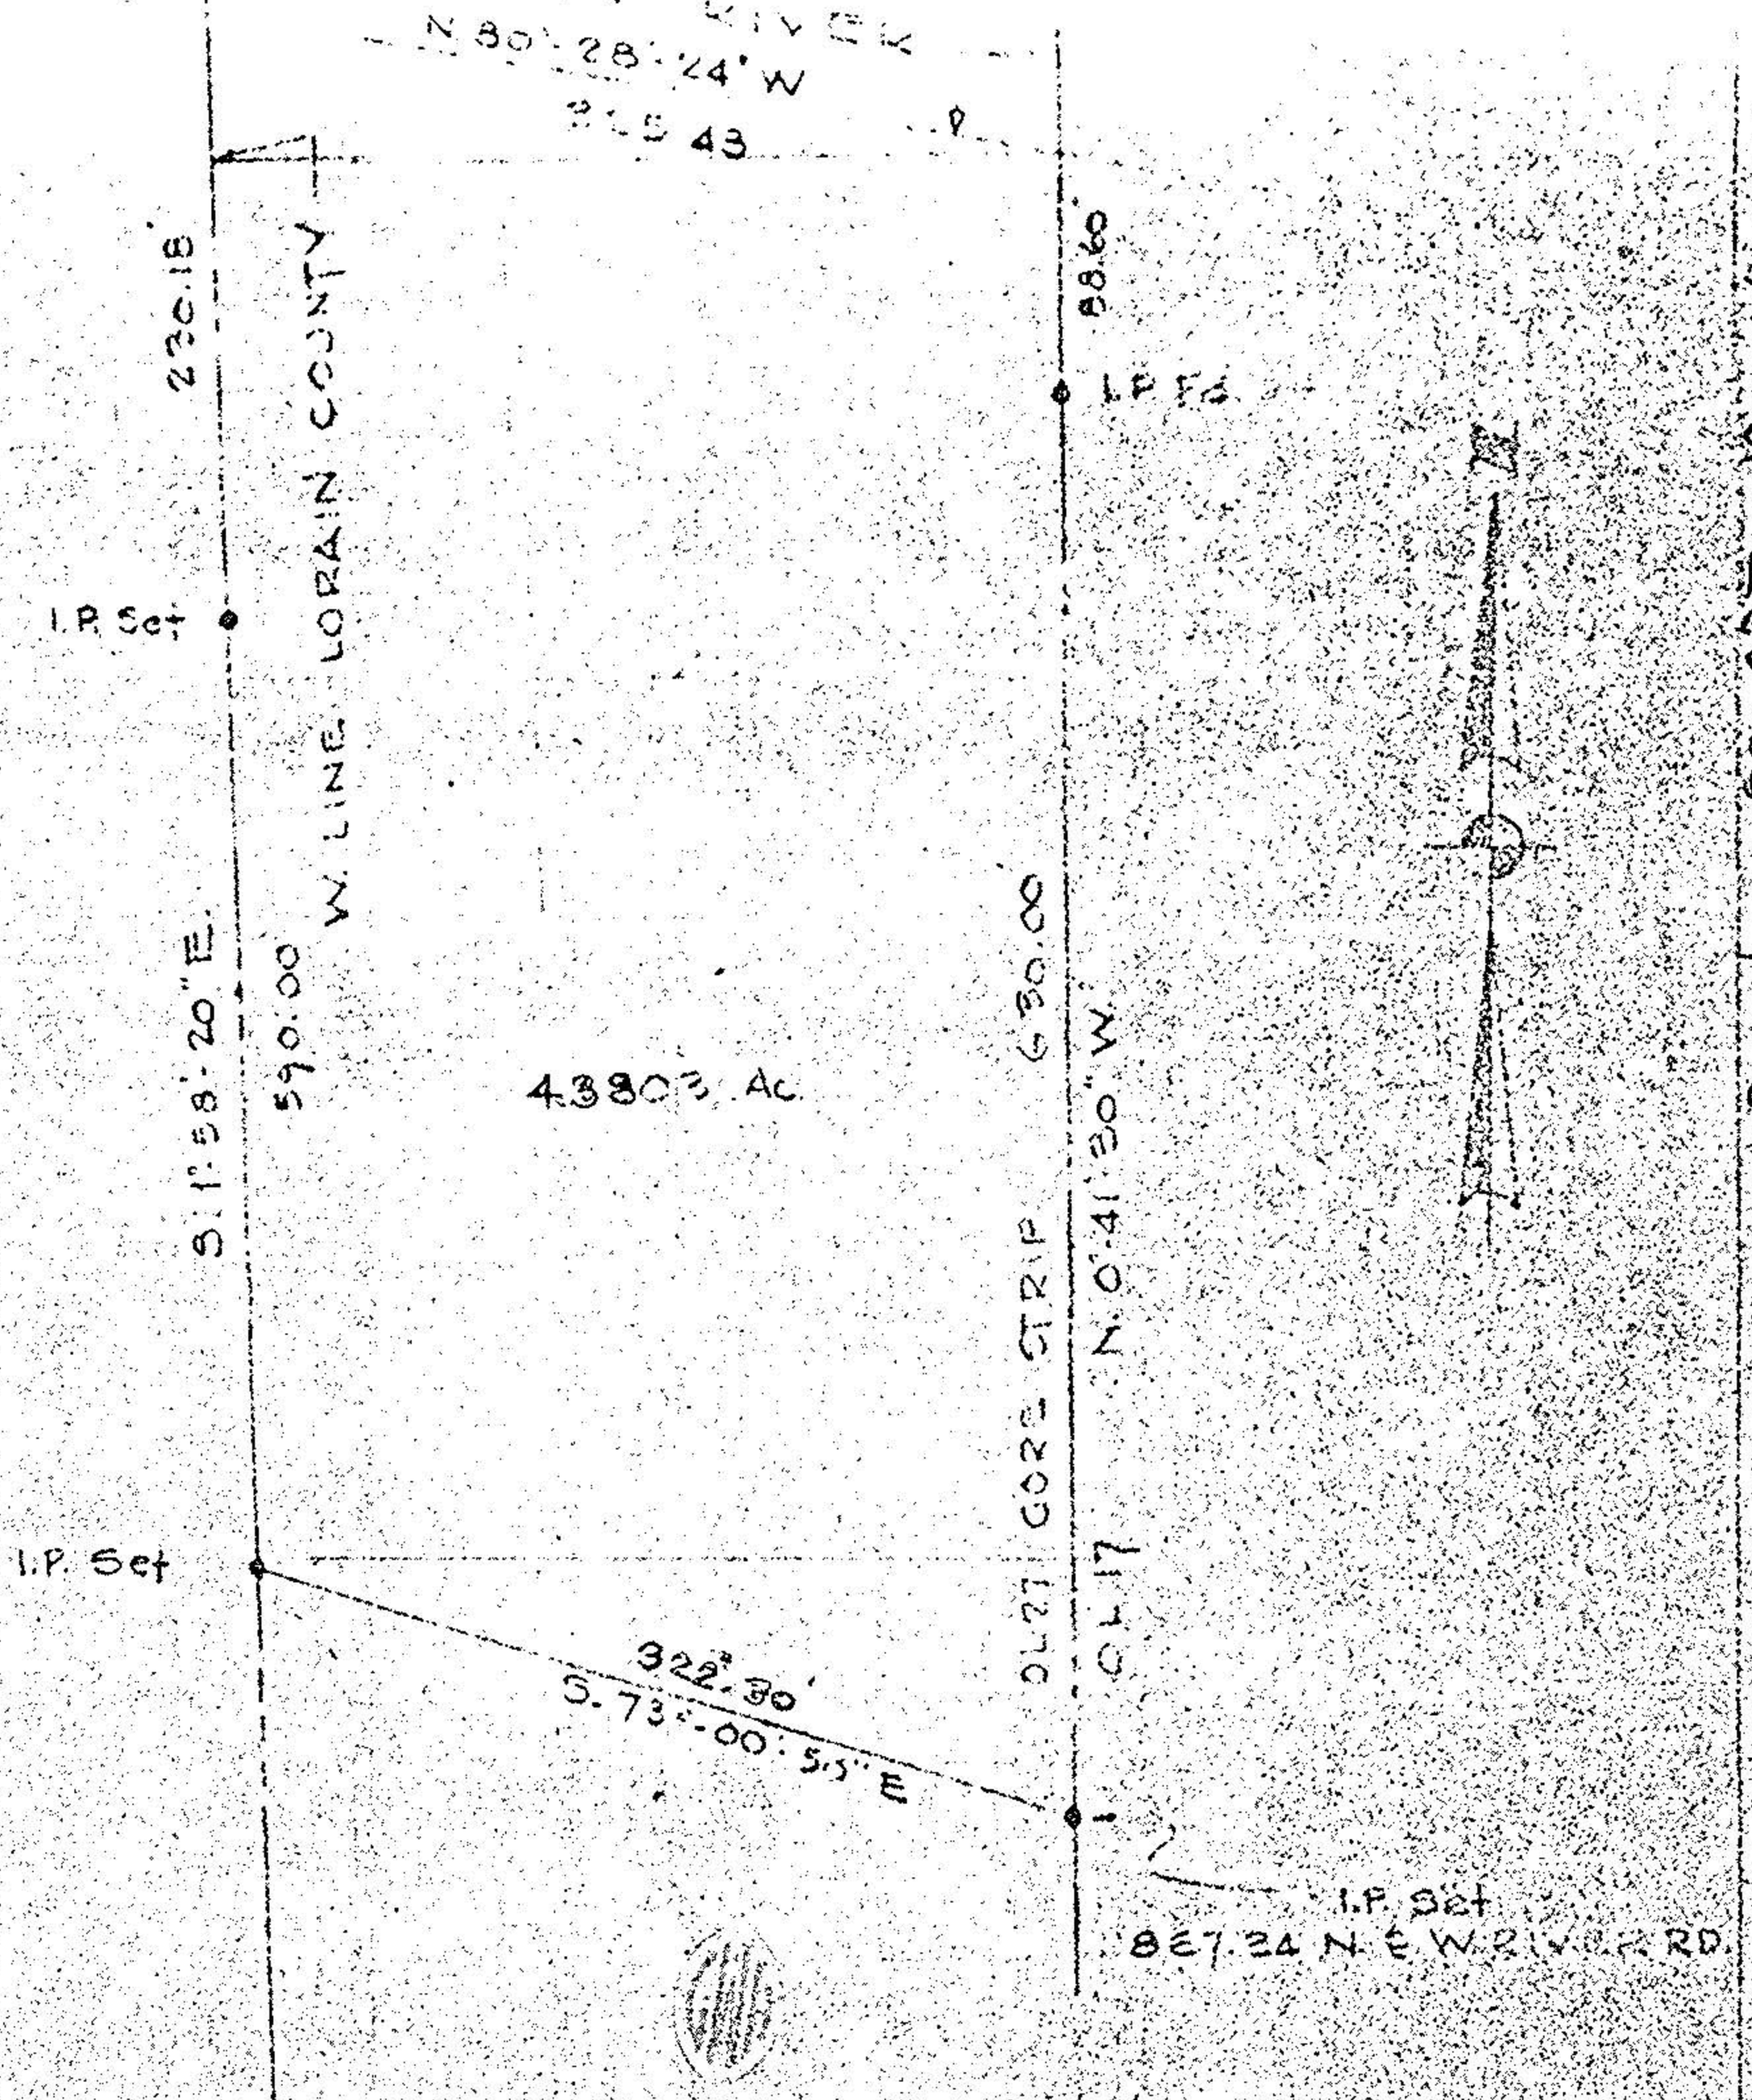

4.3803 Ac.

SURVEY FOR GEORGE PHILLIPS

OL. 27 GORE STRIP, BROWNHELM TWP
 LORAIN COUNTY, OHIO
 SCALE 1"=100' MAY 1975
 LAUNDON SIMON, CARR & ASSOC.
 ENGINEERS SURVEYORS

MAY 9 1975

75-339

010-01-20-00-10 N 33

1-20-027

1-00-027