

1-20-027-102-

01-20-027-102-027


Scale  
1" = 40 FT

Map #4

1-00-001-C

Tax Map Copy

11-17-65  
L.W. Hall

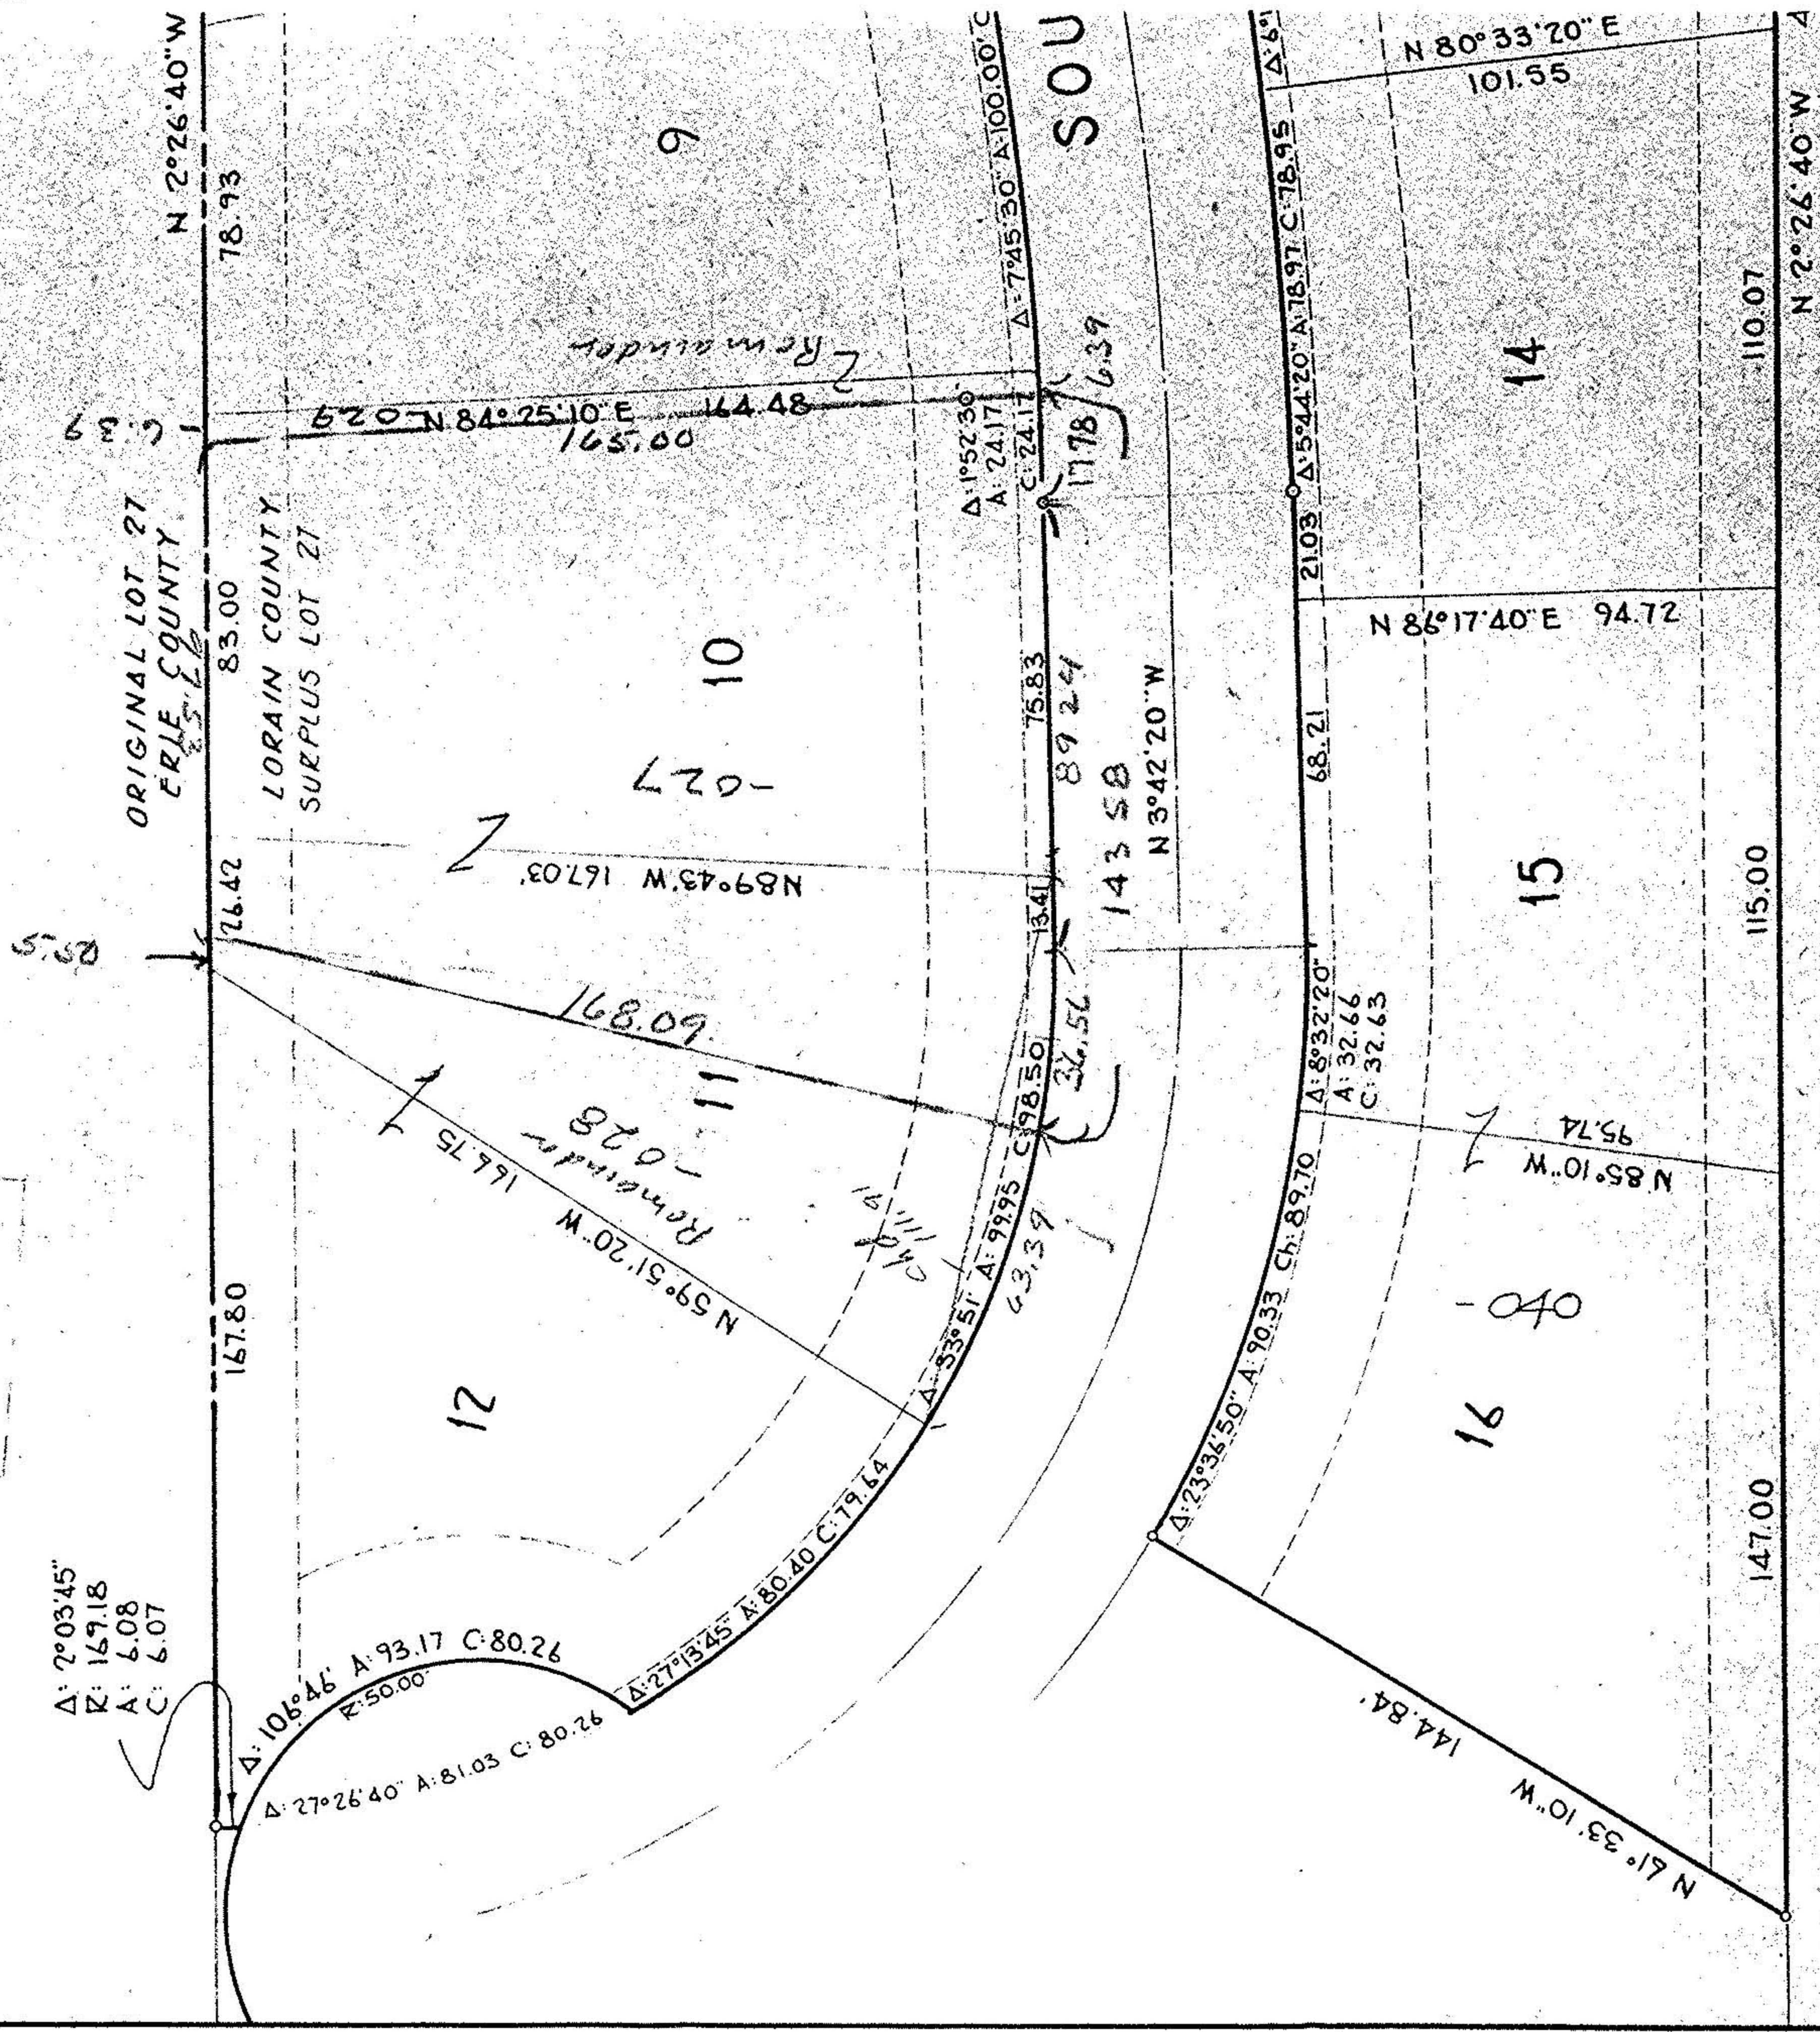

Tax Map Copy