Map of Part of Surplus Lot 26 Brownhelm Twp. Lorain Co. Ohio
Scale 1" 100' Aug. 8, 1978
By Arnold F. Koepp Registered Surveyor No. 4306

01-20-026-000-013

Goes with Map to be drawn -12-13-78

#12329
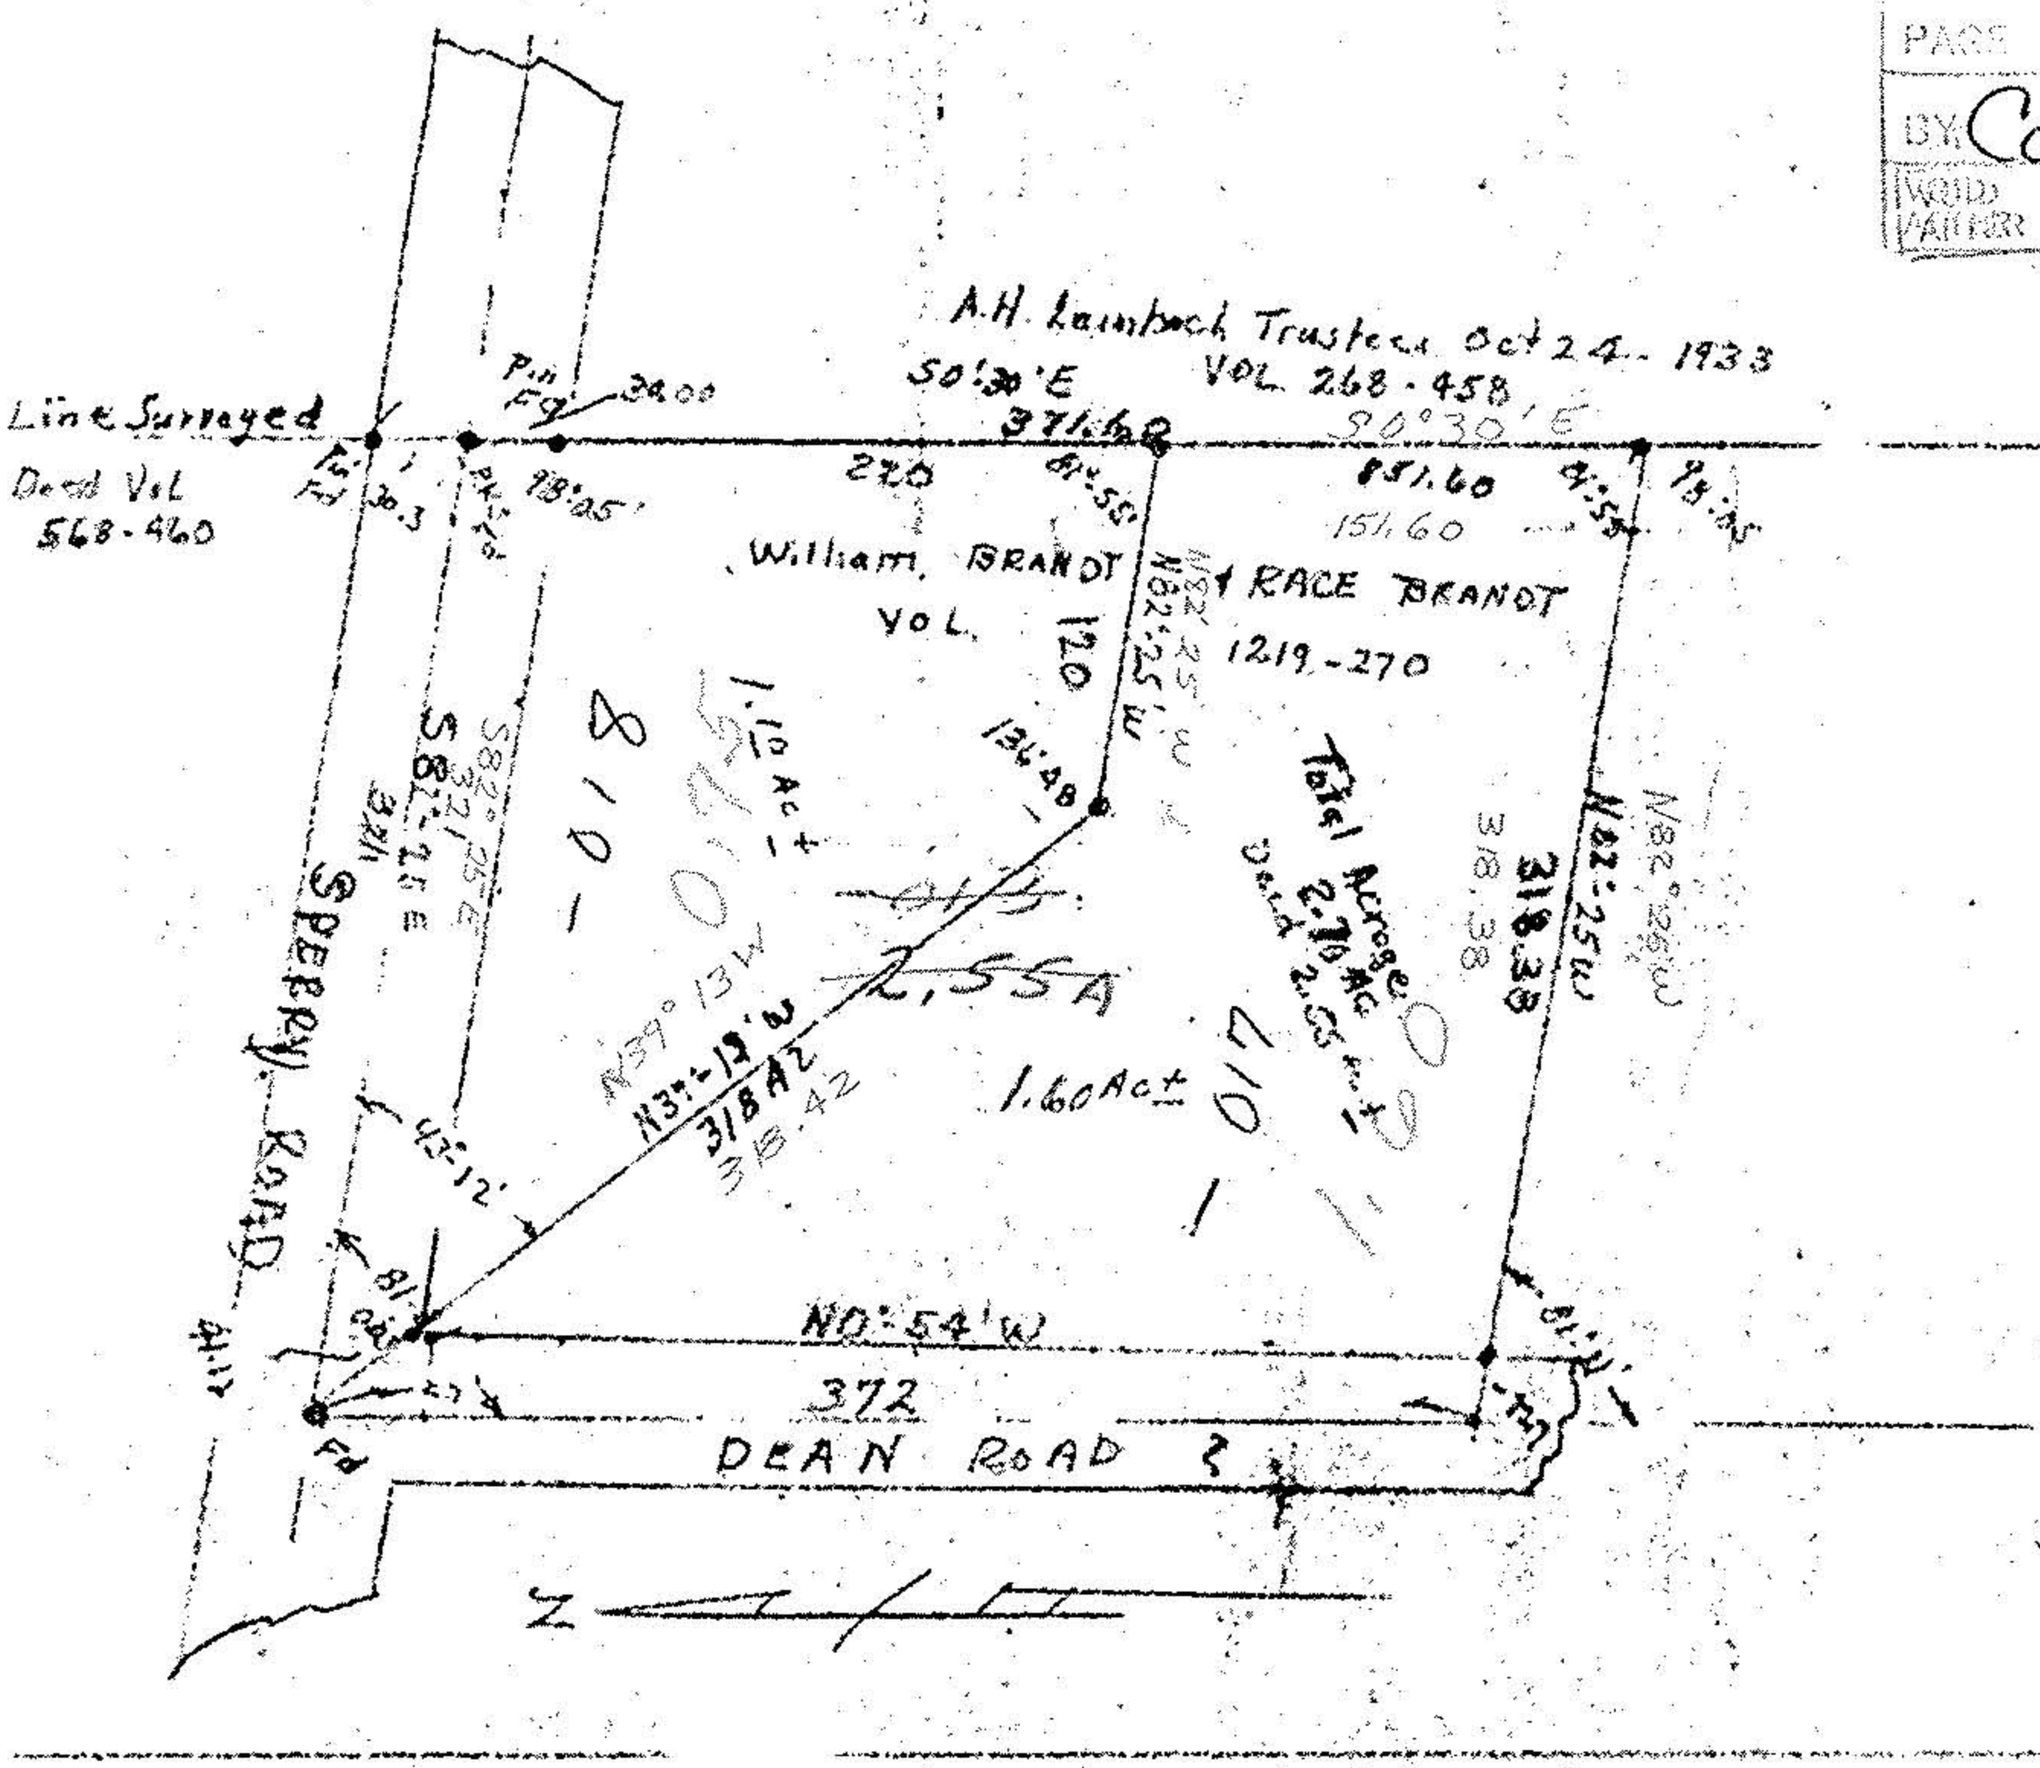
APPROVED
LORAIN CO.
MAP DEPT.
DATE 12-13-78
PAGE 1-I
BY Carolyn
WOLD PARCEL 12329