1-I

1/LOT 26

01-20-026-000-017

-018

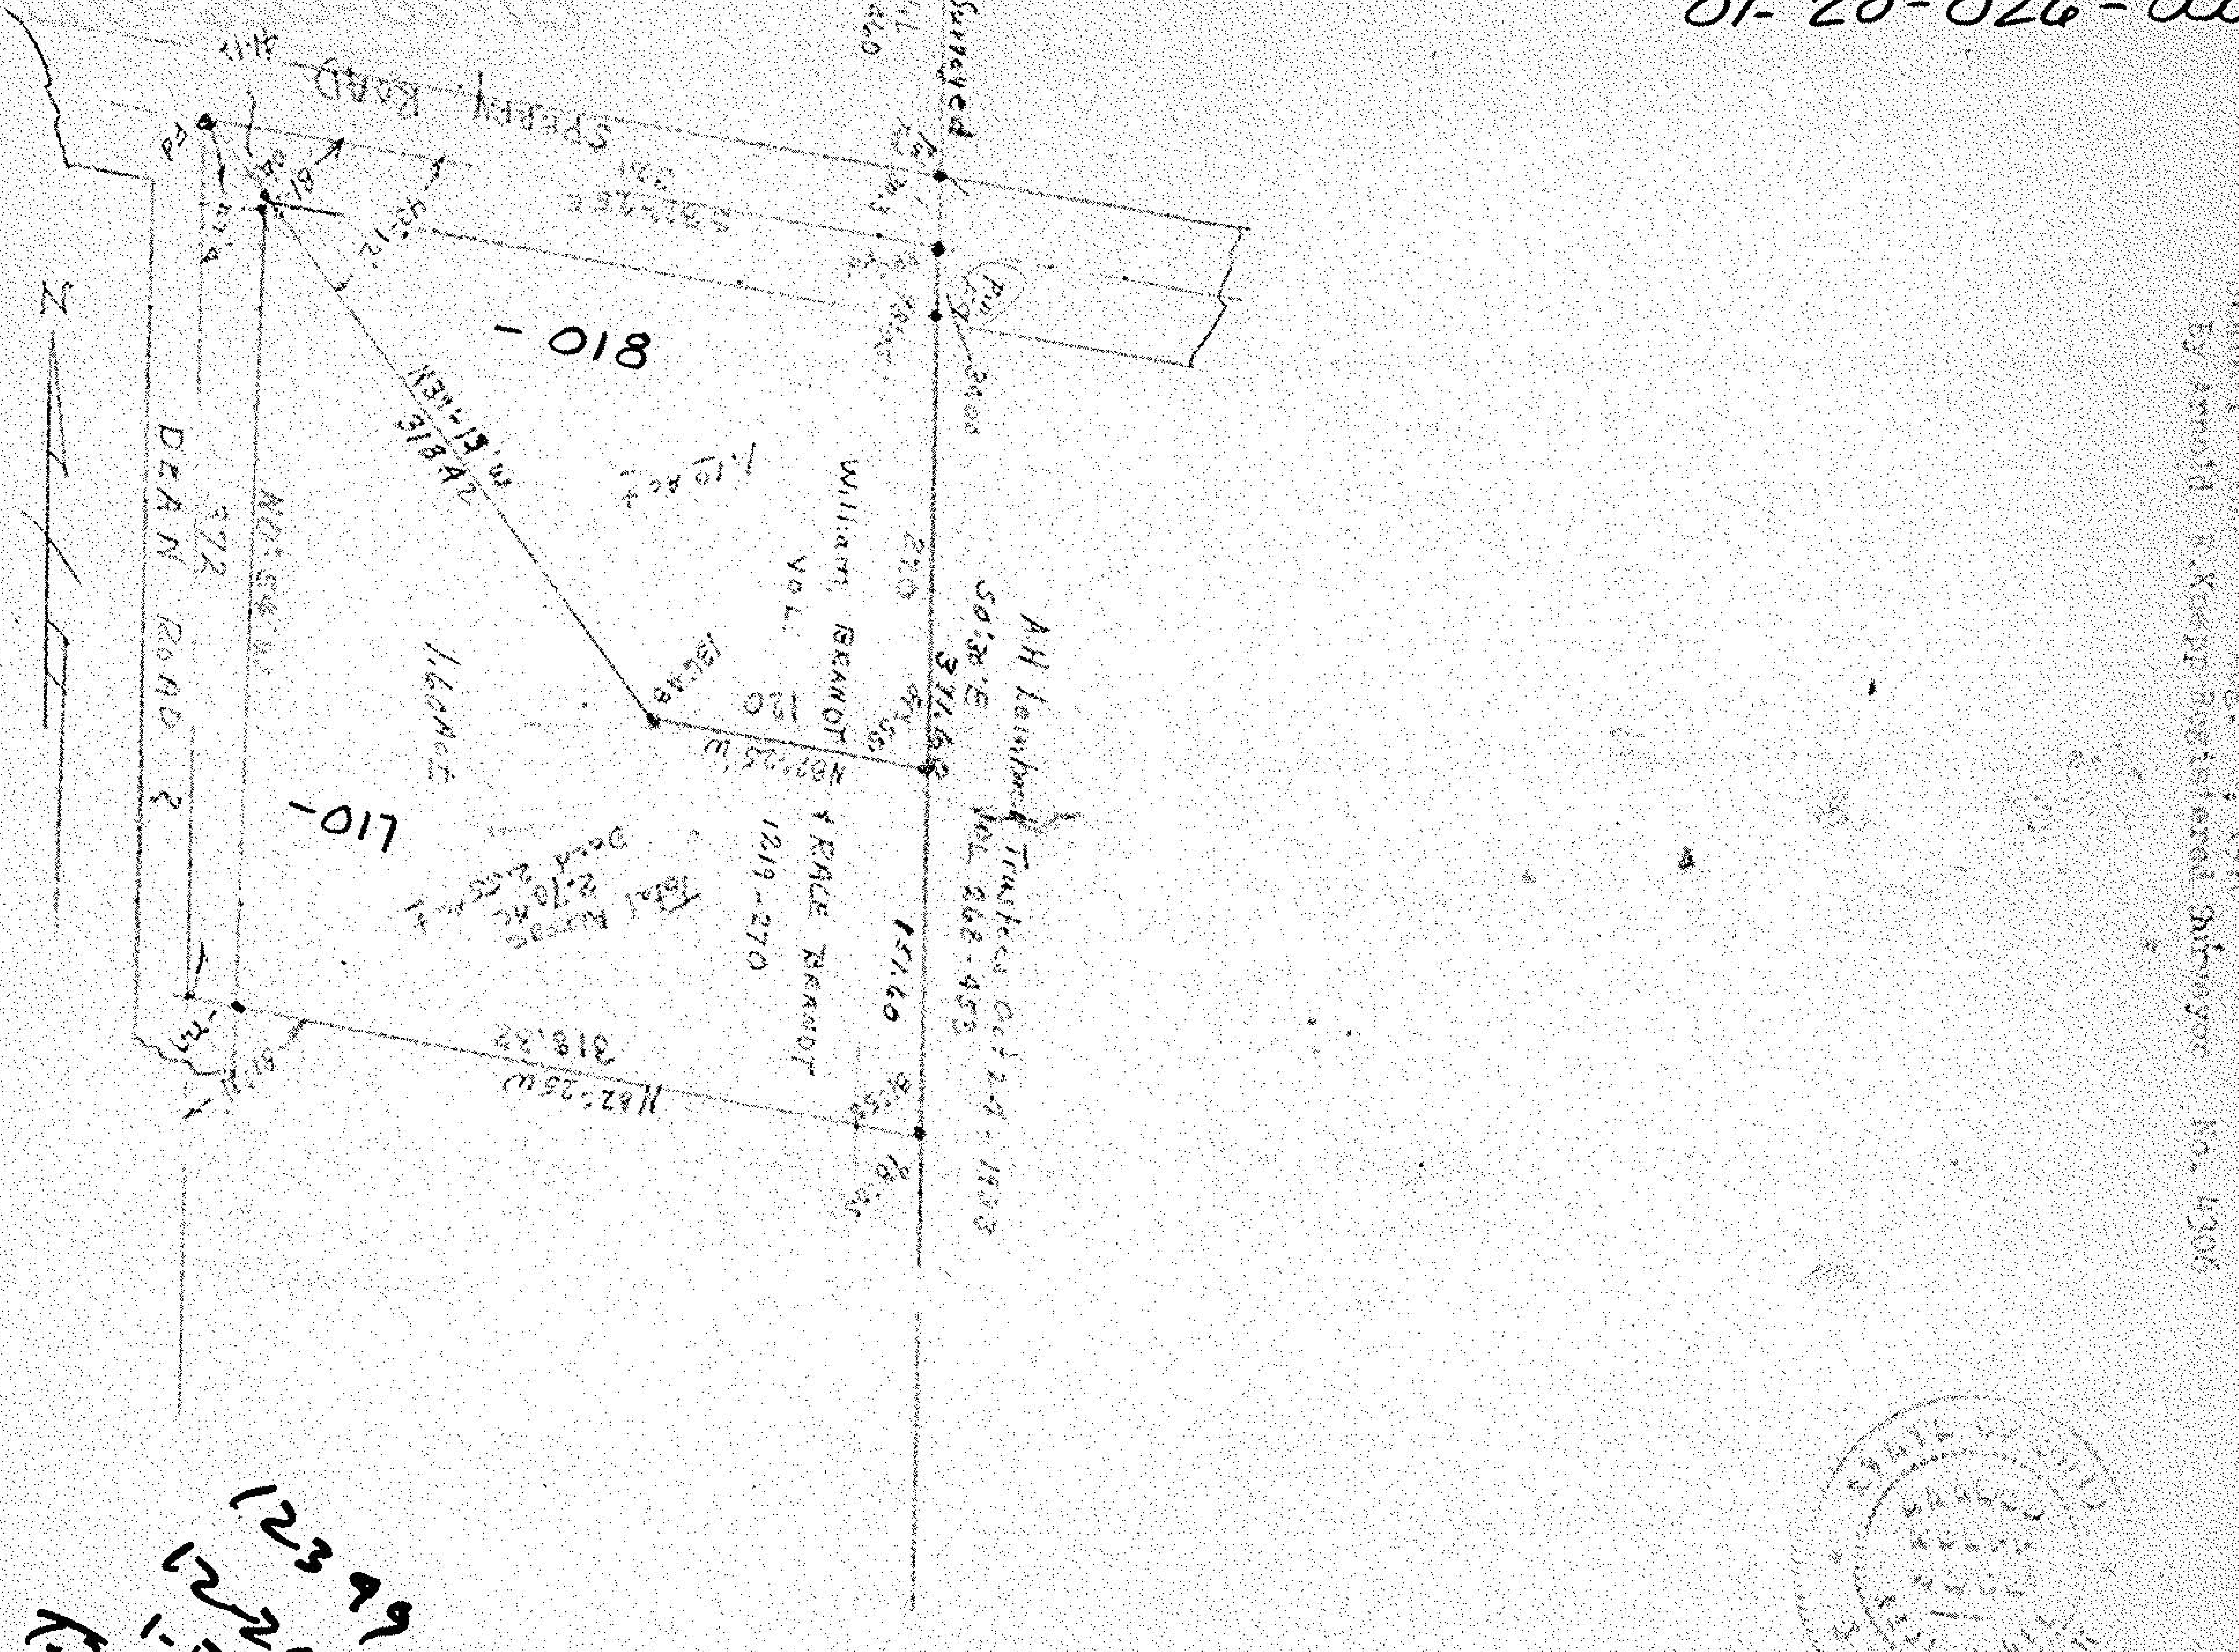

12399

12-26-78

1-B.