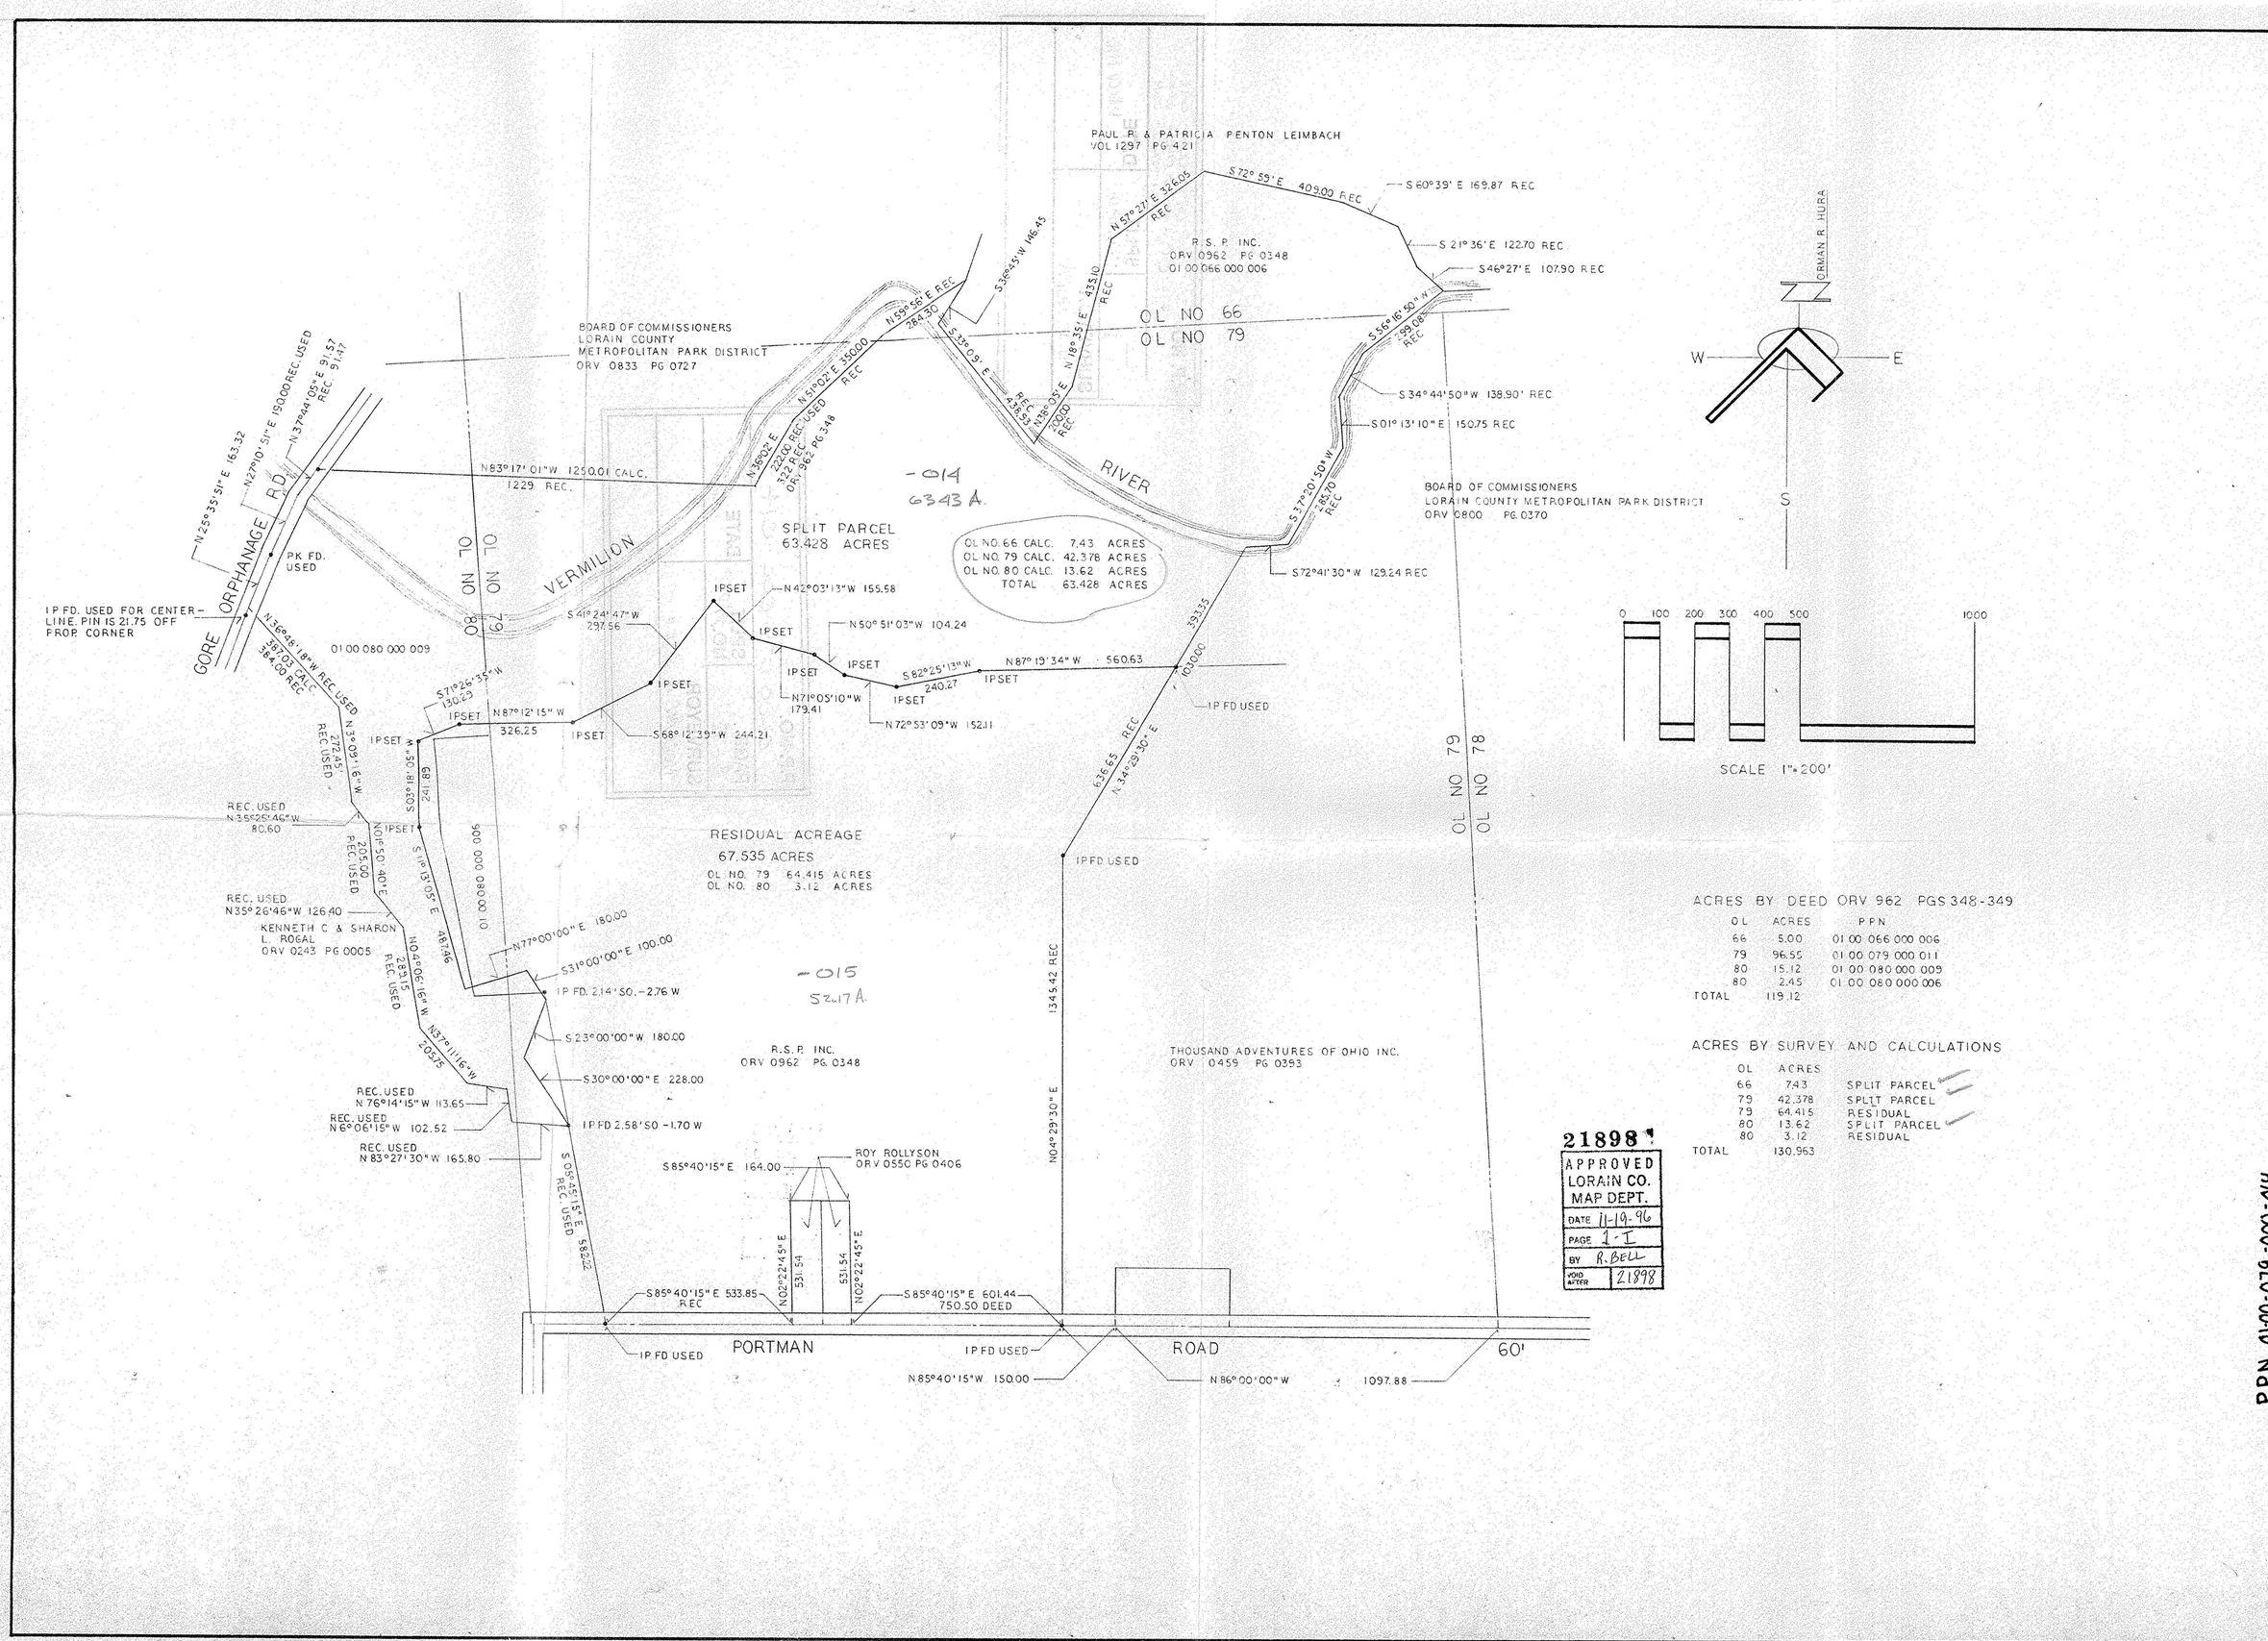

ACRES BY DEED ORV 962 PGS 348-349

OL	ACRES	PPN
66	5.00	01 00 066 000 006
79	96.55	01 00 079 000 011
80	15.12	01 00 080 000 009
80	2.45	01 00 080 000 006
TOTAL	119.12	

ACRES BY SURVEY AND CALCULATIONS

OL	ACRES	
66	7.43	SPLIT PARCEL
79	42.378	SPLIT PARCEL
79	64.415	RESIDUAL
80	13.62	SPLIT PARCEL
80	3.12	RESIDUAL
TOTAL	130.963	

21898

APPROVED
LORAIN CO.
MAP DEPT.
DATE 11-19-96
PAGE 1-I
BY R. BELL
VOID AFTER 21898

STATE OF OHIO
N. R. HURA
S-5208
REGISTERED PROFESSIONAL SURVEYOR

BROWNHELM TOWNSHIP
LORAIN COUNTY OHIO
MARCH
1996

LOT SPLIT

PART OF
PPN 01 00 079 000 011
PPN 01 00 080 000 006
PPN 01 00 080 000 012

P.P.N. 01-00-079-000-014

LORAIN COUNTY METROPOLITAN PARK DISTRICT