#16712

01-00-077-000
-053

Map of Part of O.L. 77 Brownhelm Twp. Lorain Co. Ohio
Scale 1" 400' June 5, 1985
By Arnold F. Koepp Reg. Surveyor No. 4306

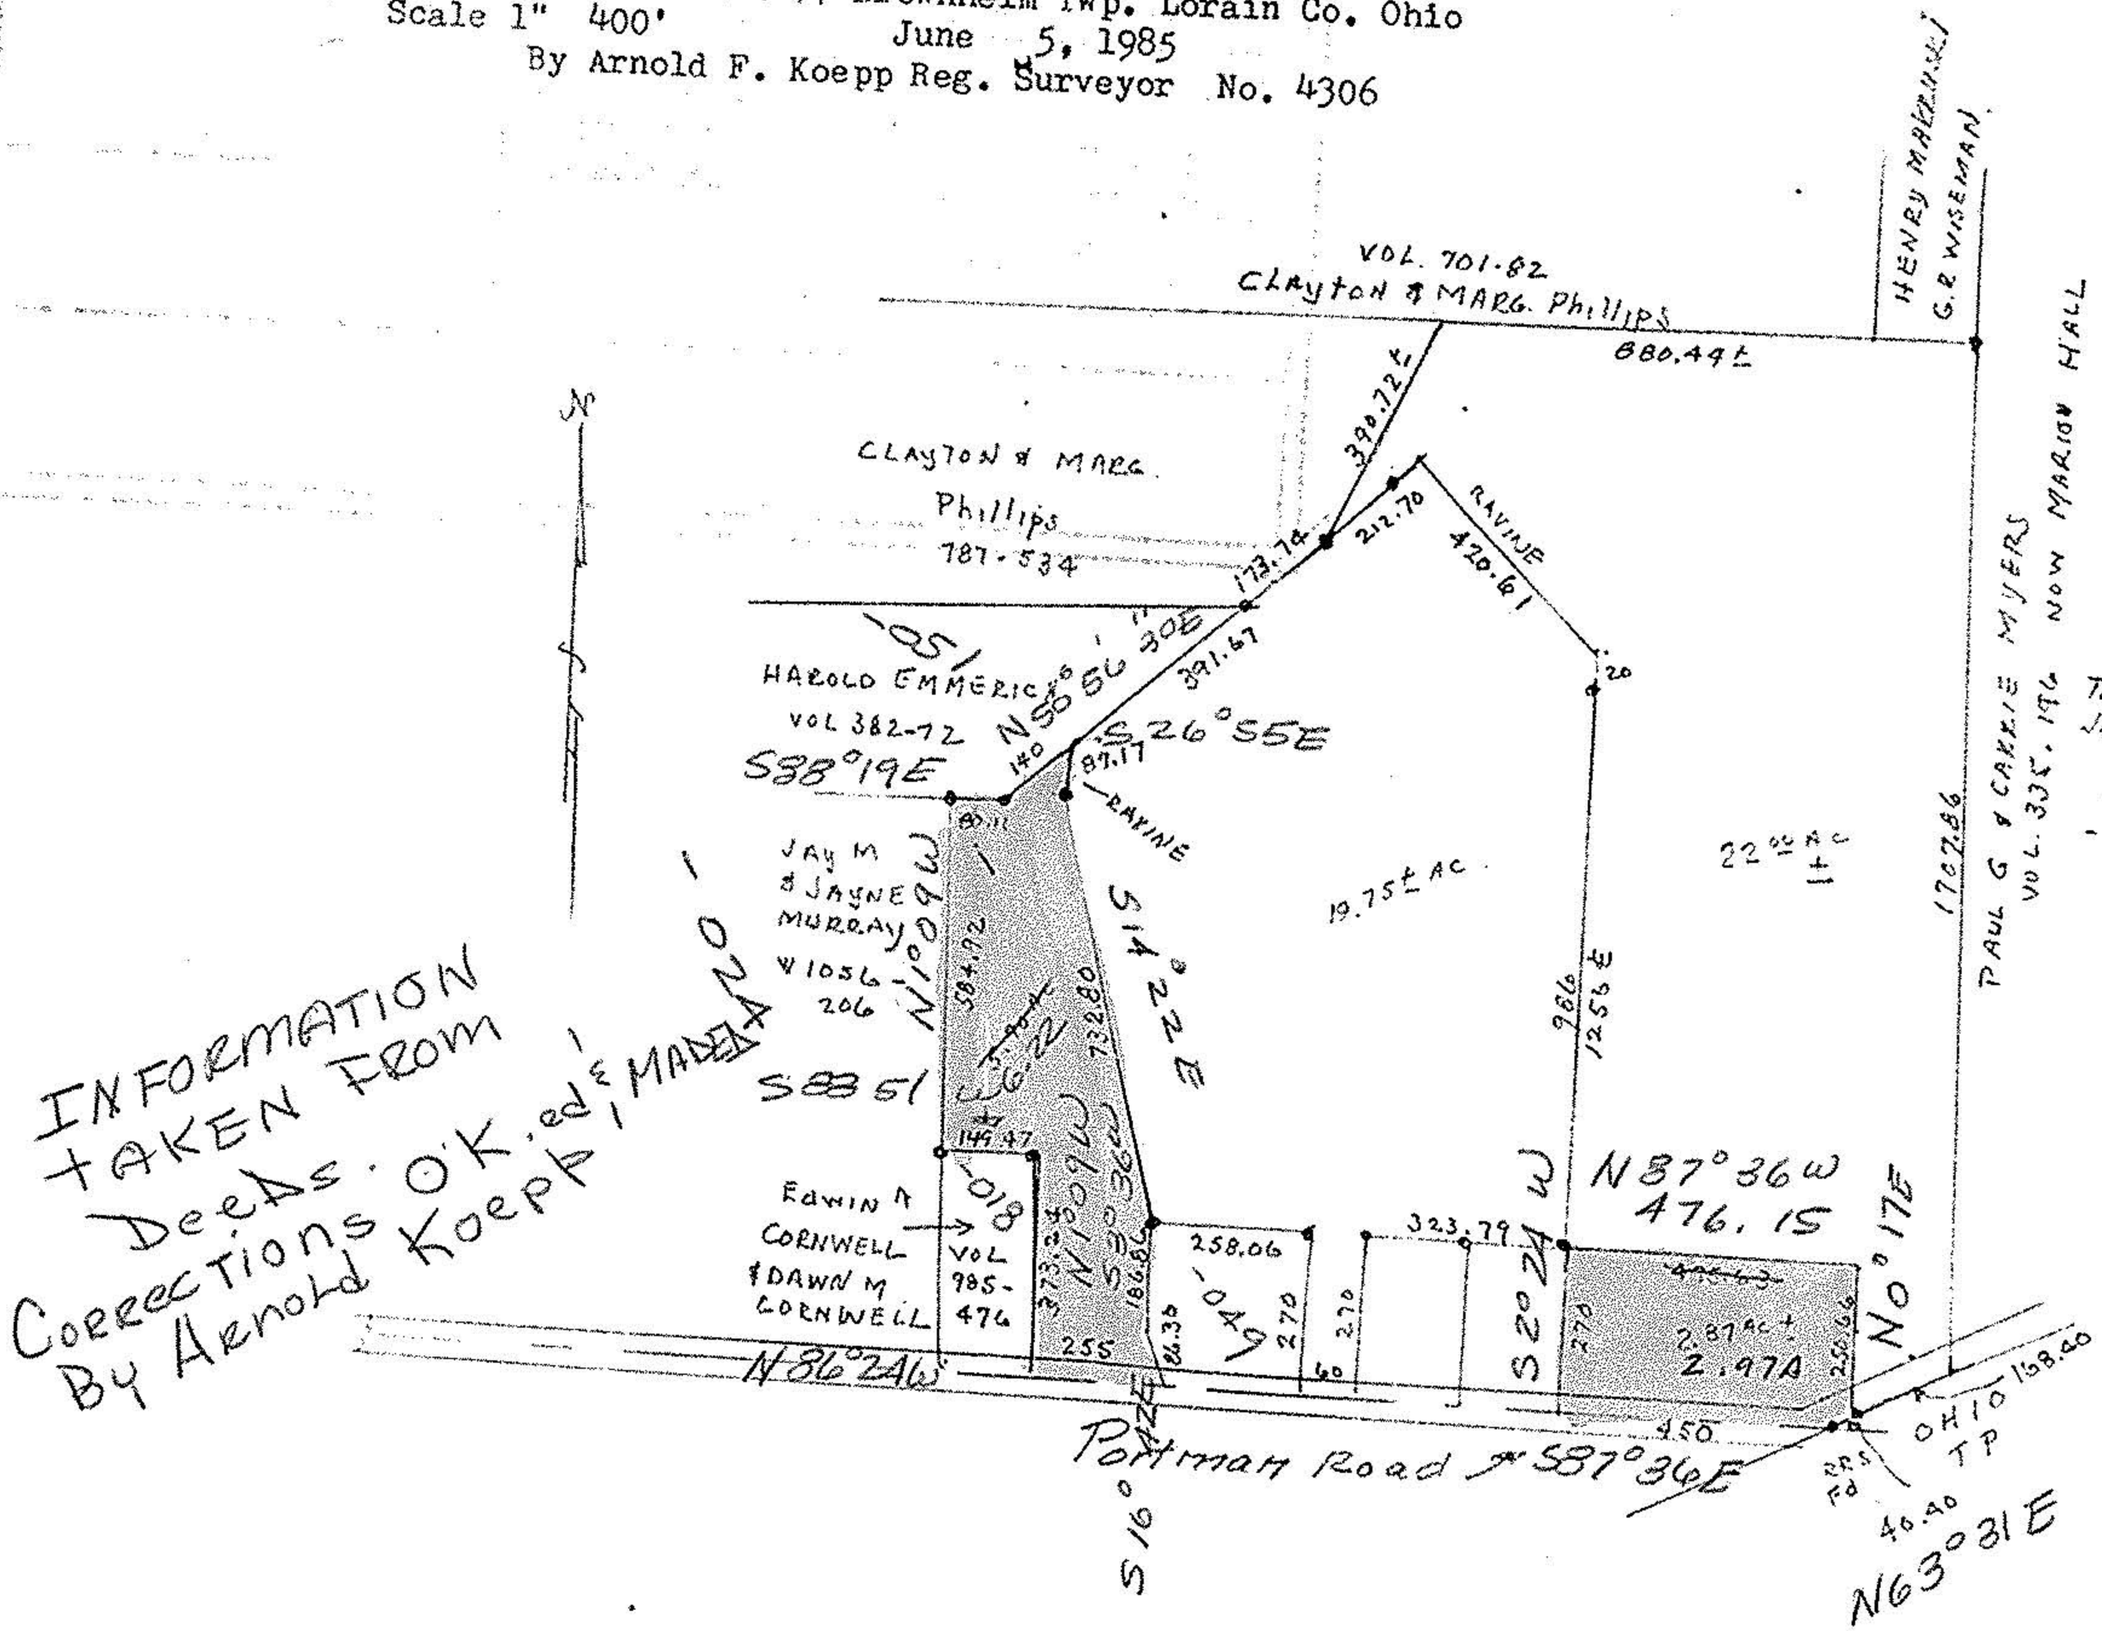

INFORMATION TAKEN FROM DEEDS. O'K, ed & MADE A CORRECTIONS BY ARNOLD KOEPP

Total Acreage June 1986

50.52

~~2.87~~ 2.97
19.75
~~6.90~~ 6.22

#16712

APPROVED
LORAIN CO.
MAP DEPT.
DATE 5-1-86
PAGE I-J
BY C. FRANCIS
VOID