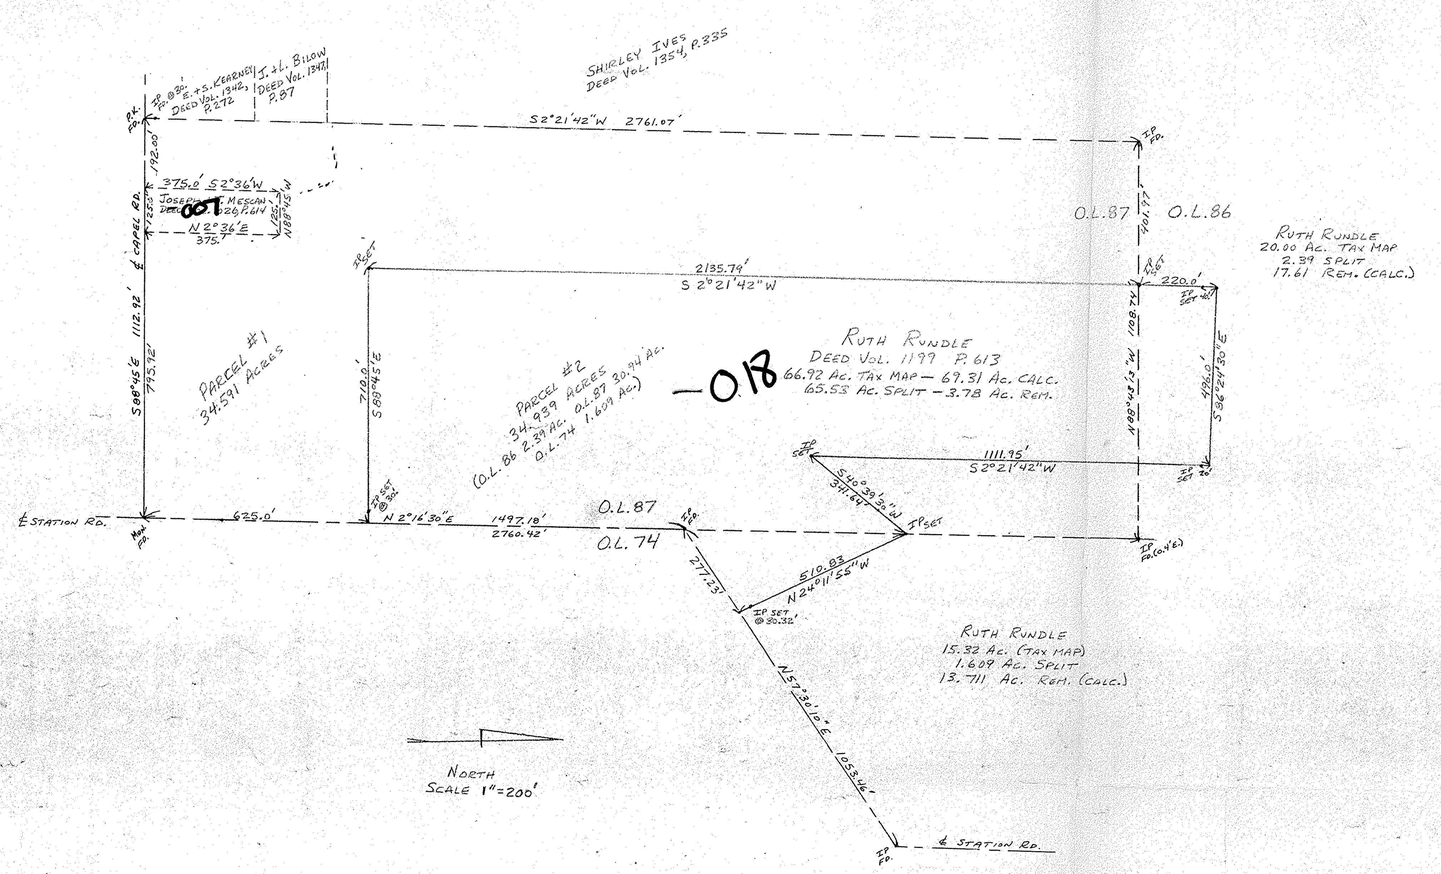

12-00-074-000
-086
-087

#17958

APPROVED
LORAIN CO.
MAP DEPT.
DATE 5-24-88
PAGE 12-E
BY CAROL FRANCIS
VOID AFTER 17958

STATE OF OHIO
JOHN R. HAMILTON
6861
REGISTERED
PROFESSIONAL SURVEYOR

SURVEY OF PART OF O.L. 74 86 87 OF COLUMBIA TOWNSHIP FOR JANET MESCAN

SCALE 1"=200'	APPROVED BY:	DRAWN BY JRH
DATE 1/88		REVISED

JOHN R. HAMILTON, REG. SURV. 6861

DRAWING NUMBER