


NEW PARCELS
AFTER SPLIT

601-200-10-20

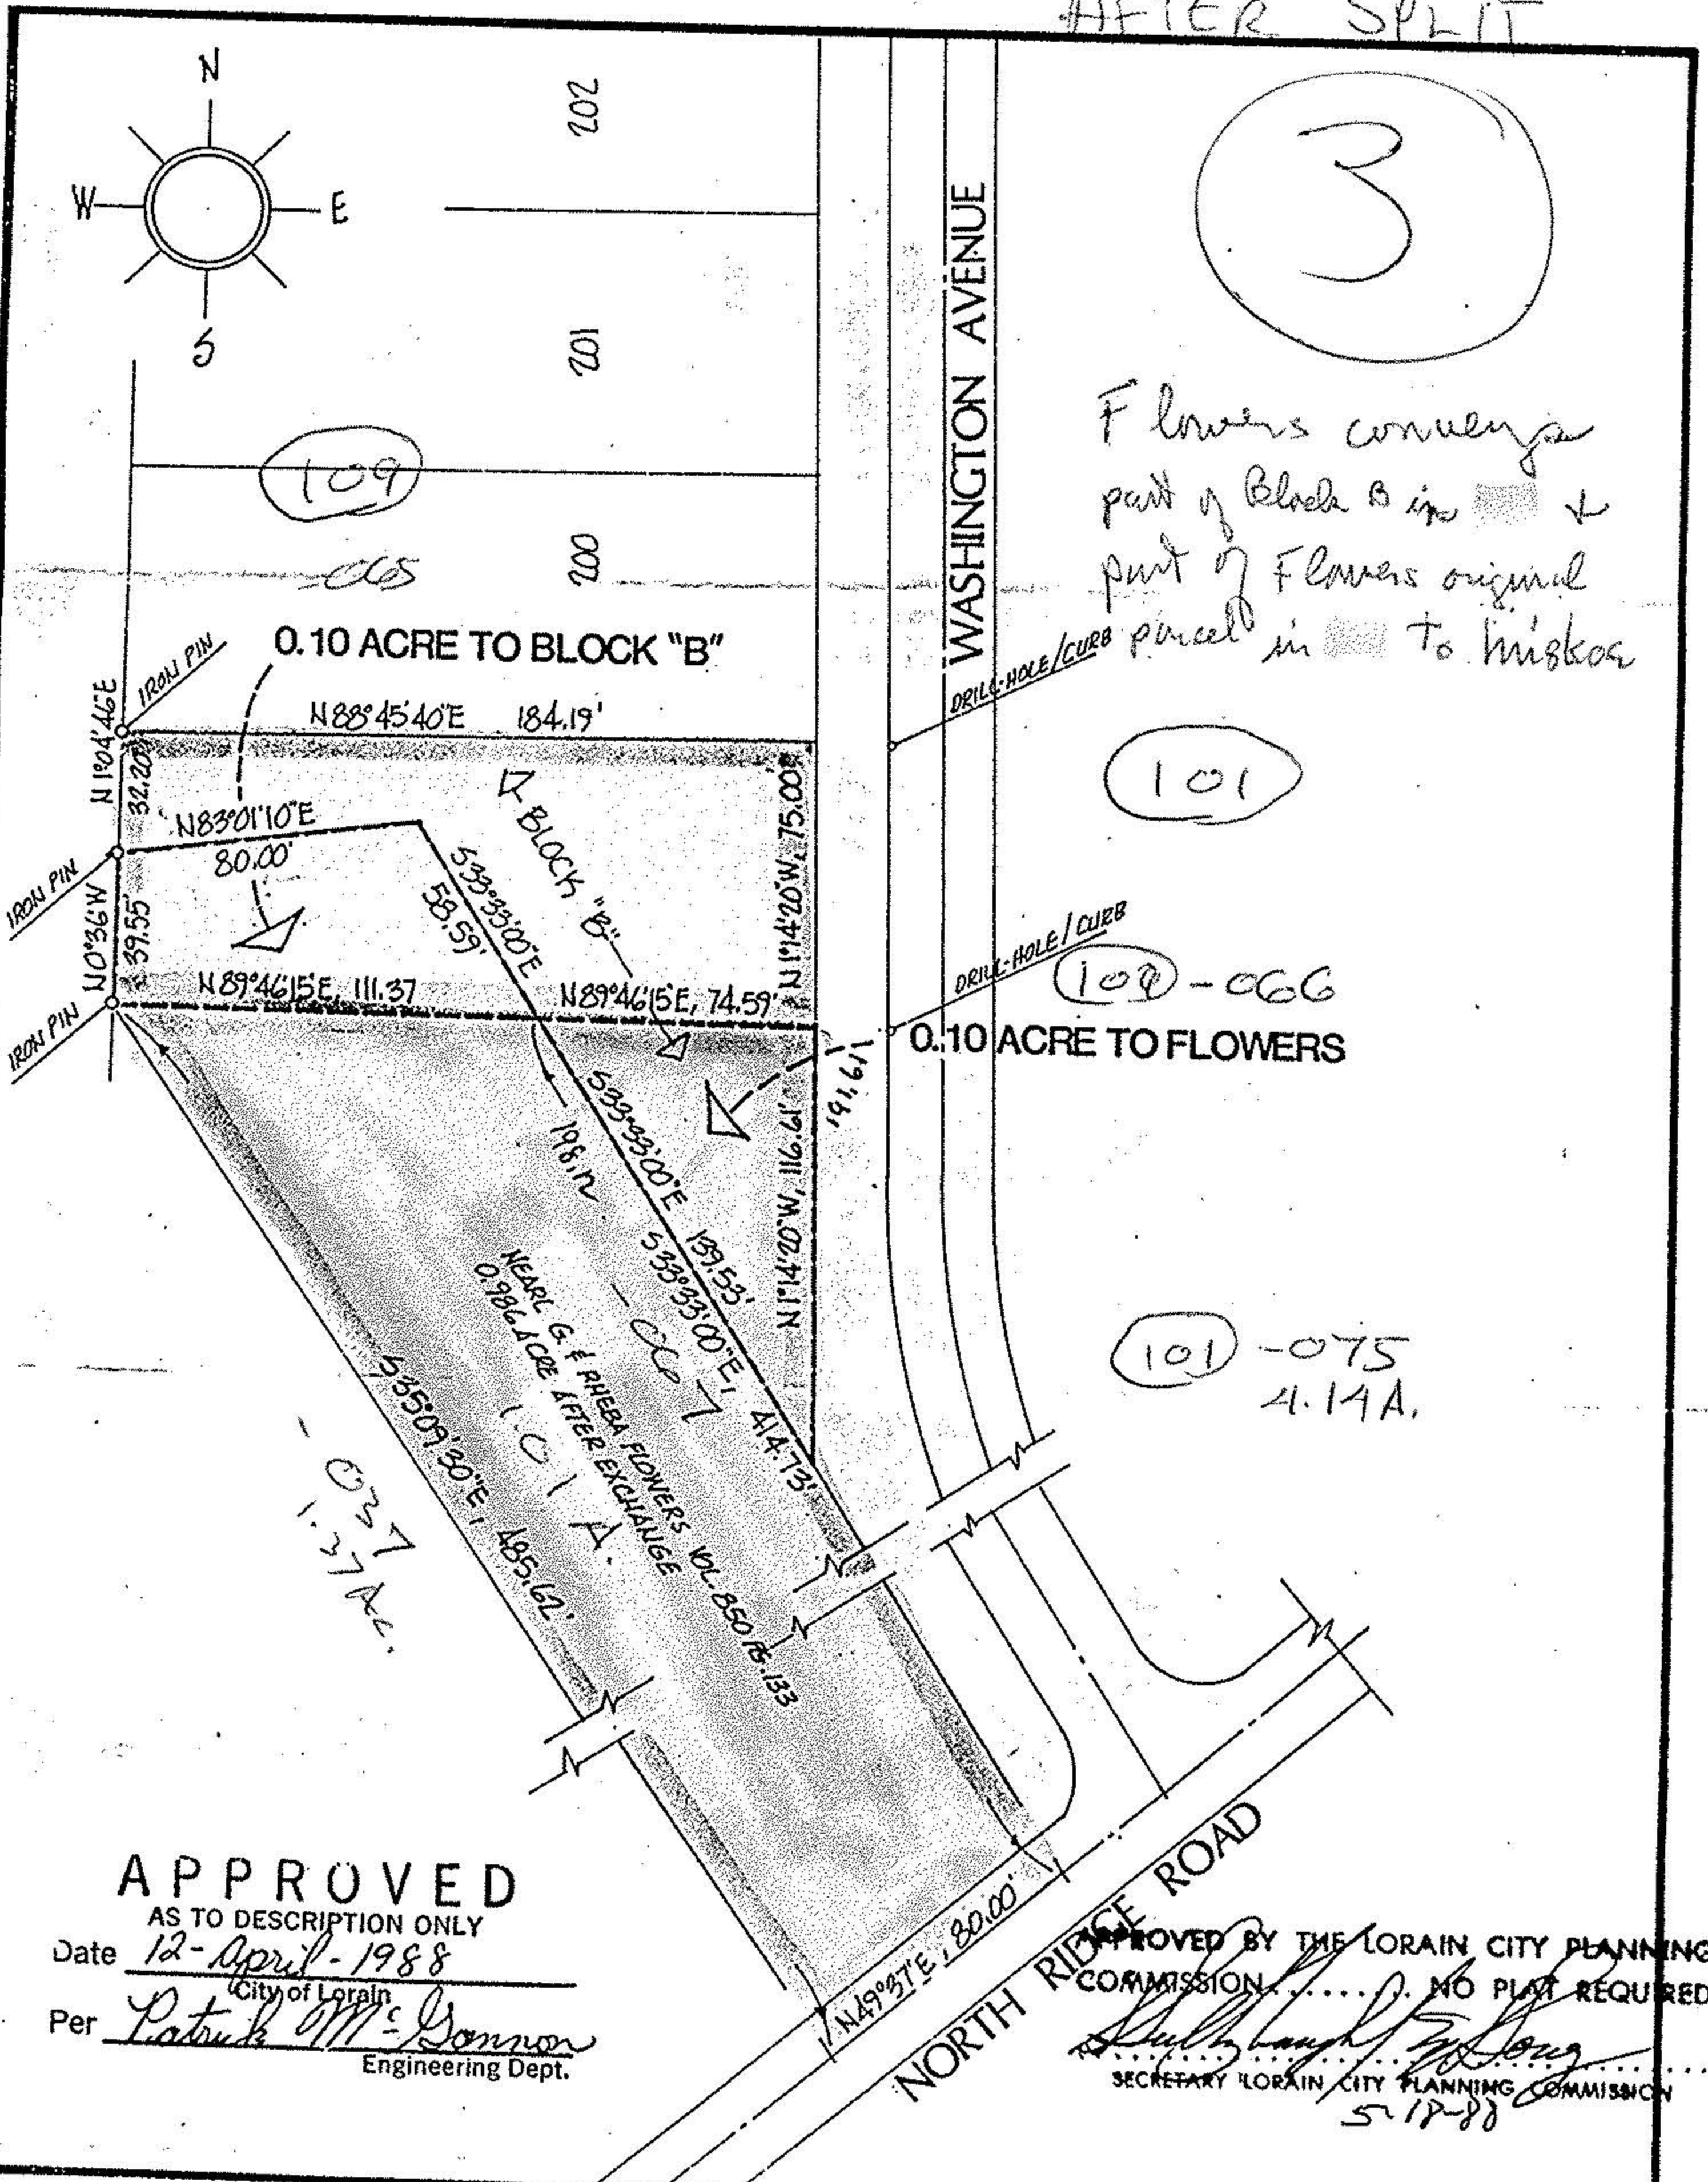

Flowers conveys
part of Block B in [] &
part of Flowers original
parcel in [] to Miskos

APPROVED

AS TO DESCRIPTION ONLY

Date 12-April-1988

City of Lorain

Per Patrick M. Donnon
Engineering Dept.

APPROVED BY THE LORAIN CITY PLANNING
COMMISSION. NO PLAT REQUIRED

[Signature]
SECRETARY LORAIN CITY PLANNING COMMISSION
5-17-88

ACREAGE	MISC.
DATE	1-22-88
DRAWN	MGH
SCALE	1" = 60 ft.

PREPARED FOR DAVID S. TOWNER INC. / FLOWERS

MICHAEL G. HURA, registered surveyor.
12706 MASON RD., VERMILION, O., Ph(216) 965 4040

PARCEL SPLIT APPROVAL

SUBLOT(s) BLOCK "B" of HICKORY HILL SUBD'N #7
Volume 41 Page 2 of PLATS
PART OF O.L. 7 TRACT 1 SECTION OF
BLACK RIVER TOWNSHIP LORAIN CO., OHIO
PERMANENT PARCEL NO.



CITY OF
LORAIN