PARENT PARCEL: 02-02-002-000-162

CHILD PARCEL: 02-02-002-000-163, -164

STARTING POINT: S/L 80 IN BEAVER CREEK ESTATES SUBD. NO. 4

NO. 01454

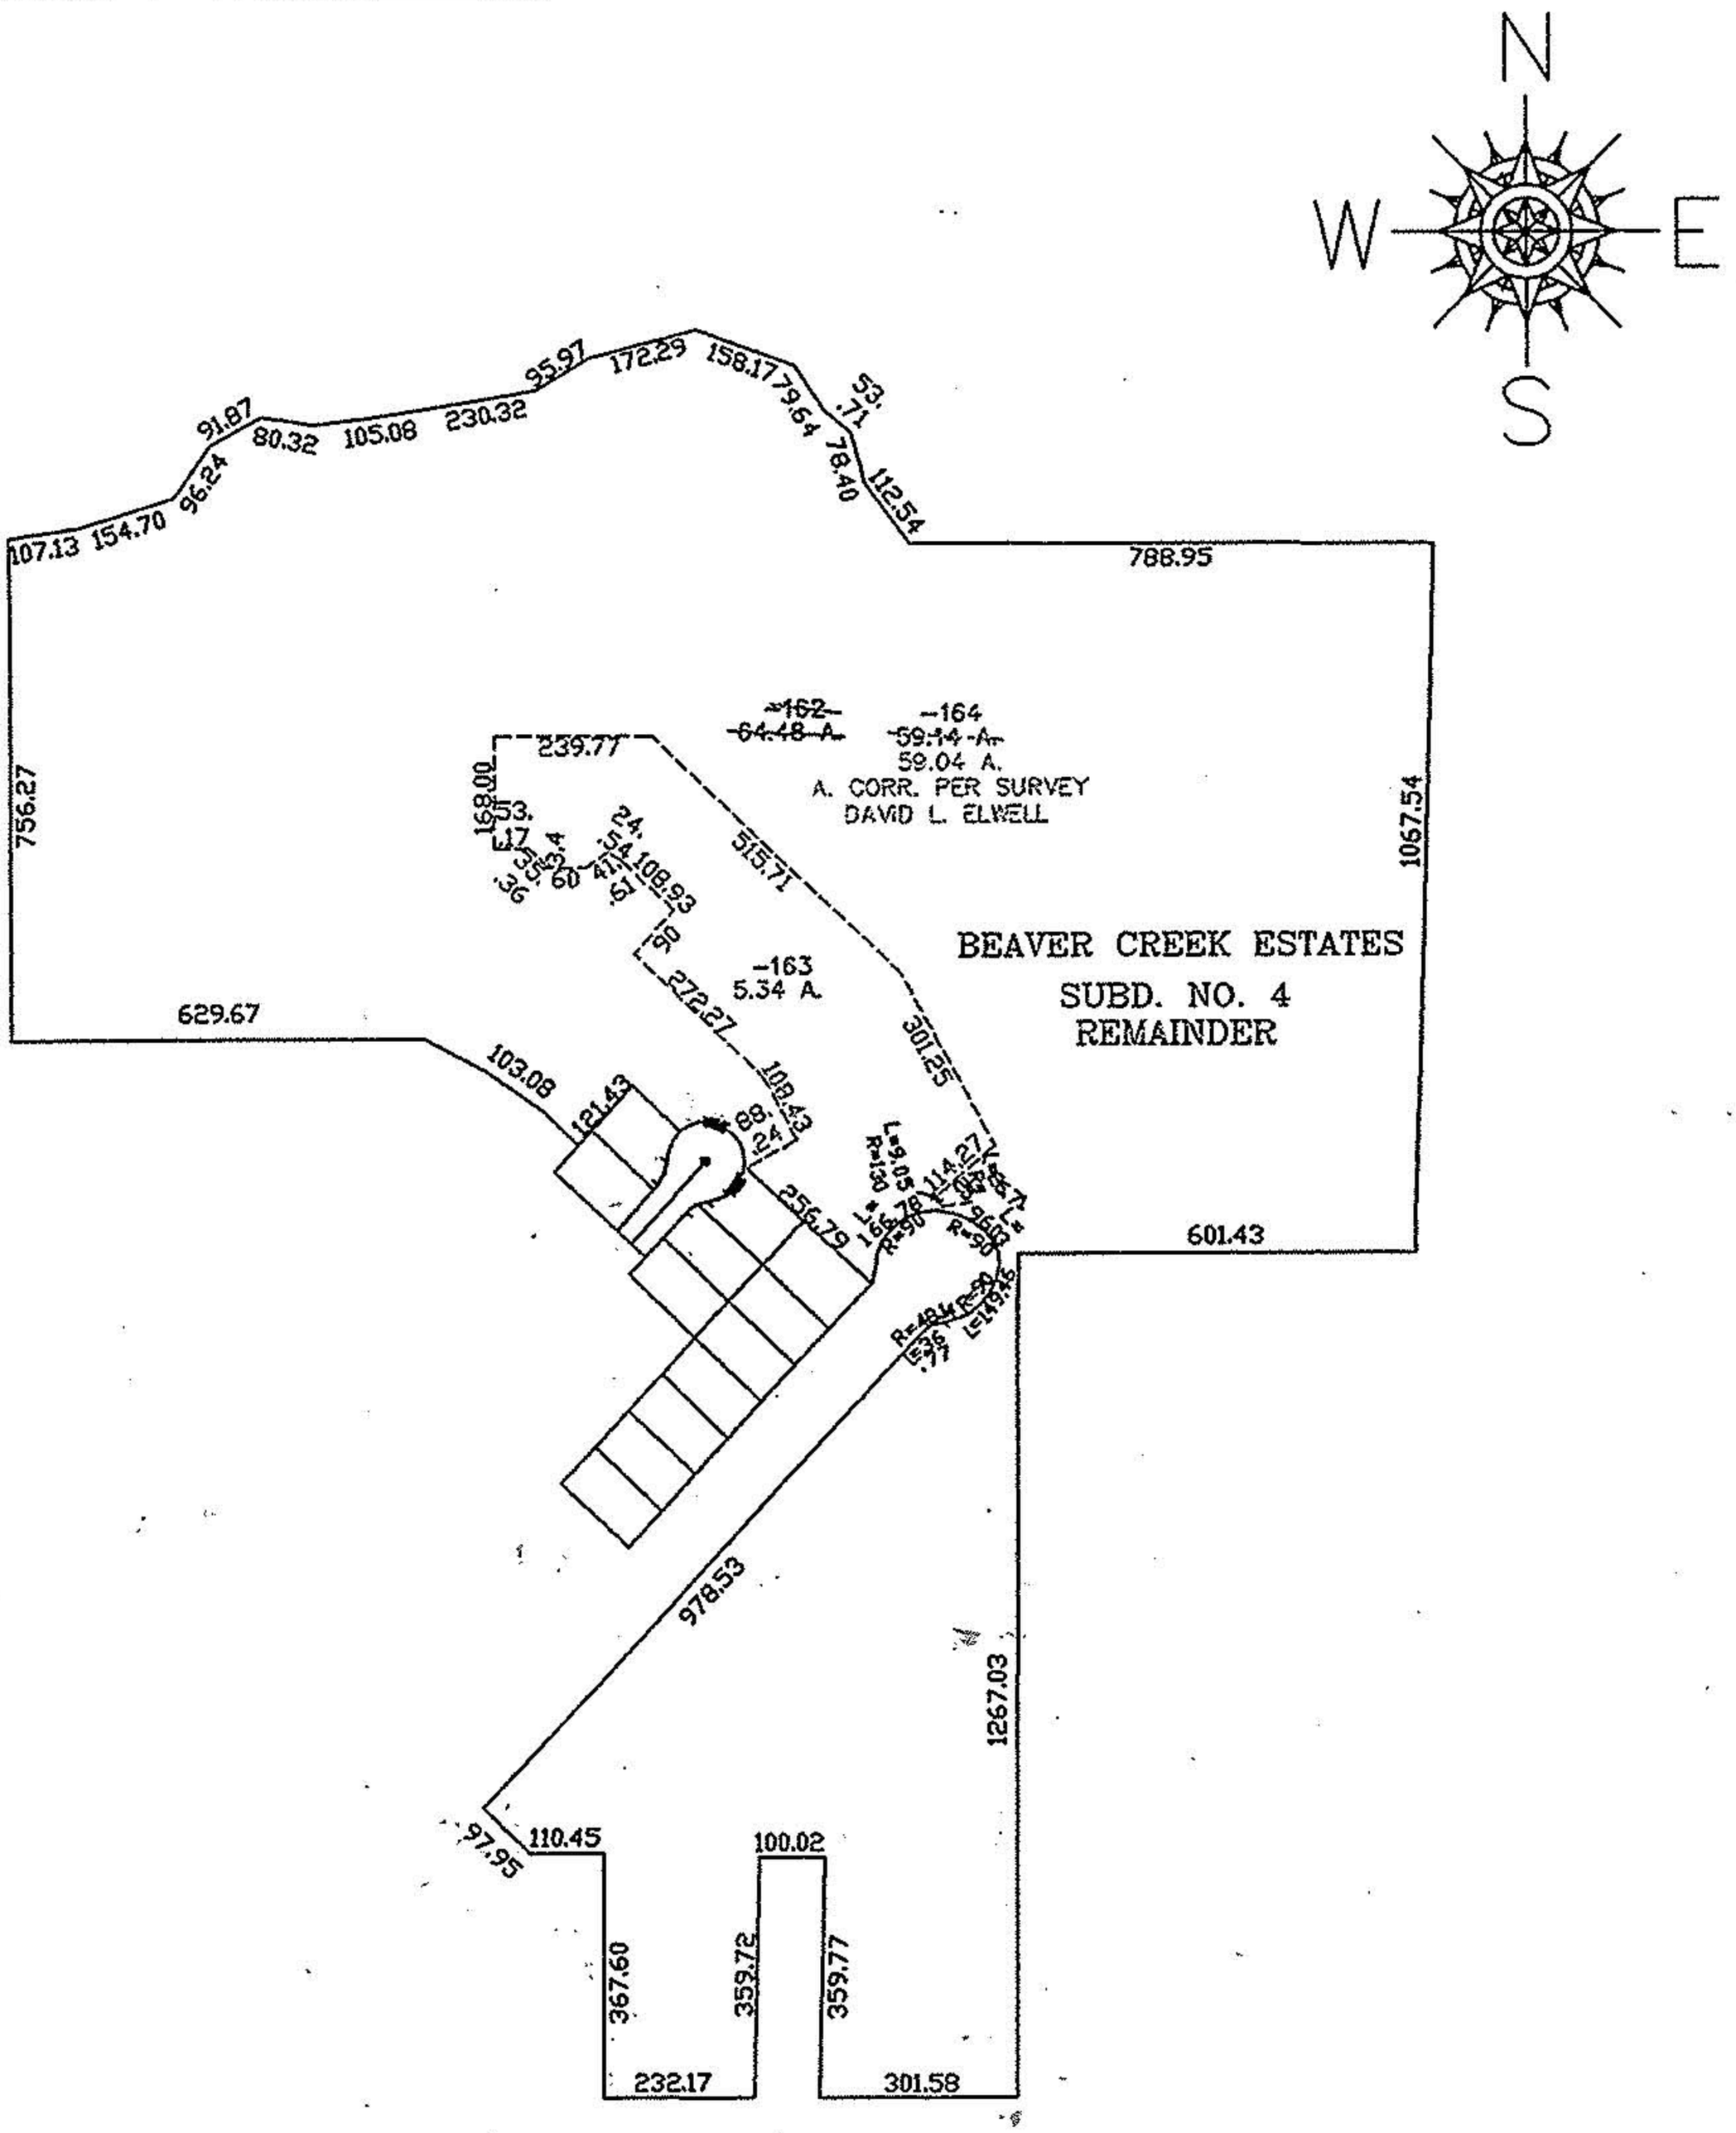

SPLITS/DEEDS PROCESSED

LORAIN COUNTY TAX MAP DEPARTMENT

226 MIDDLE AVE. ELYRIA, OHIO

SURVEYED BY: DAVID L. ELWELL

CLOSURE: 0.00 : 10,000

MAP PAGE(S): 02-02-002-A

APPROVED BY: JAH DATE: 9-9-03

SCALE: 1"= 400 PRIOR INSTRUMENT: PL VL 69/3 & 4