


LOT SPLIT FOR THE WALKER FAMILY

TOWNSHIP OF BROWNHELM,
LORAIN COUNTY, OHIO
PART OF ORIGINAL BROWNHELM
TOWNSHIP LOTS 65 AND 66

PROPERTY TO BE SPLIT IS
PPN 01-00-066-000-018
WALKER, VOLUME 608, PAGE 824

01-00-066-000-011

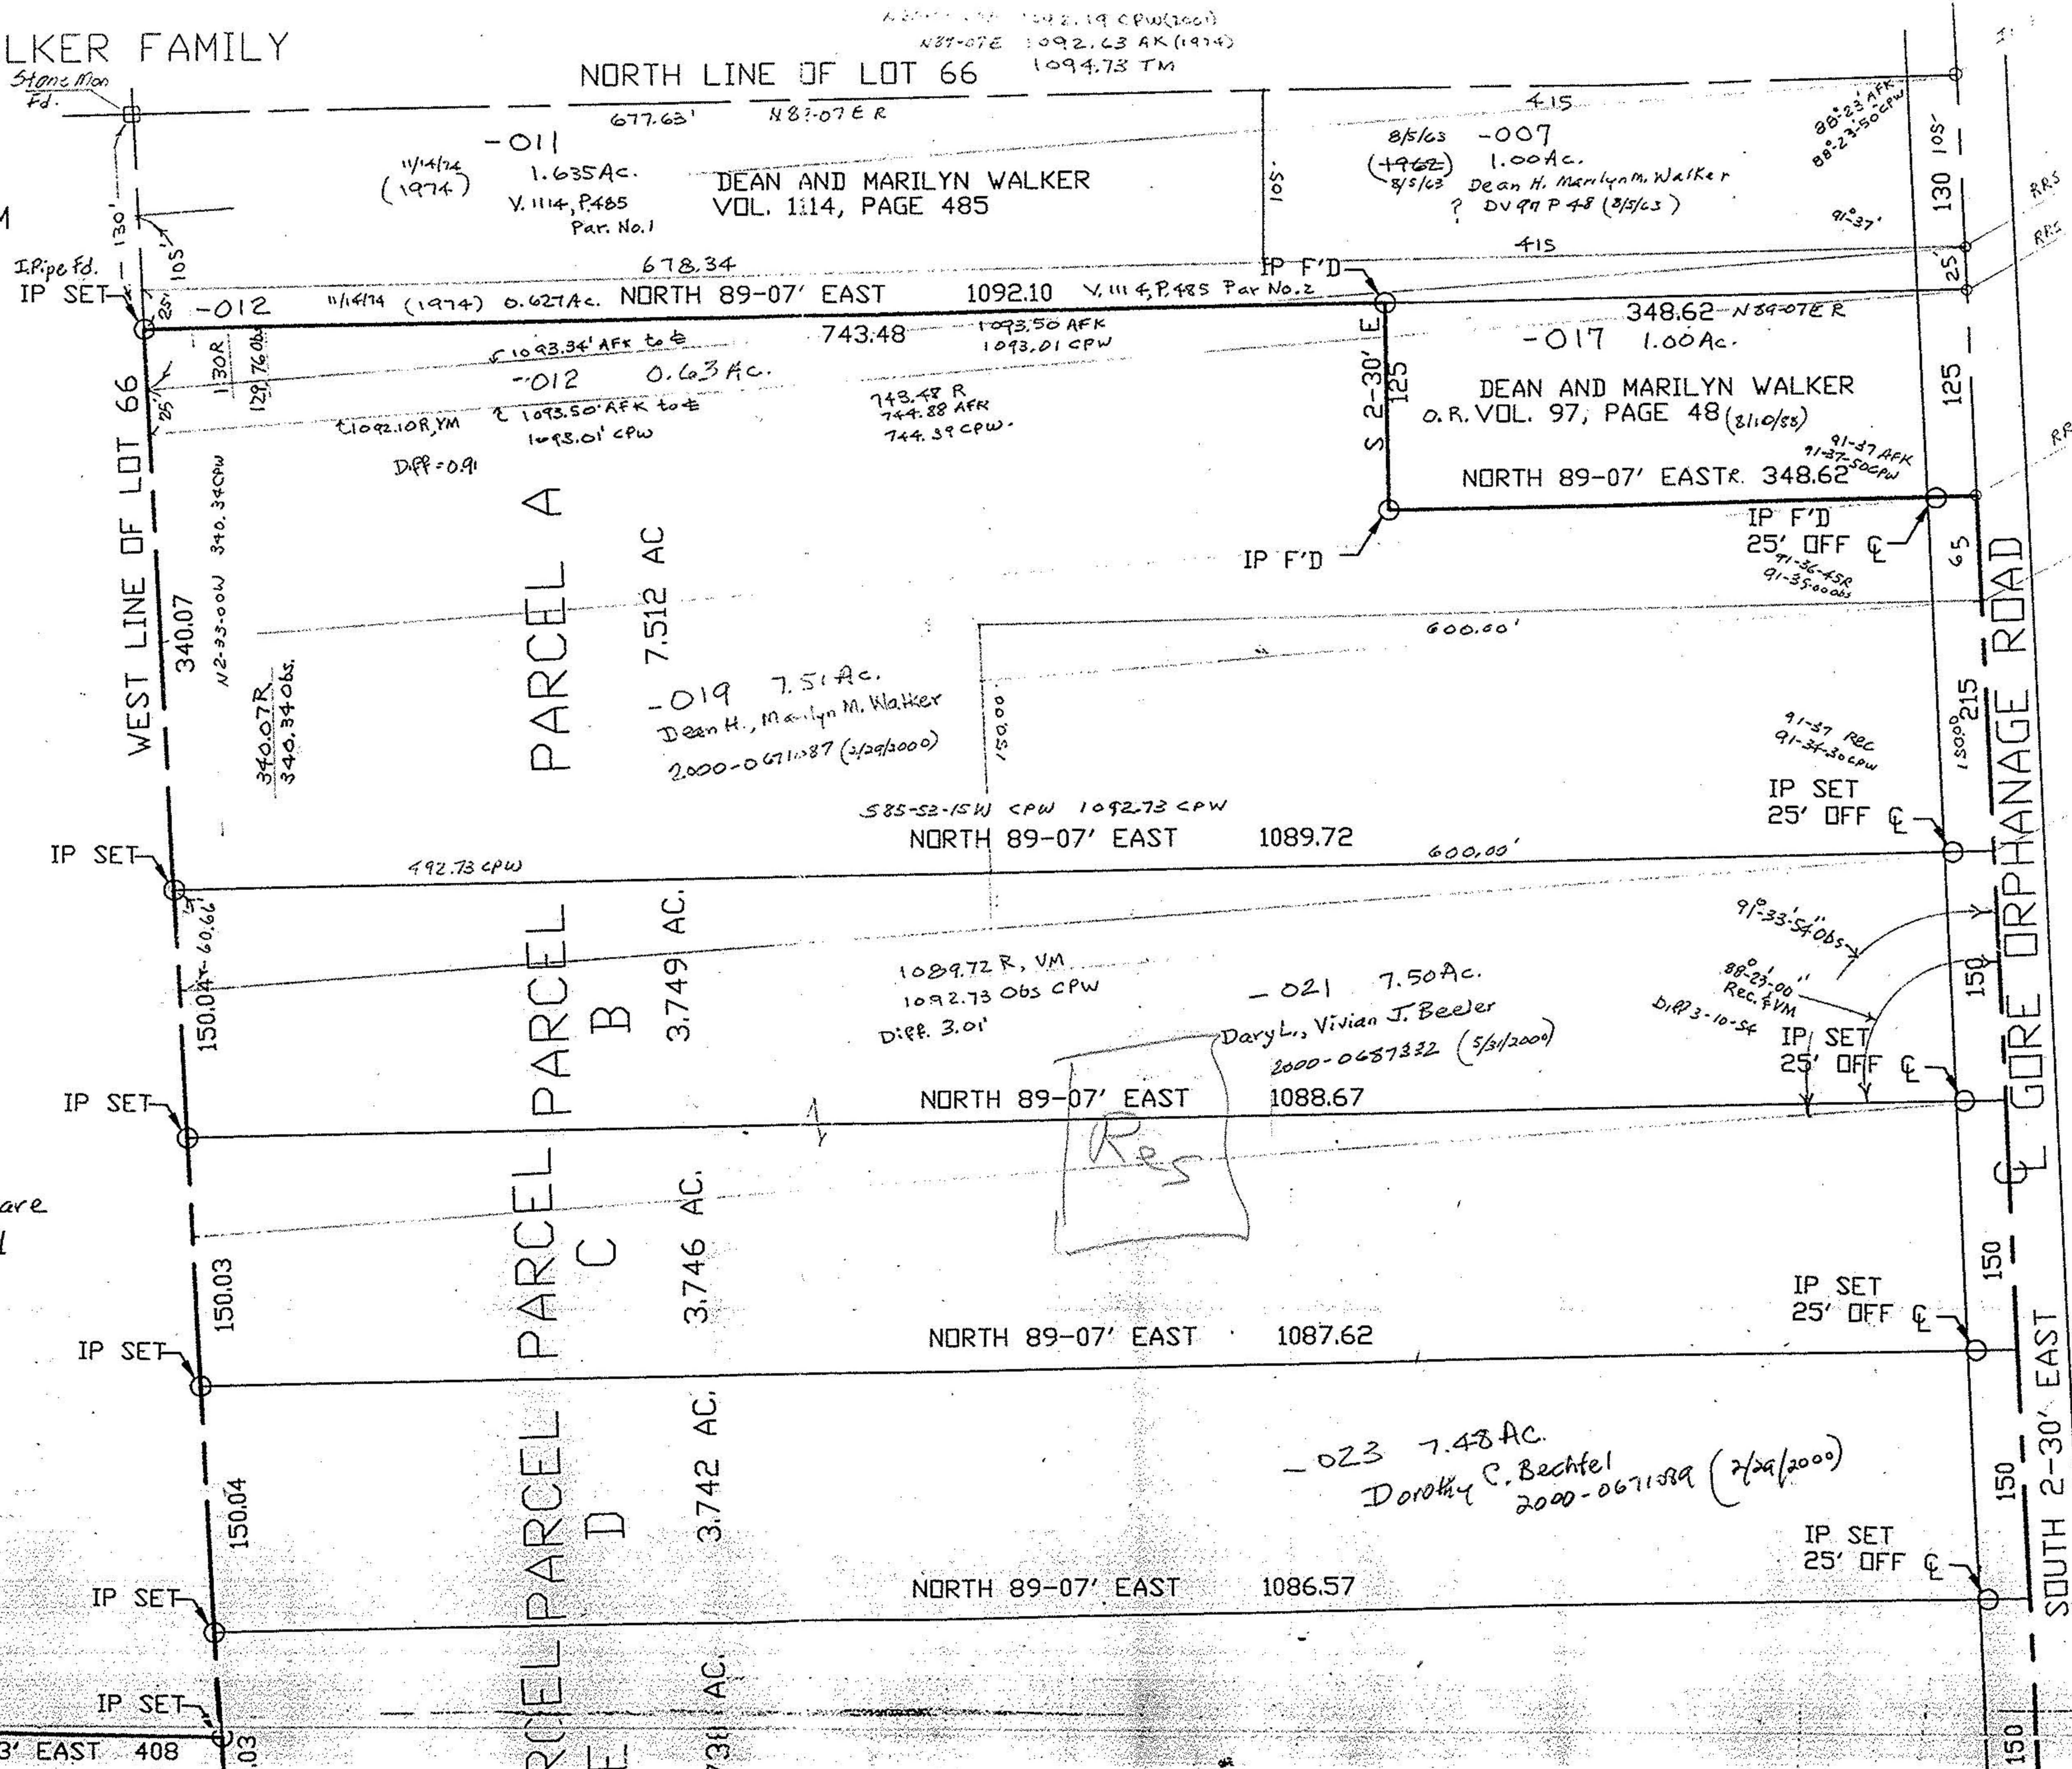

NOTE: These pencil lines are
observed in the field

P. LEIMBACH PENTON
VOLUME 1407, PAGE 897

IP SET
N2-54' 10" SOUTH 89-03' EAST 408