SURVEY OF PP 21-13-000-000-018, PP 21-14-000-000-009 & 011

PREPARED BY: CARL R. ANDERSON P.S.
866 SALEM AVENUE
ELYRIA, OHIO 44035-4624
440-365-8104

PREPARED FOR: LARRY R. HASWELL

TOWNSHIP OF HUNTINGTON
COUNTY OF LORAIN
STATE OF OHIO
TRACT NUMBERS 13 AND 14

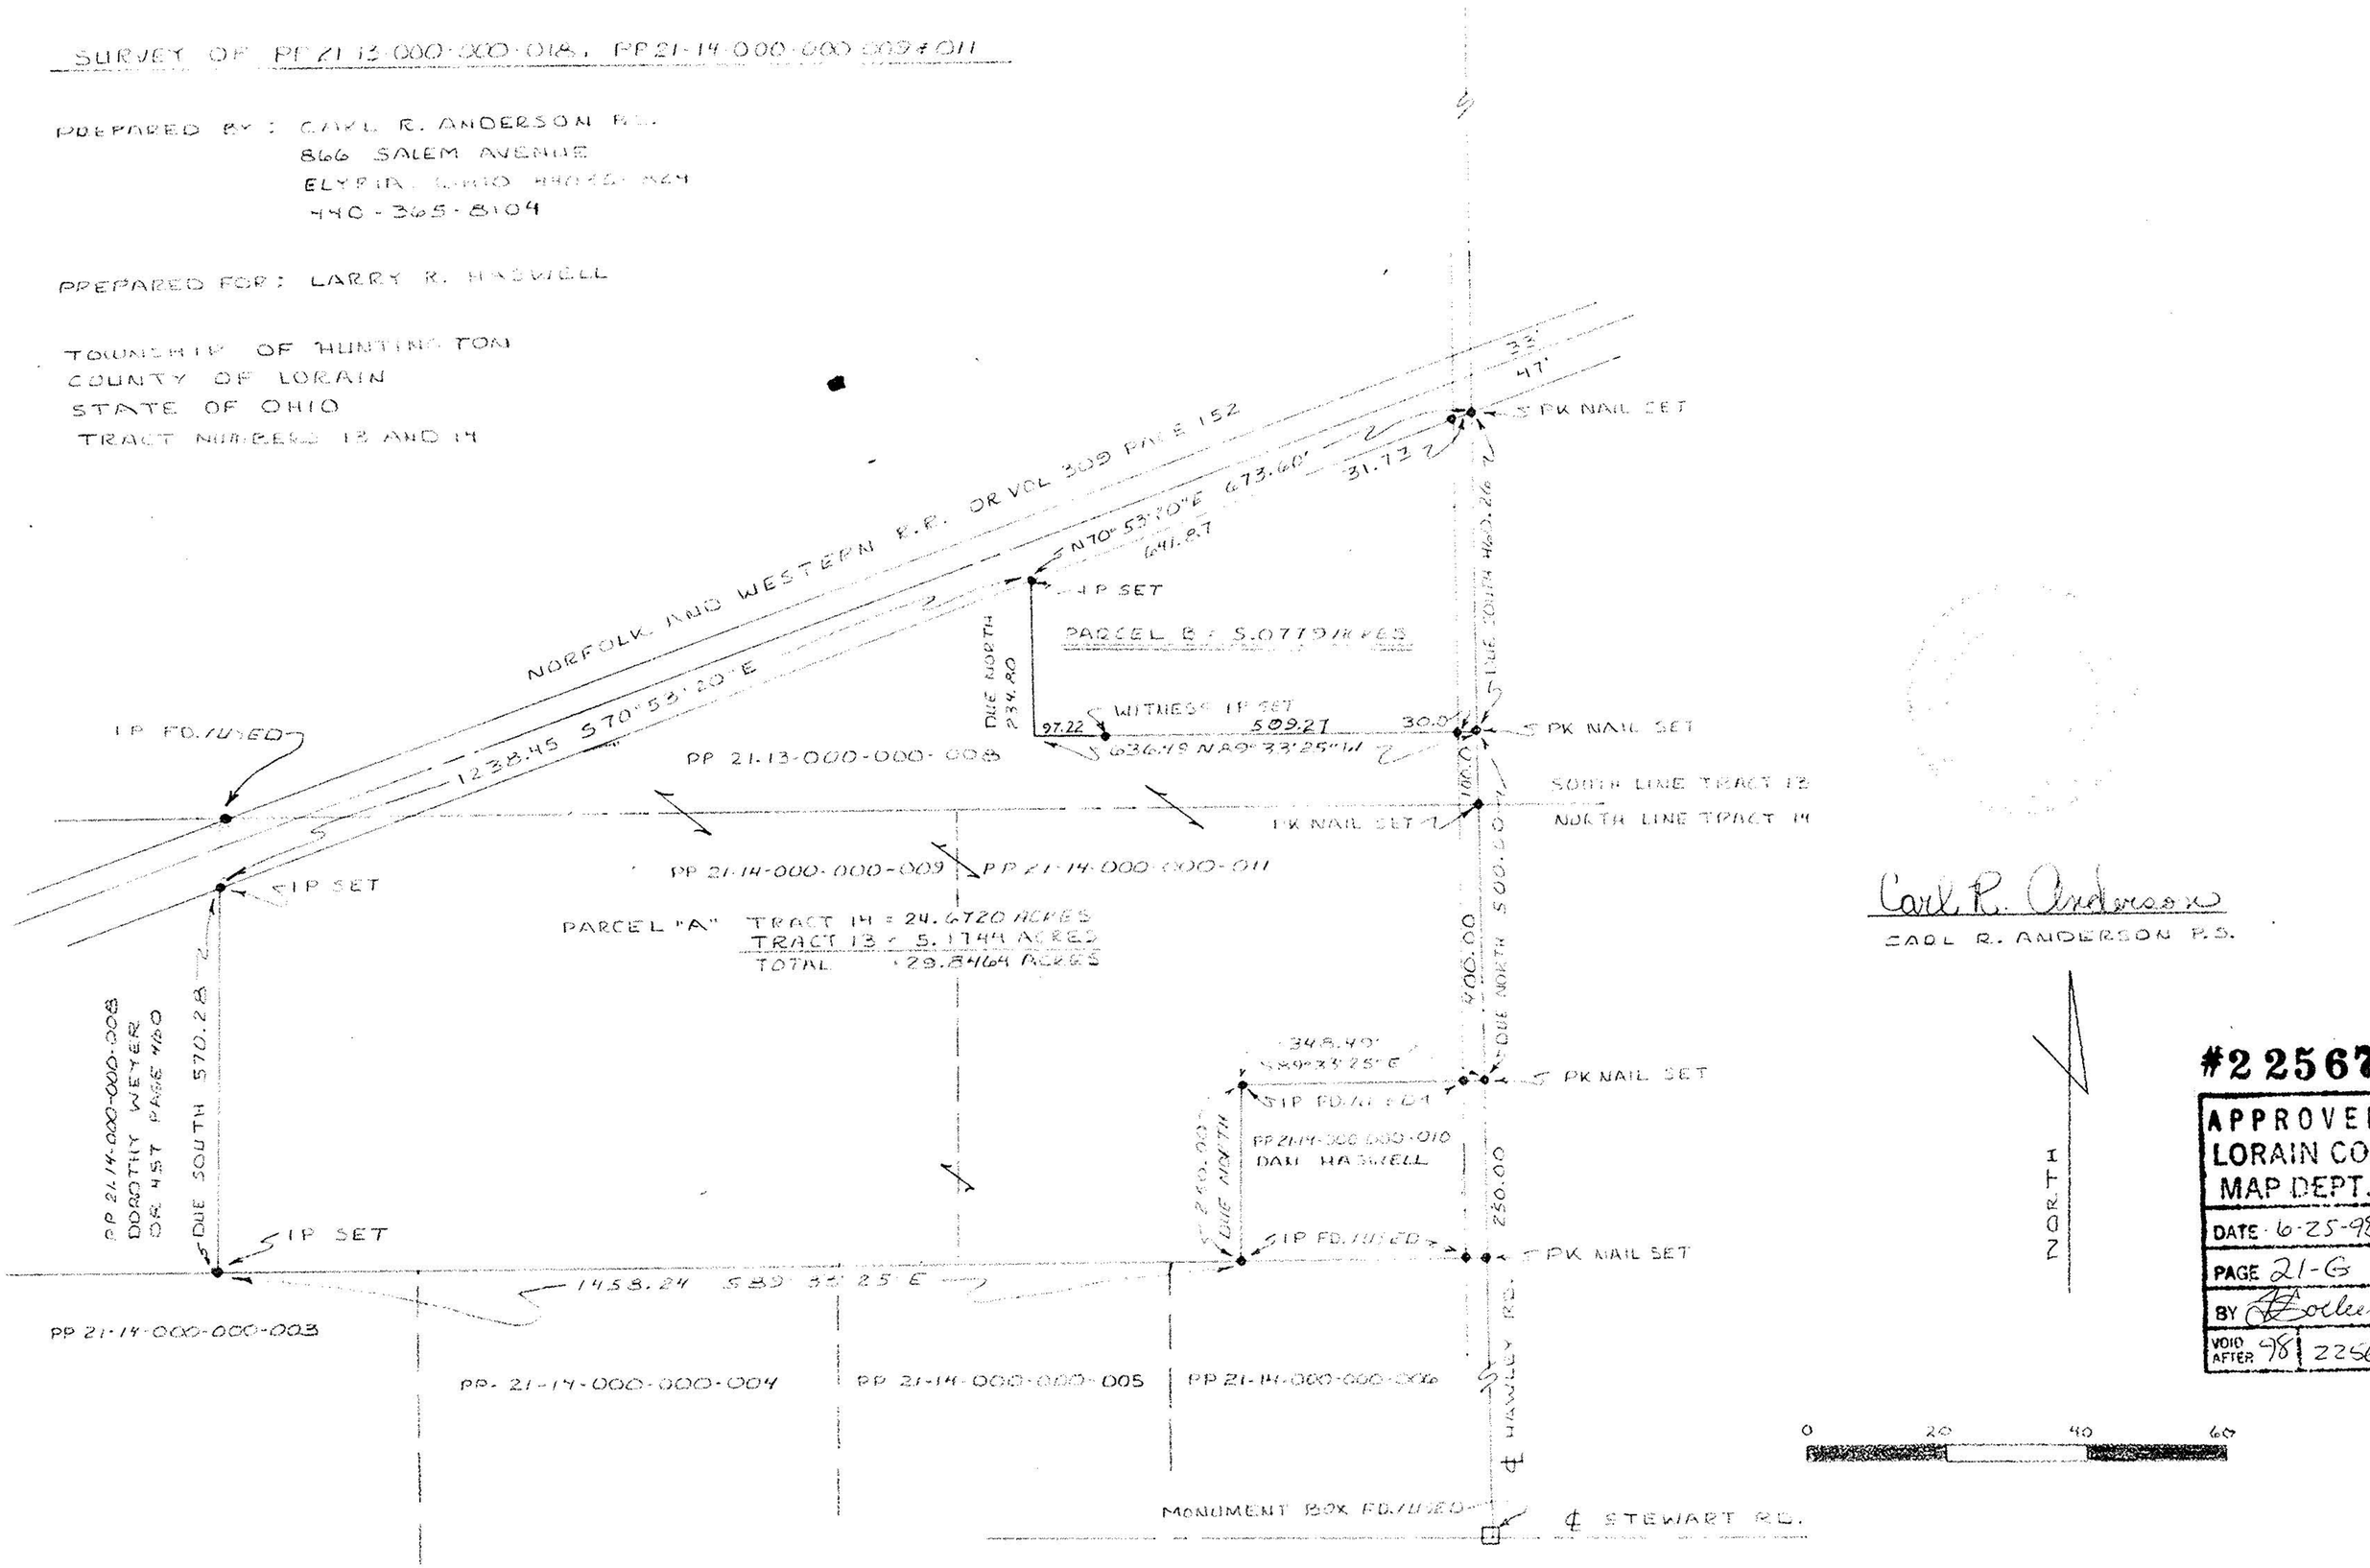

Carl R. Anderson

CARL R. ANDERSON P.S.

#22567

APPROVED
LORAIN CO.
MAP DEPT.
DATE 6-25-98
PAGE 21-G
BY
VOID AFTER 98 | 22567