No 01581

APPROVED LORAIN CO. MAP DEPT

DATE 2-3-04

PAGE 21-G

BY J Hatfield

#04-01581

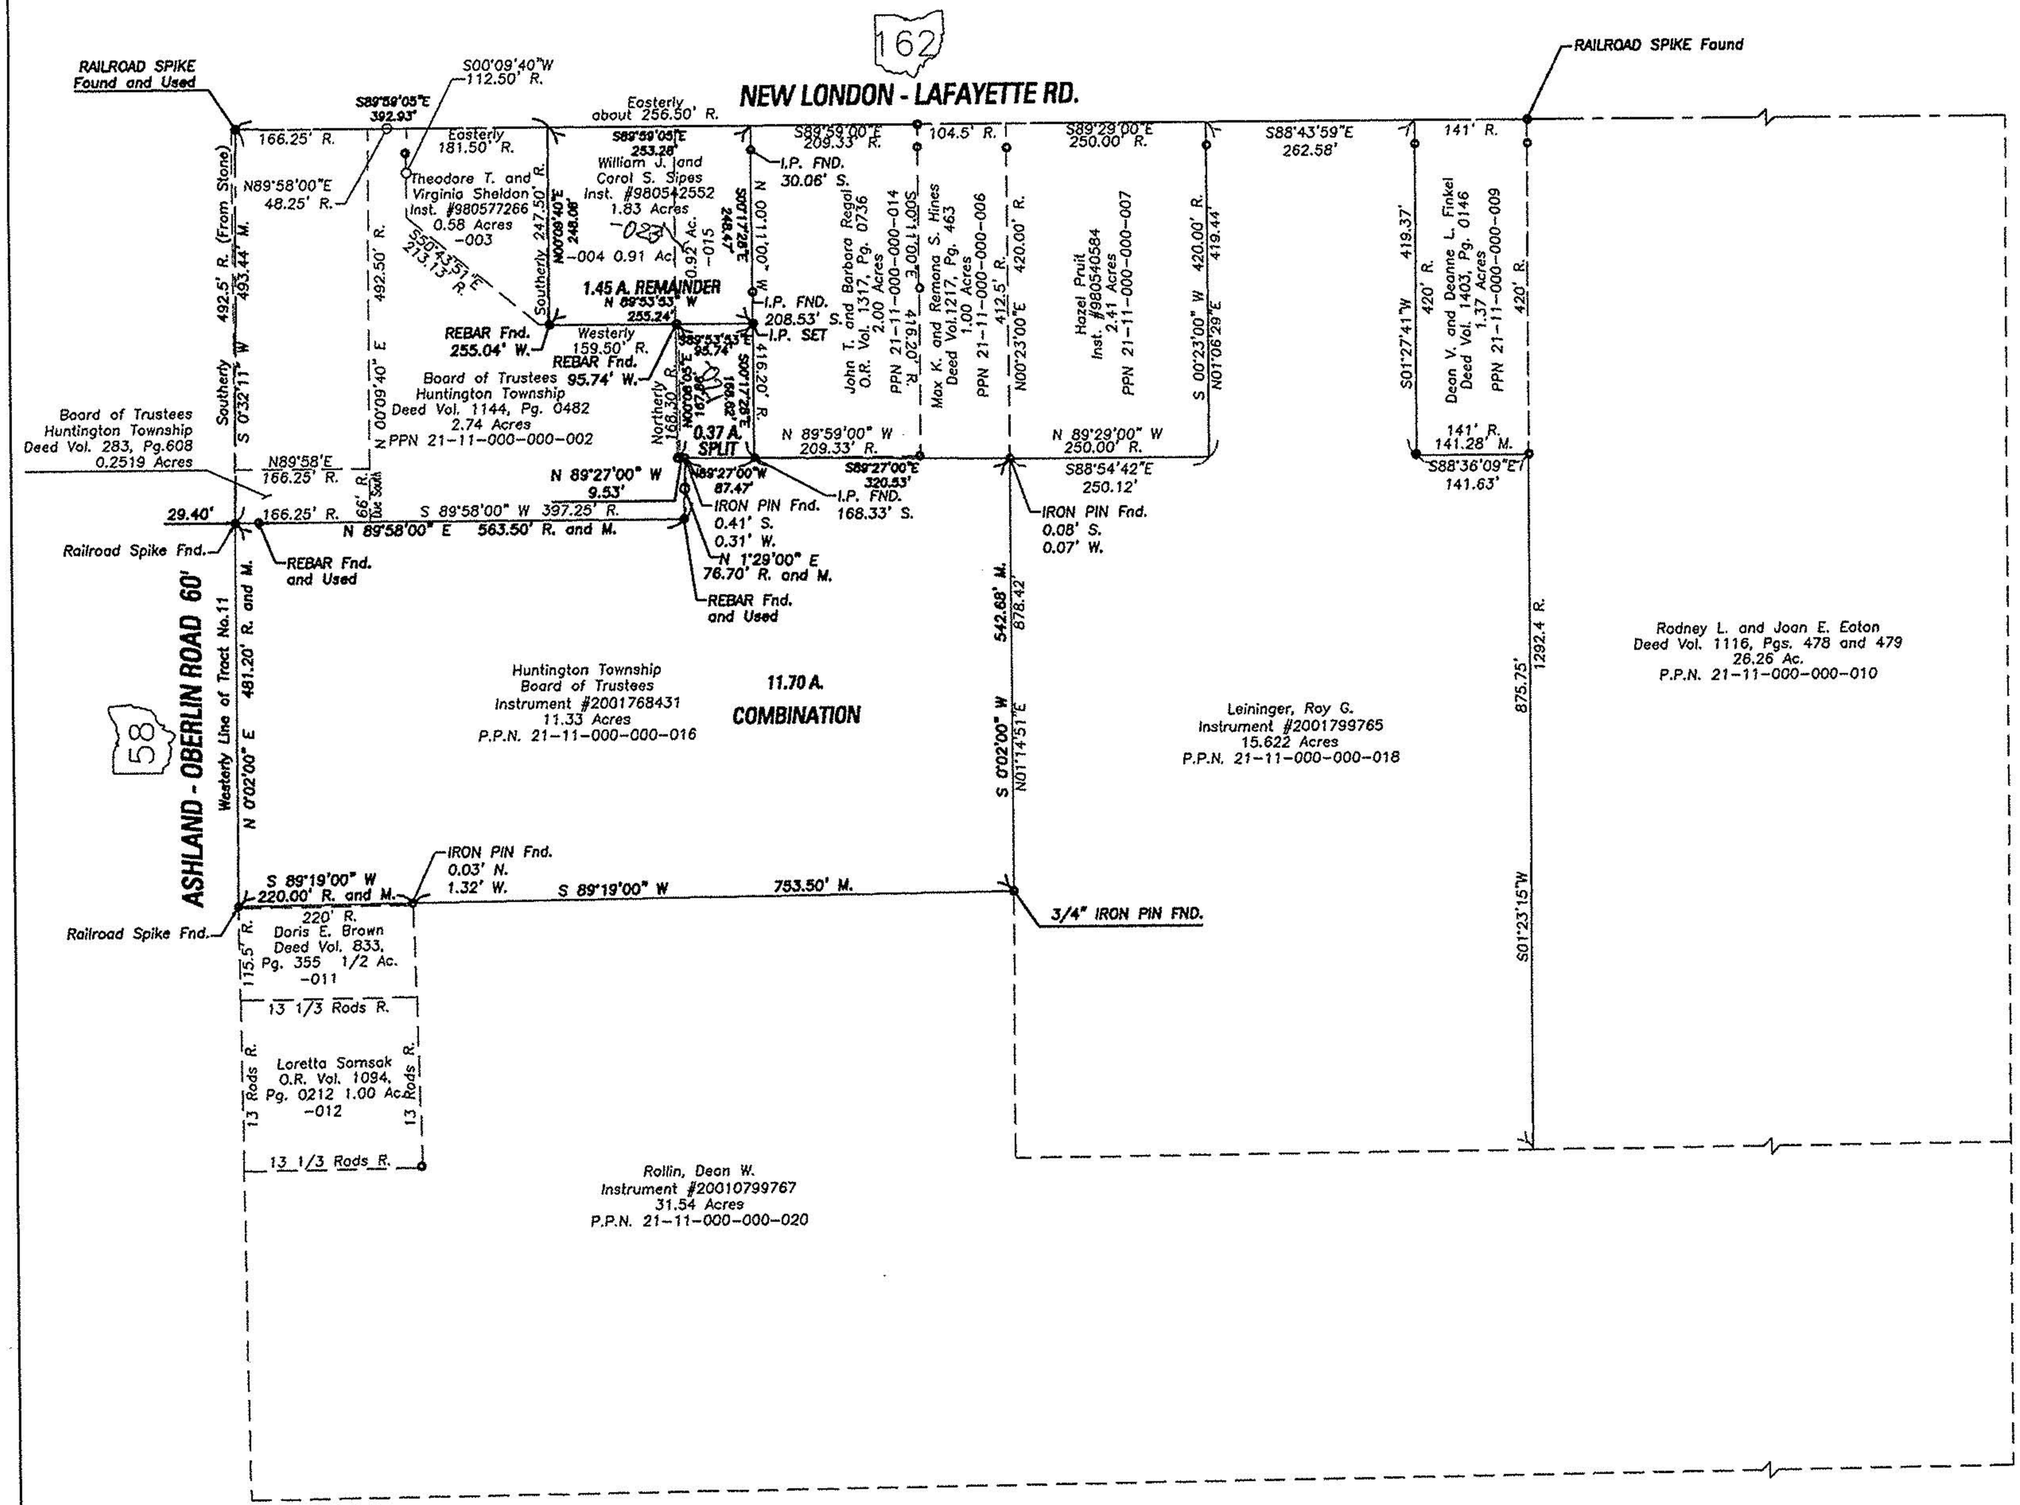

STATE OF OHIO
KENNETH P. CARNEY
6267
REGISTERED PROFESSIONAL SURVEYOR

Kenneth P. Carney P.E., P.S.
Lorain County Engineer
OHIO Reg. No. 6267

100 0 50 100 200 400
SCALE IN FEET

SURVEY PREPARED BY: LORAIN COUNTY ENGINEER

JOB	BOUNDARY SURVEY
	0.37 ACRE SPLIT
TOWNSHIP	HUNTINGTON TOWNSHIP
LOCATION	TRACT NO.11
DRAWN BY	RJM DATE 9/03
CHECKED BY	JRH DATE 10/03
CAD STATION	CAD01
CAD FILE	E:\DWGS\LDOT\200335\COMBINATION SURVEY.DWG

LCE