


MAP OF SURVEY AND LOT SPLIT

SITUATED IN THE TOWNSHIP OF HUNTINGTON, COUNTY OF LORAIN, STATE OF OHIO AND
BEING KNOWN AS PART OF ORIGINAL HUNTINGTON TOWNSHIP TRACT 2, LOT 13.

SURVEYOR'S STATEMENT


DISTANCES ARE EXPRESSED IN FEET AND DECIMAL PARTS THEREOF. BEARINGS ARE TO AN ASSUMED MERIDIAN AND ARE USED TO INDICATE ANGLES ONLY. PERMANENT MONUMENTS WERE FOUND OR SET AS INDICATED HEREON. ALL OF WHICH I DECLARE TO CORRECT.

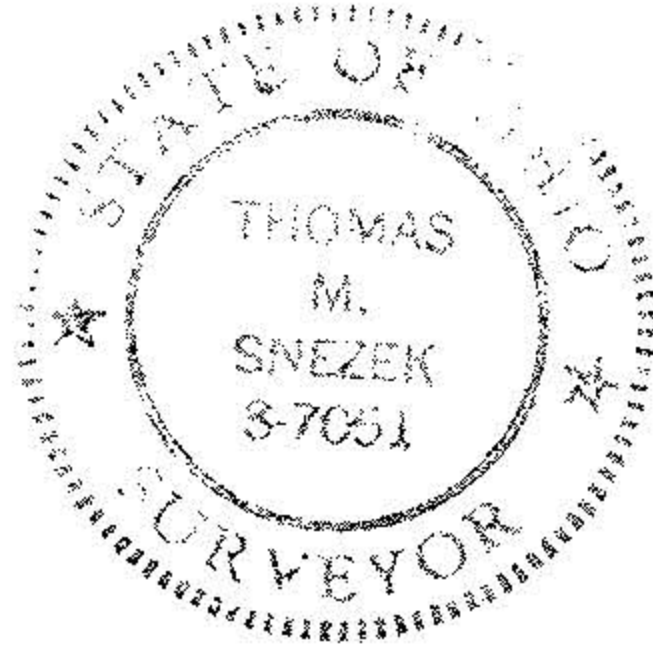

NORTH
1" = 60'

REV. 1-18-95
Thomas M. Snezek 6-18-92
THOMAS M. SNEZEK R.L.S. #7051

REMAINDER PARCEL
21.702 ACRES

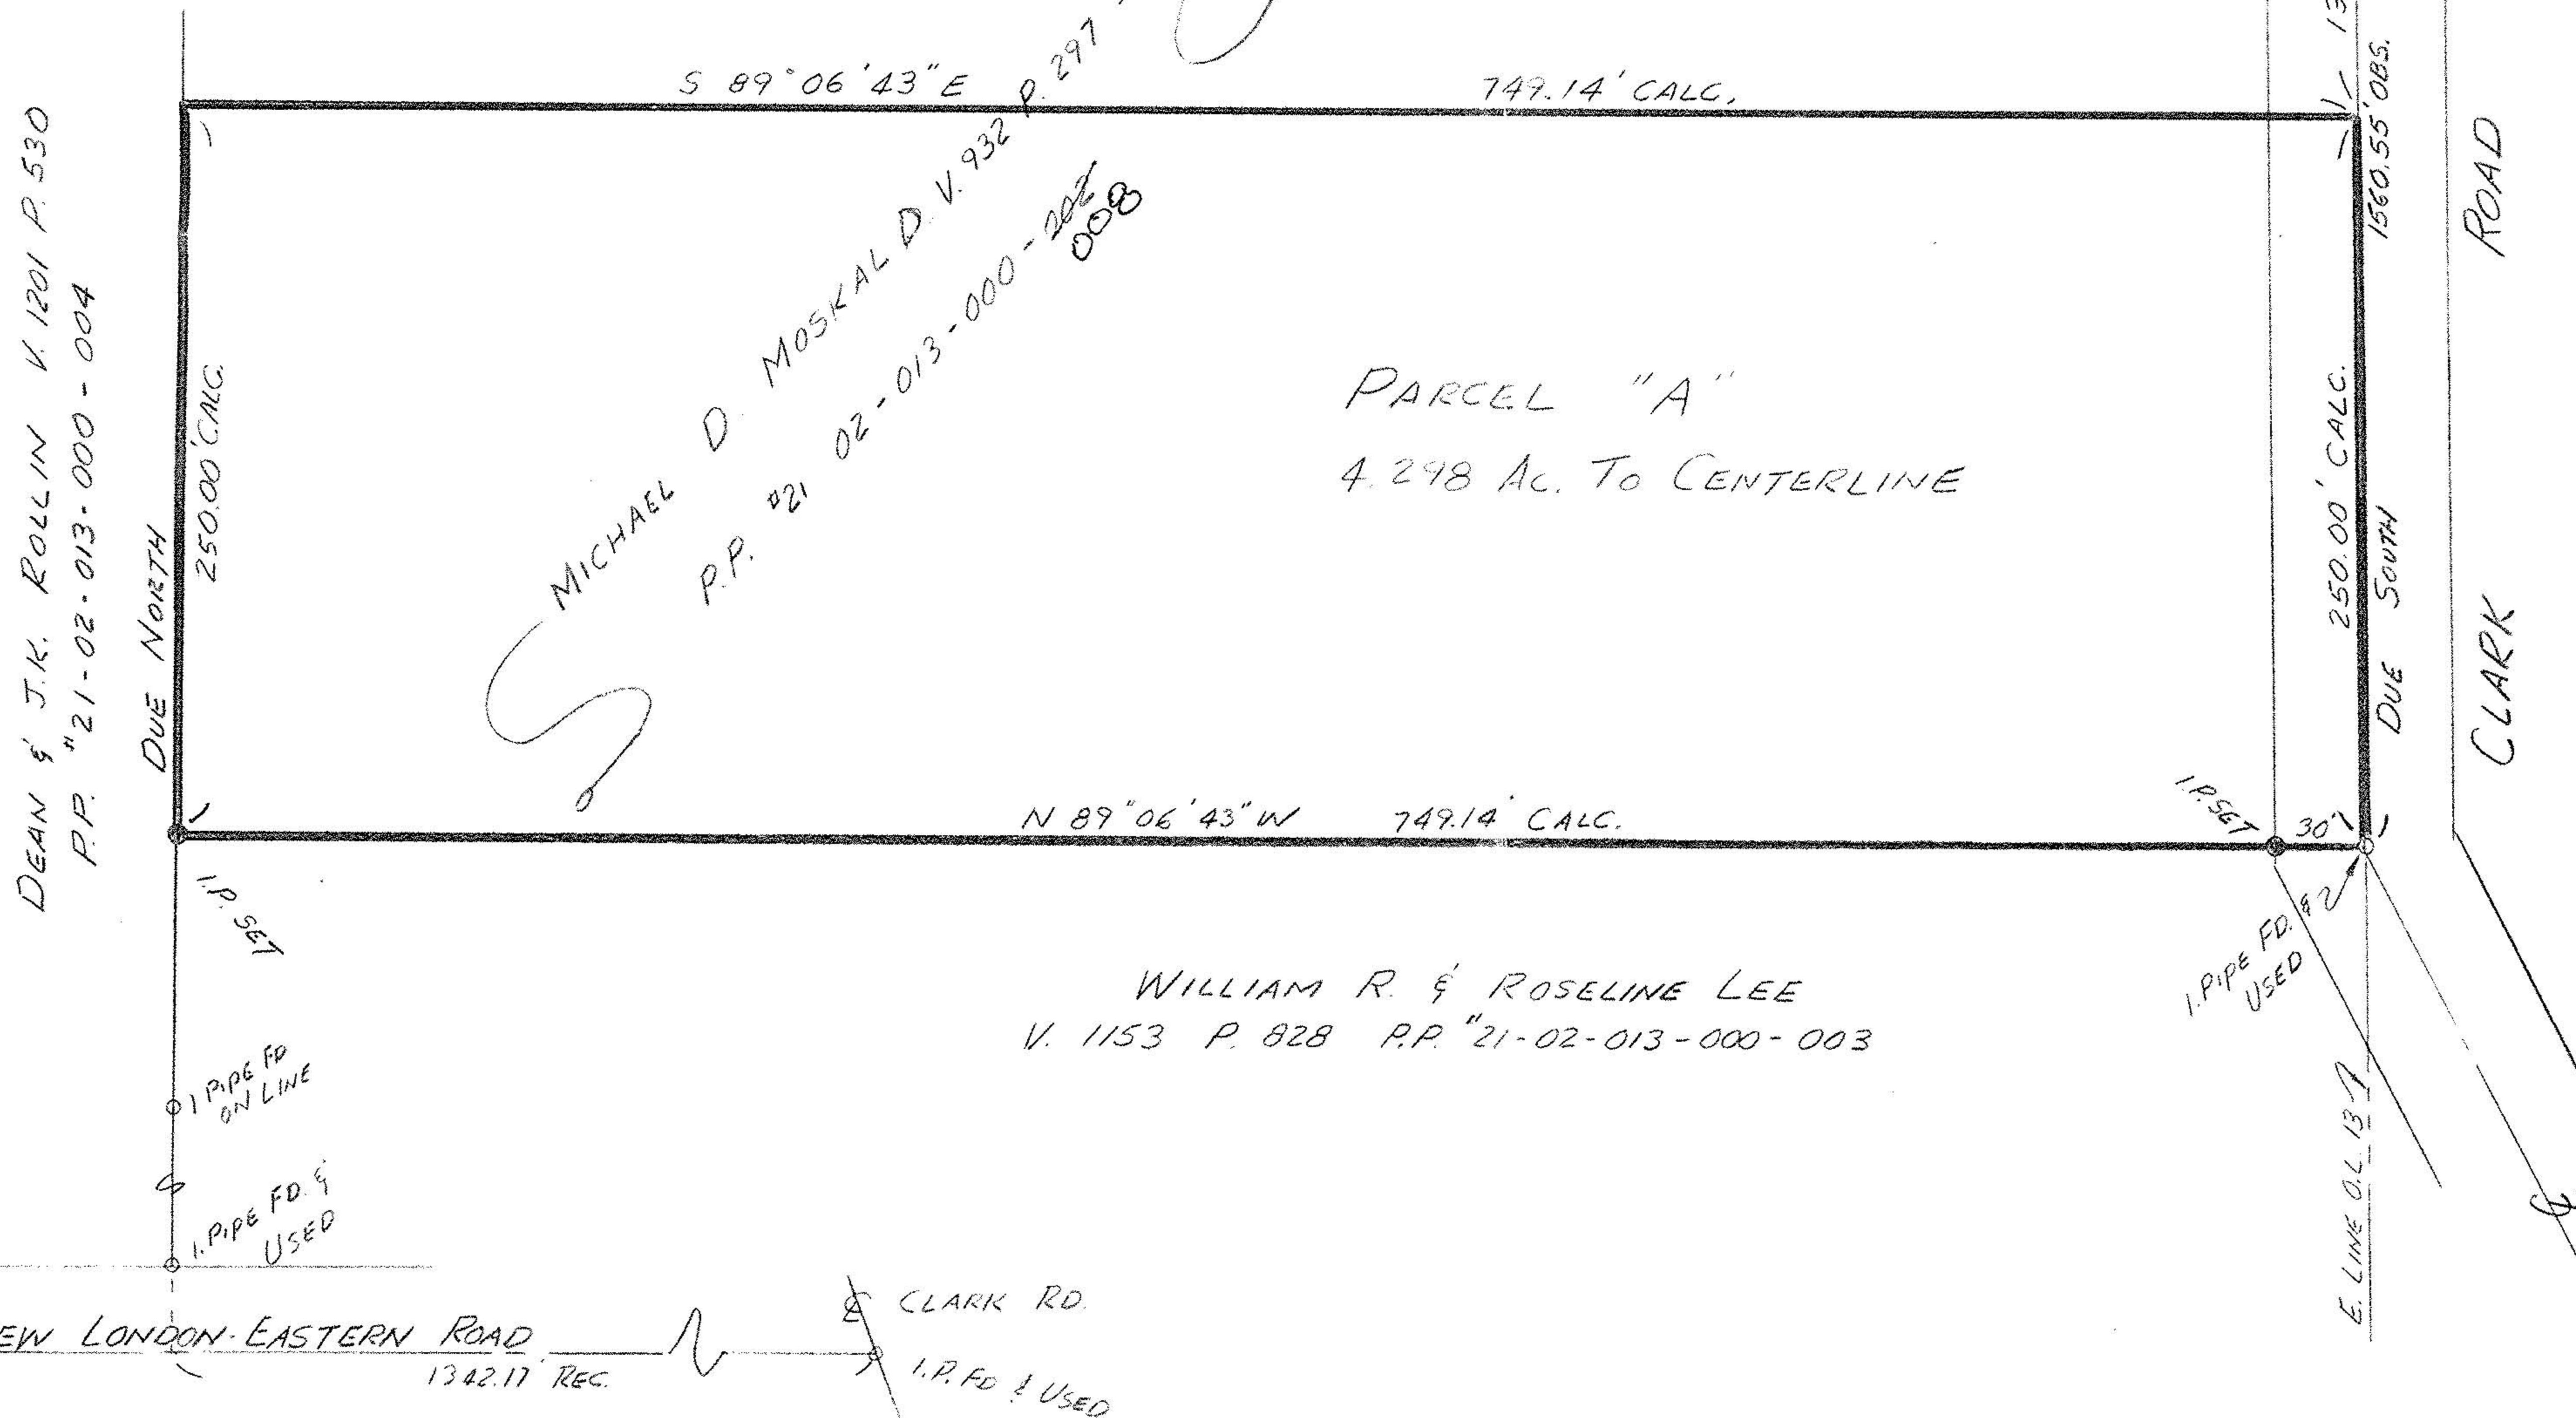

21243

APPROVED
LORAIN CO.
MAP DEPT

DATE 3-1-95

PAGE 21-E

BY CAROLYN
FRANCIS

#21243