


-004
JOHN L. & BETTY A. FLORES
D.V. 1106 P. 846

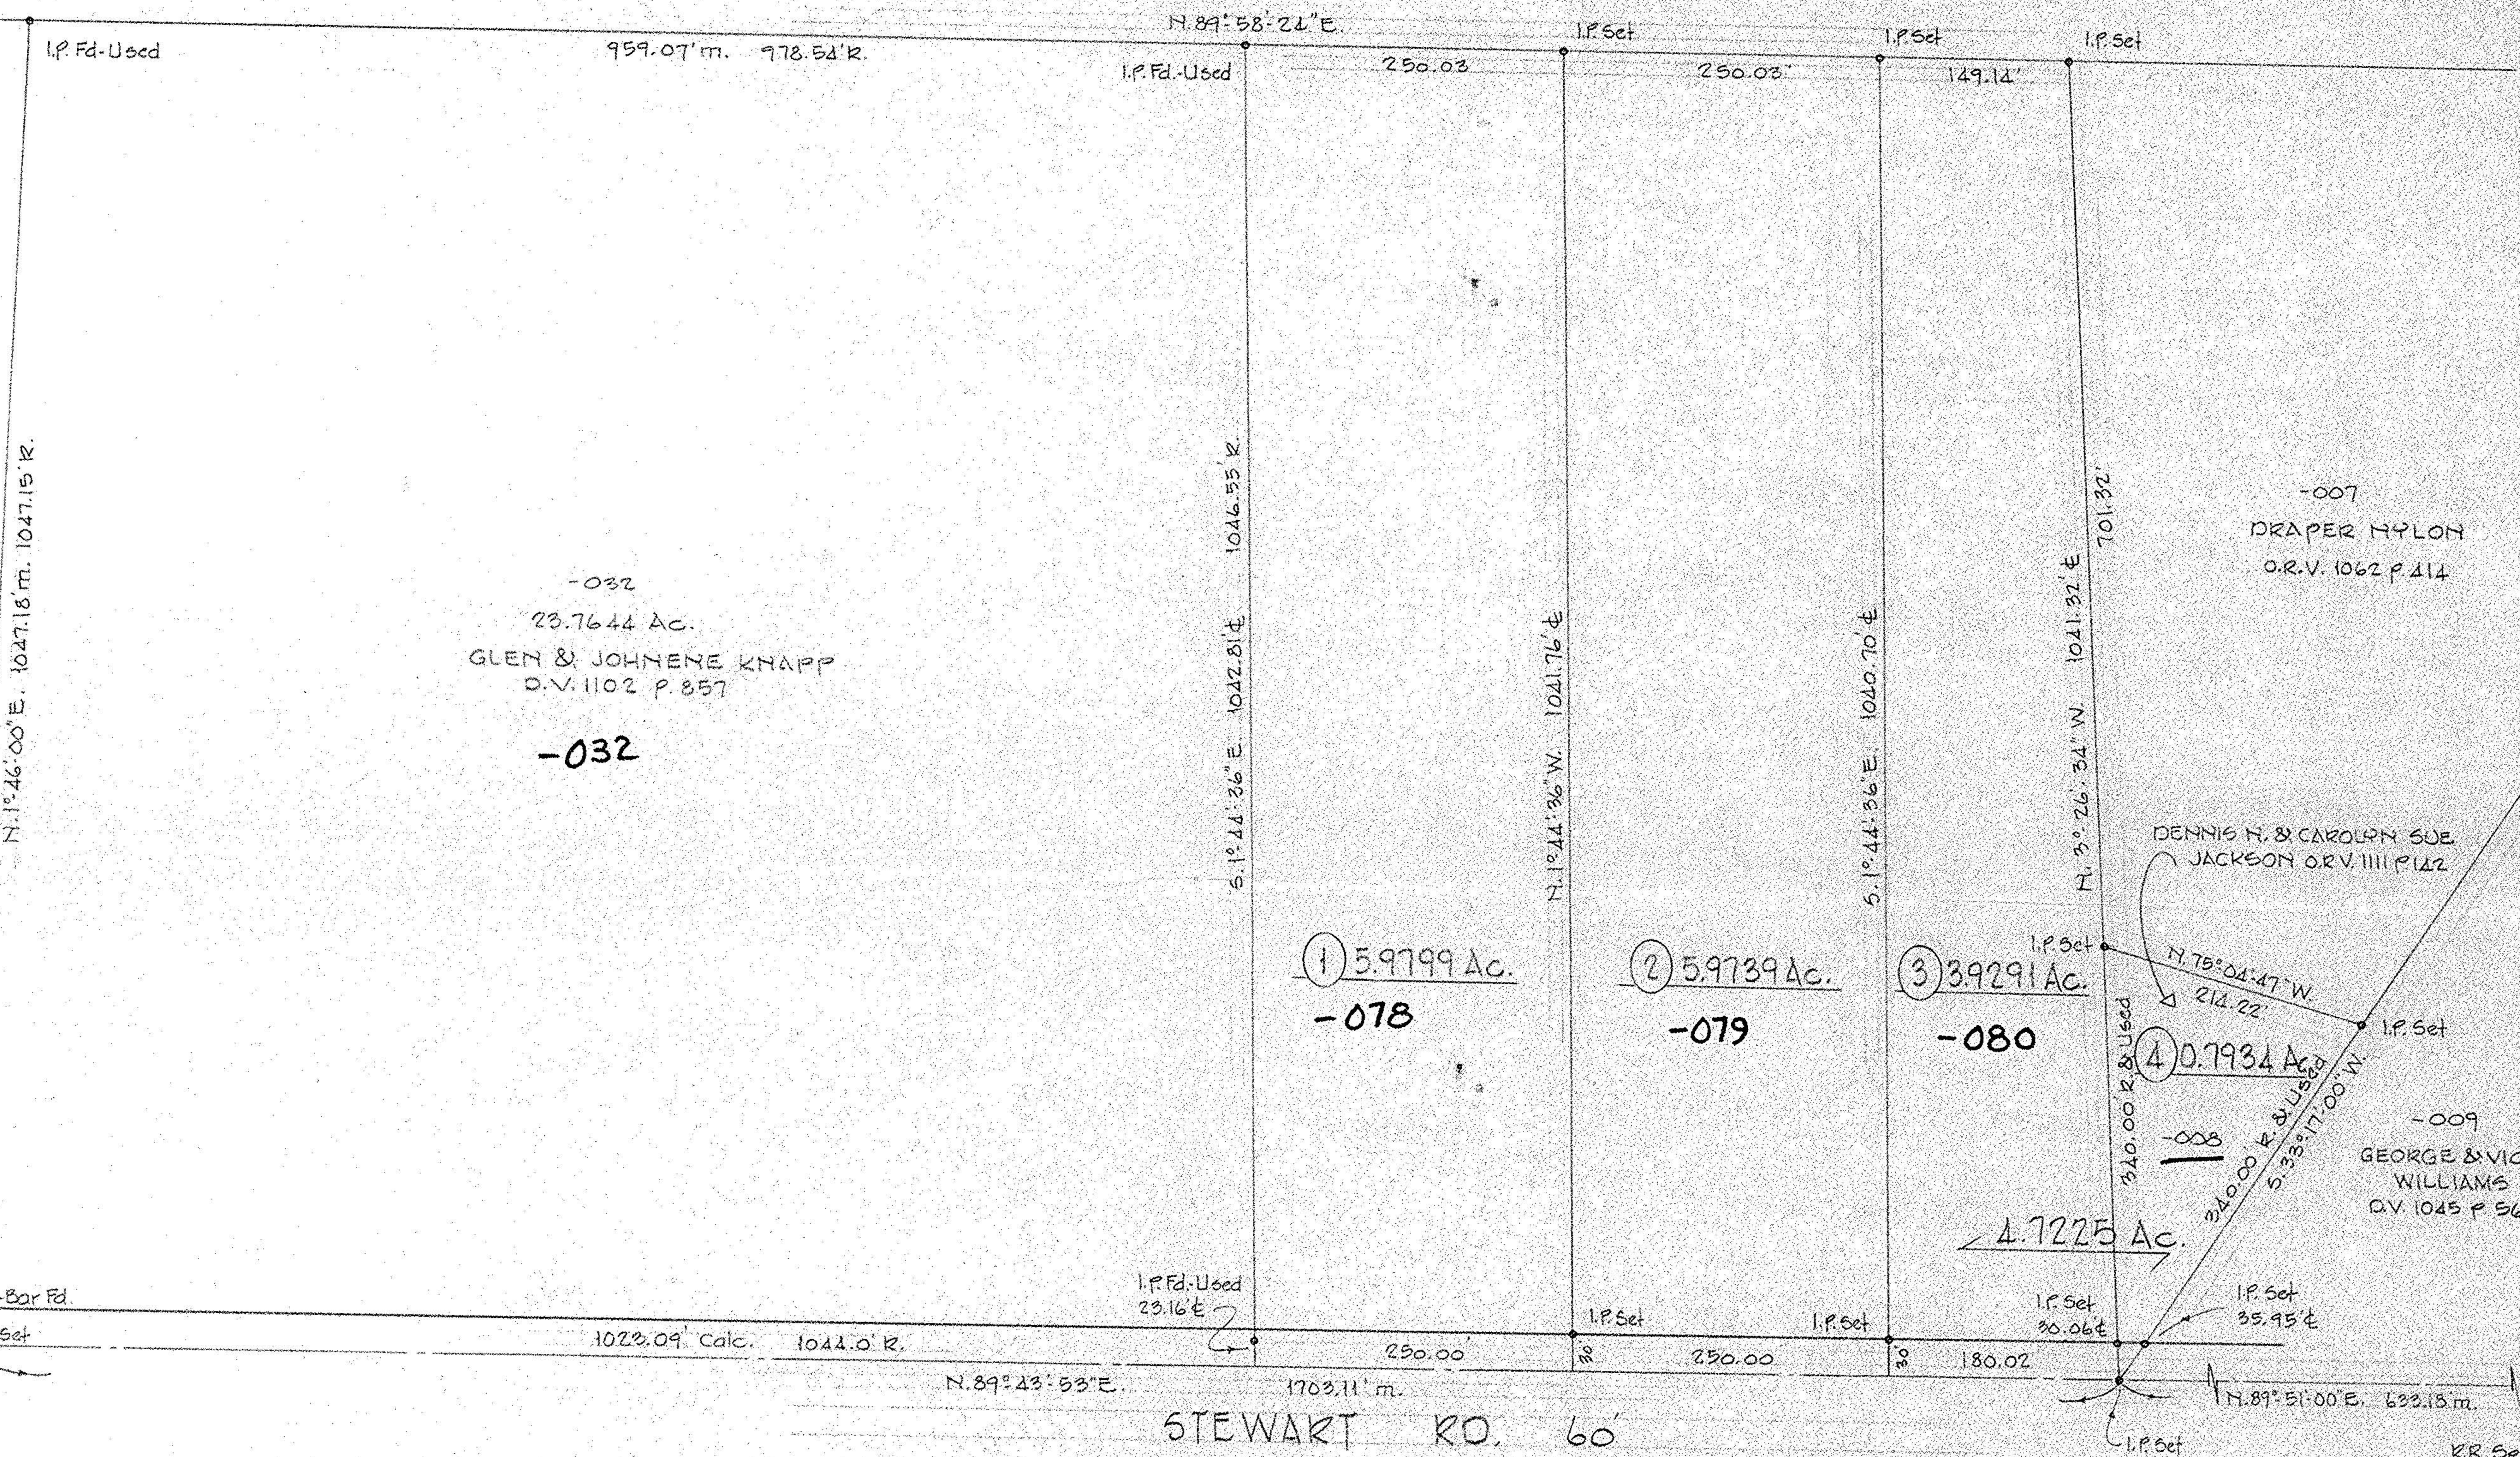

WILSON LINE OF HUNTINGTON TWP

BAKER RD.

STEWART RD. 60'

-032
23.7644 AC.
GLEN & JOHNEE KNAPP
D.V. 1102 P. 857

-007
DRAPER HYLON
D.V. 1062 P. 414

① 5.9799 AC.
-078

② 5.9739 AC.
-079

③ 3.9291 AC.
-080

④ 0.7934 AC.
-008

-009
GEORGE & VICTORIA
WILLIAMS
D.V. 1045 P. 56

4.7225 AC.

#22390
APPROVED
LORAIN CO.
MAP DEPT
DATE 12/23/97
PAGE 21-E
BY K. Colbert

SURVEY FOR
DENNIS H. & CAROLYN SUE JACKSON
AND
ANTHONY R. WILLIAMS

PART of TRACT No 3 TOWNSHIP of HUNTINGTON
COUNTY of LORAIN STATE of OHIO
AUGUST 1997 SCALE 1"=100'
LAURDON • SIMON • CAHL & ASSOC.
PROFESSIONAL LAND SURVEYORS
JOB No: 96-2908 FB. 240 P. 71-74

