DIMENSIONS SHOWN ON THIS PLAT ARE EXPRESSED IN FEET AND DECIMAL PARTS THEREOF, ALL BEARINGS ARE TO AN ASSUMED MERIDIAN AND ARE USED TO INDICATE ANGLES ONLY. PERMANENT MONUMENTS WERE FOUND OR SET AT ALL POINTS INDICATED HEREON, ALL OF WHICH I CERTIFY TO BE CORRECT.

STATE OF OHIO THOMAS A SIMON S-7775 REGISTERED PROFESSIONAL SURVEYOR

THOMAS A. SIMON
REG. PROFESSIONAL SURVEYOR
NO. S-7775

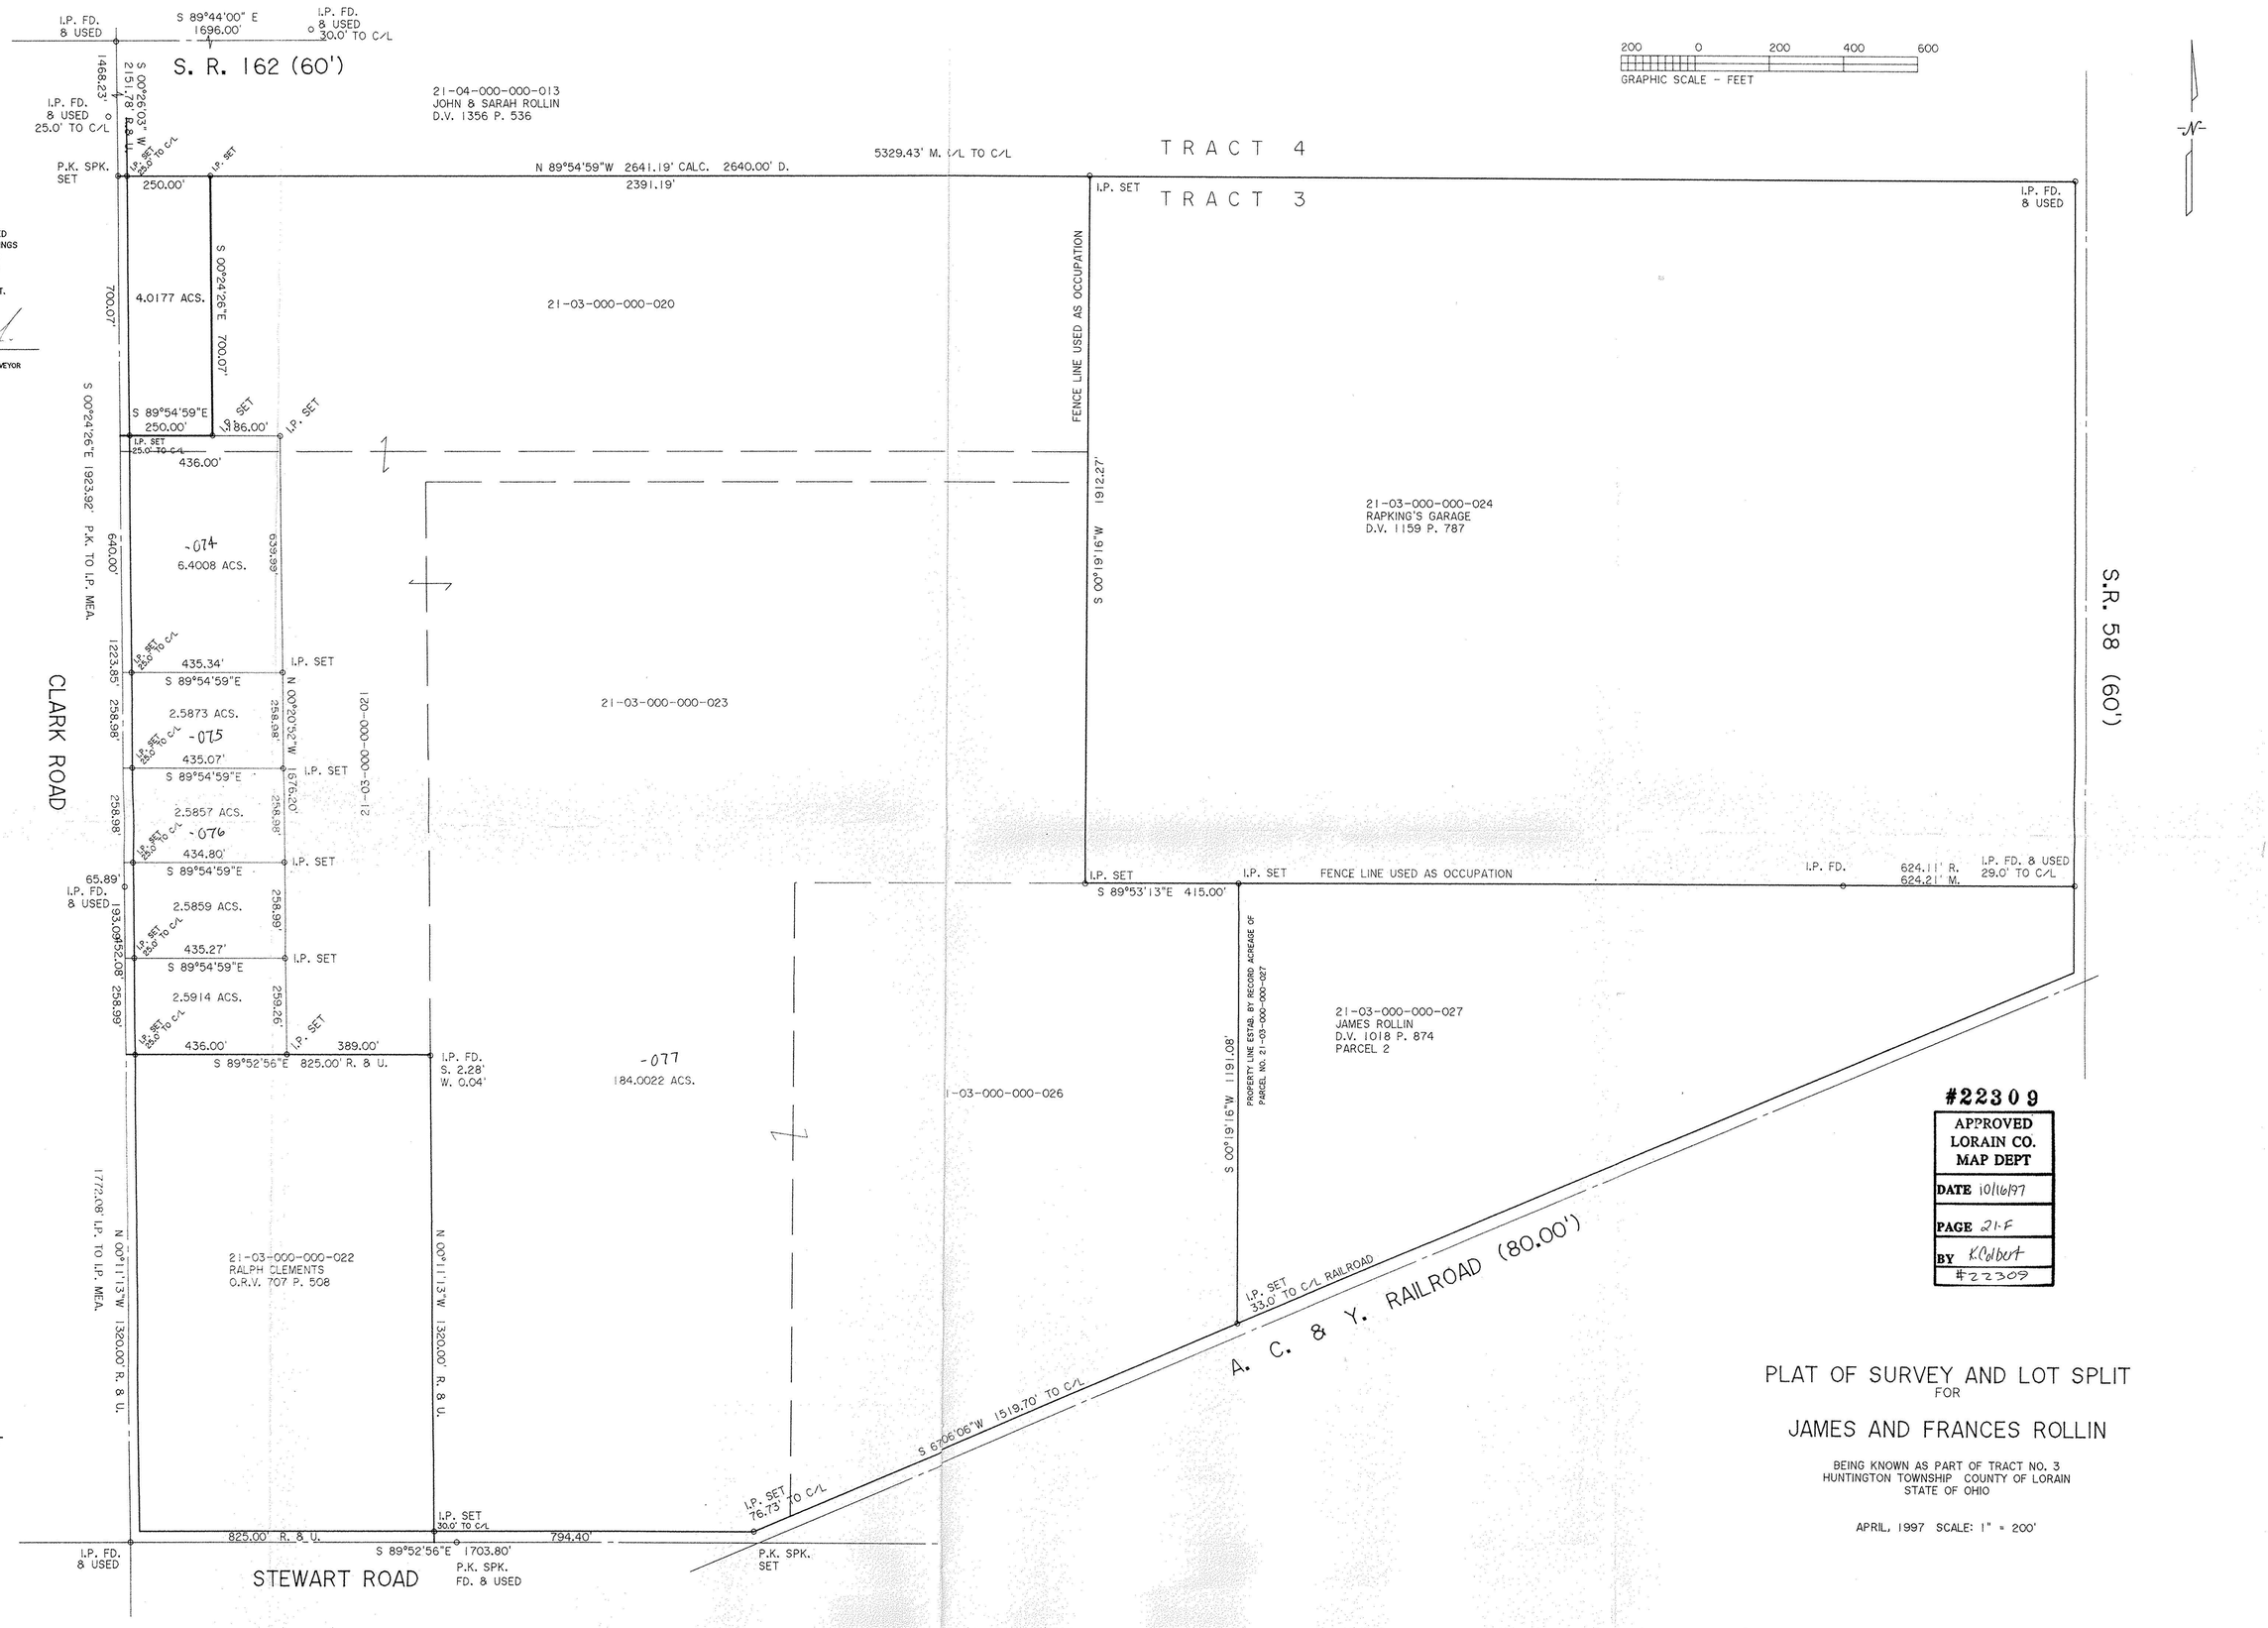

#22309

APPROVED LORAIN CO. MAP DEPT
DATE 10/16/97
PAGE 21-F
BY K. Colbert
#22309

PLAT OF SURVEY AND LOT SPLIT
FOR
JAMES AND FRANCES ROLLIN

BEING KNOWN AS PART OF TRACT NO. 3
HUNTINGTON TOWNSHIP COUNTY OF LORAIN
STATE OF OHIO

APRIL, 1997 SCALE: 1" = 200'

THOMAS SIMON & ASSOCIATES, INC.
PROFESSIONAL LAND SURVEYORS
28901 CLEMENS ROAD
SUITE 119
WESTLAKE, OHIO 44145
(216) 871-1391
FAX (216) 871-7335