MAP OF LOT SPLIT SURVEY

FOR

RUSSELL HENDRICKS

SITUATED IN THE TOWNSHIP OF HUNTINGTON, COUNTY OF LORAIN, STATE OF OHIO AND BEING KNOWN AS PART OF ORIGINAL LOT NO. 20 IN TRACT NO. 5

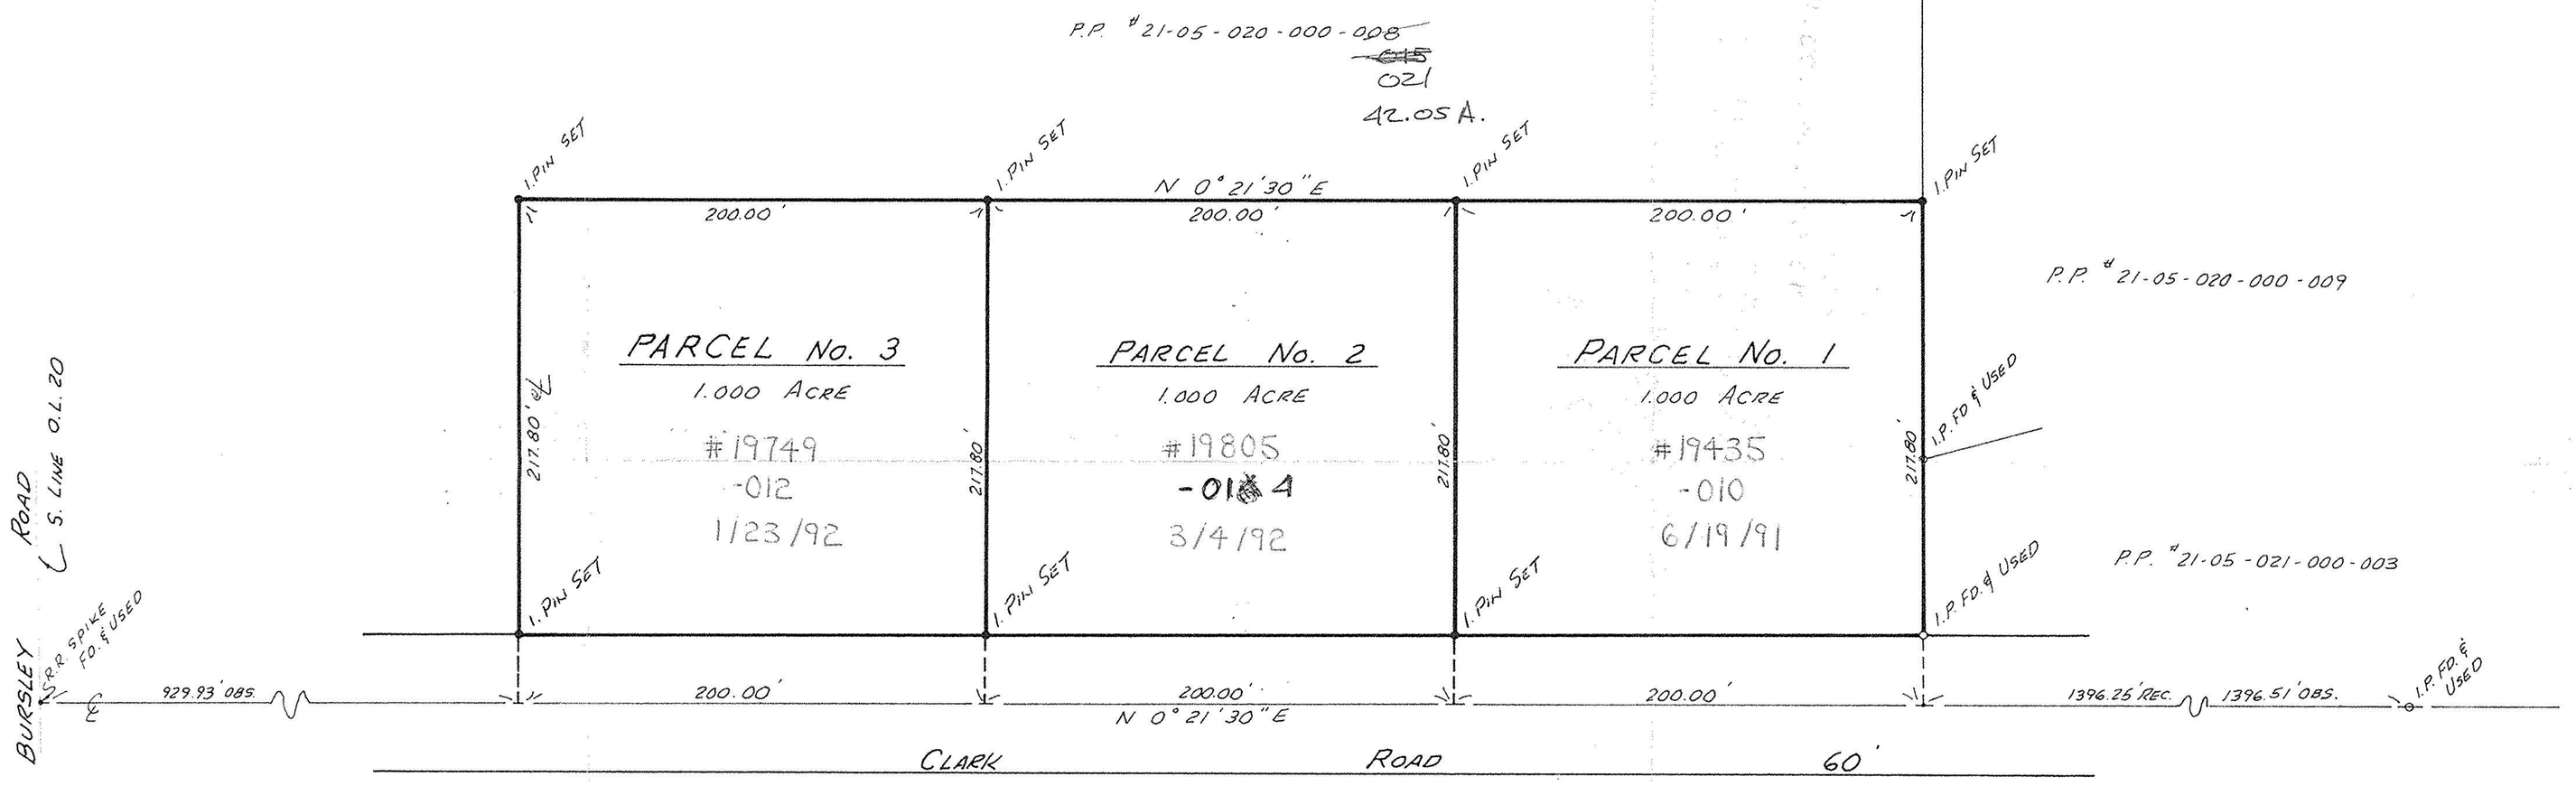

SURVEYOR'S STATEMENT

DISTANCES ARE EXPRESSED IN FEET AND DECIMAL PARTS THEREOF. BEARINGS ARE TO AN ASSUMED MERIDIAN AND ARE USED TO INDICATE ANGLES ONLY. PERMANENT MONUMENTS WERE FOUND OR SET AS INDICATED HEREON. ALL OF WHICH I DECLARE TO BE CORRECT.

Thomas M. Snezek 5-18-91

THOMAS M. SNEZEK S-7051

STATE OF OHIO
THOMAS M. SNEZEK
S-7051
SURVEYOR

1" = 50'

NORTH

APPROVED
LORAIN CO.
MAP DEPT.
DATE 1-23-92
PAGE 21-A
BY CAROLYN FRANCIS
VOID AFTER # 19749

19749
19805
19435

21-05-020-000