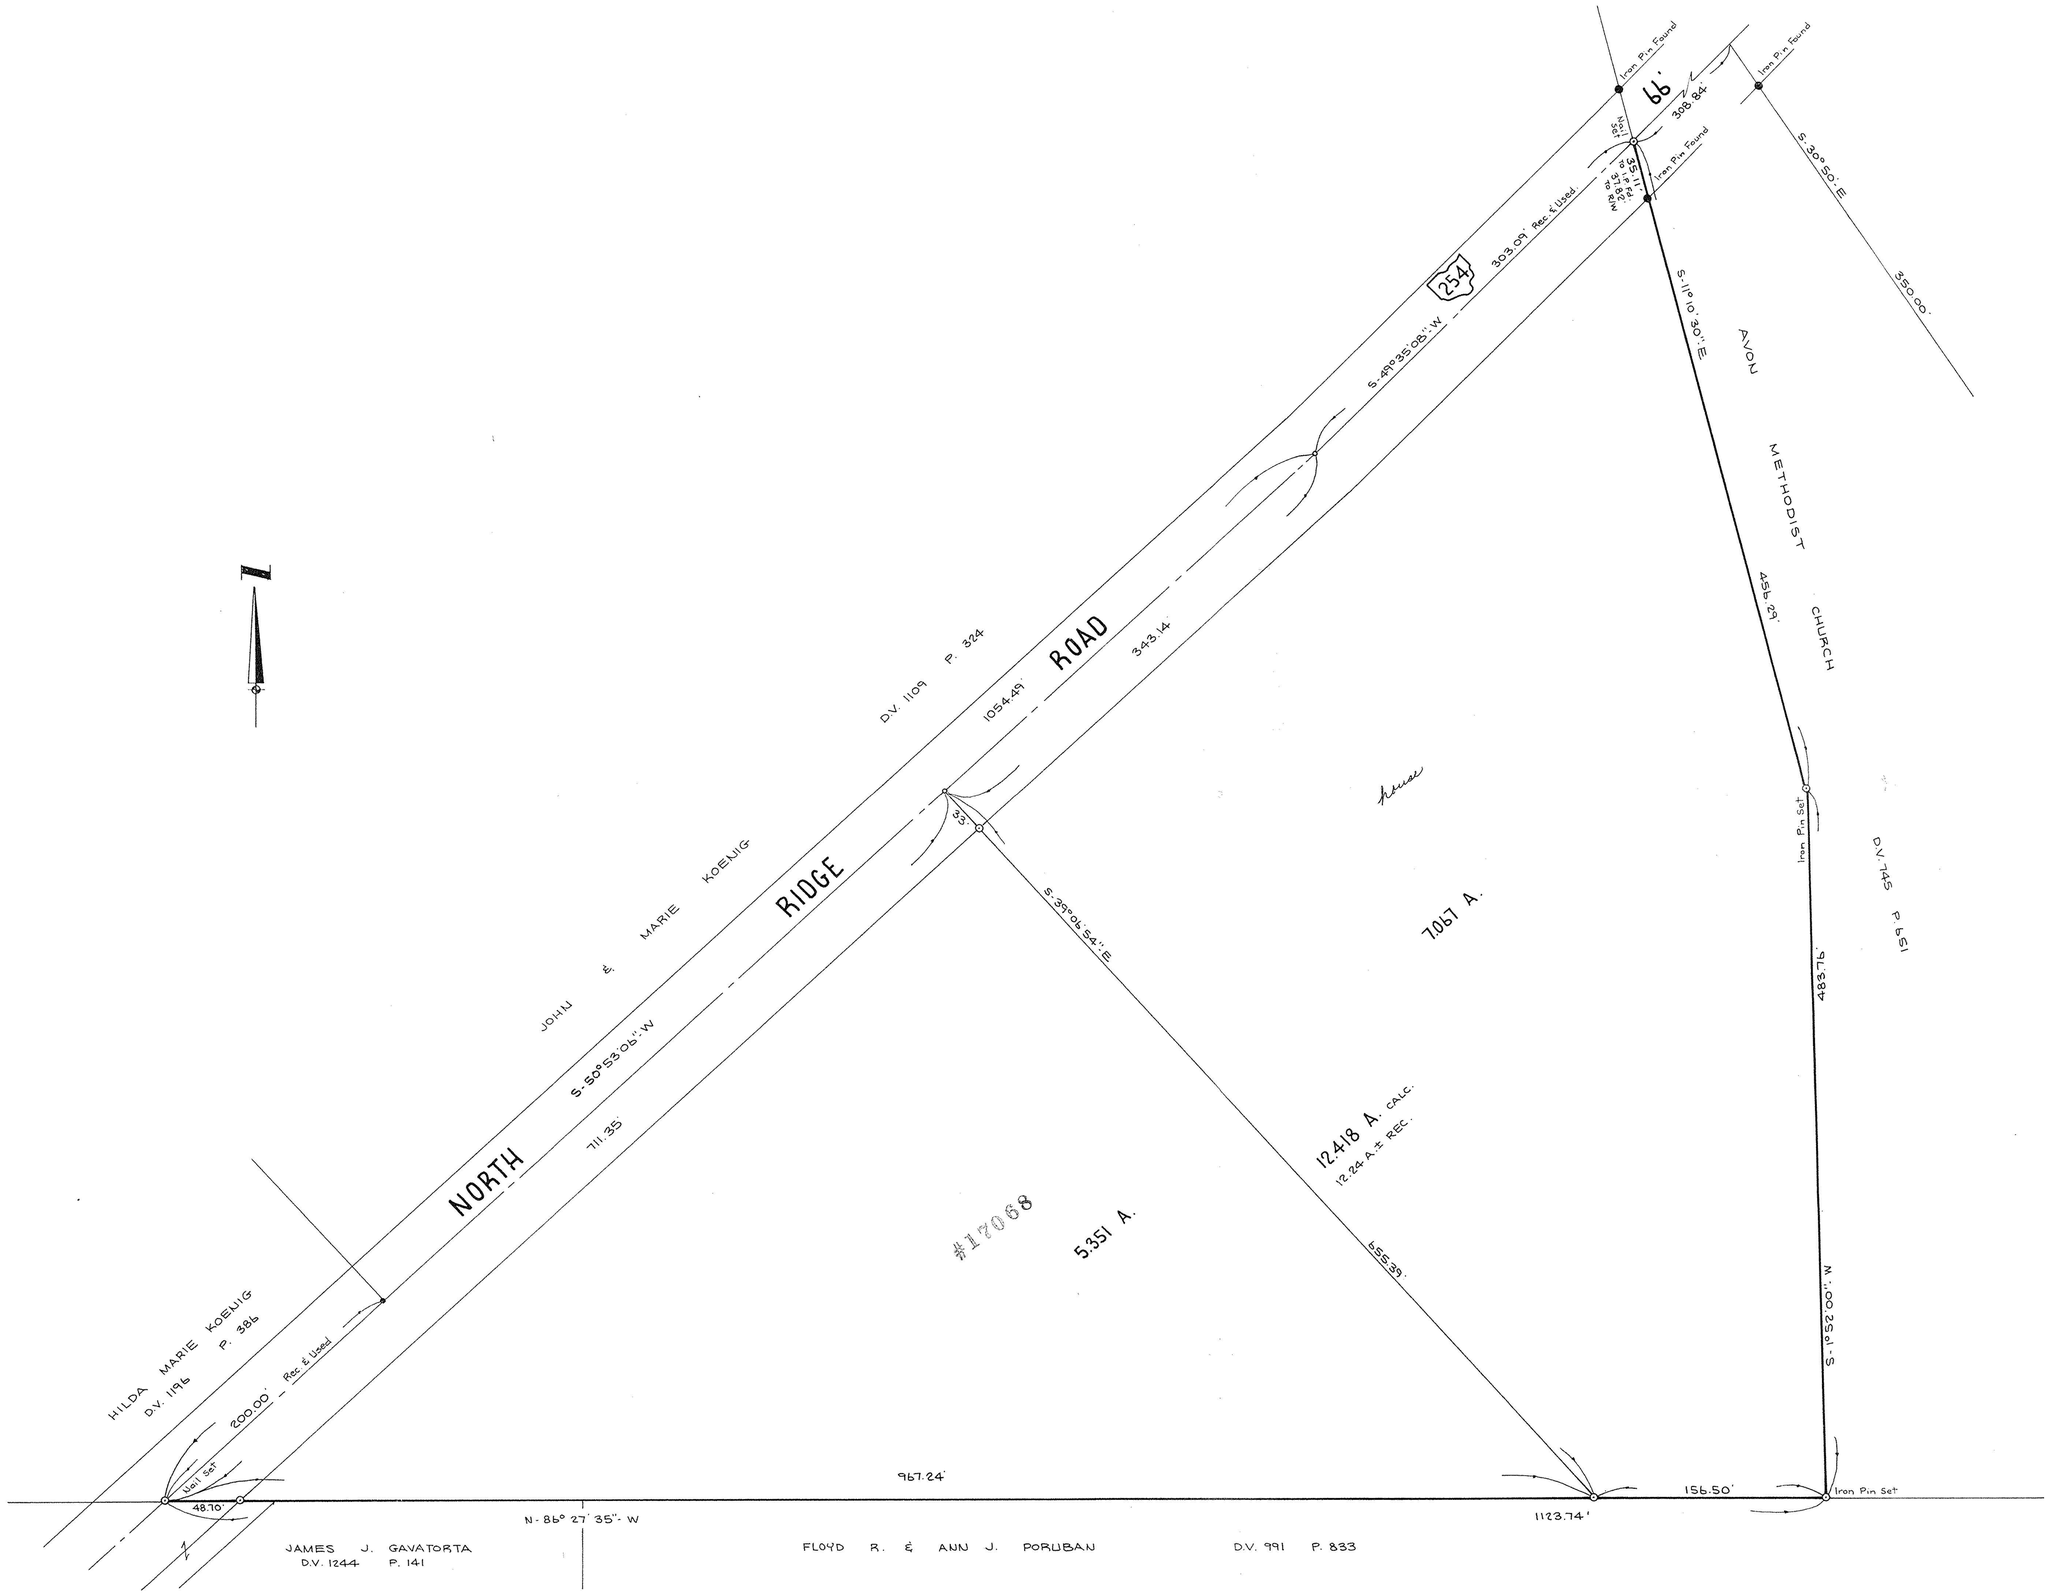

#17068

APPROVED
LORAIN CO.
MAP DEPT.
DATE 10-8-86
PAGE 4-00-011-A
BY C. Francis
VOID AFTER 17068

BOUNDARY SURVEY

OF PART OF

AVON TOWNSHIP SECTION № 11

CITY OF AVON — COUNTY OF LORAIN

STATE OF OHIO

SCALE : 1" = 50' — SEPT. 15, 1986

PREPARED BY

KLEINOEDER - SCHMIDT & ASSOC.

CONSULTING ENGINEERS & SURVEYORS

Robert E. Kleinoeder

86-206