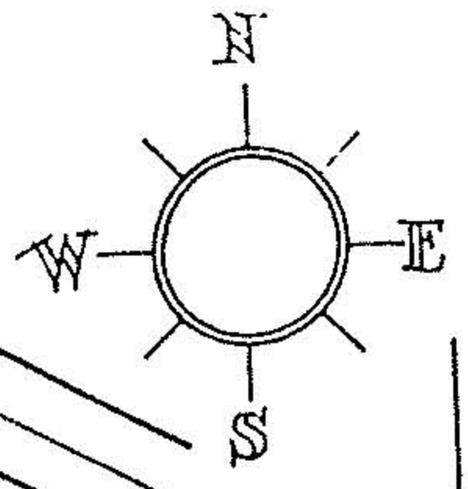

SHEFFIELD - FRENCH CREEK ROAD

IRON PIN FOUND
IRON PIN FOUND
IRON PIN FOUND
IRON PIN FOUND
IRON PIN SET
S 60°23'E, 443.00'
30'
IRON PIN SET
S 60°23'E, 370.00'
IRON PIN SET
IRON PIN FOUND
5.10 ACRES
0.17 ACRE SECT. 3
4.93 ACRES SECT. 10
N 0°32'00"W, 953.71'
N 17°57'00"E, 780.37'
5.56 ACRES REMAINING
IRON PIN SET
IRON PIN SET
IRON PIN SET
IRON PIN FD.
N 17°17'E, 584.66'
185.37'
N 89°22'30"E, 418.08'
SECT. 3
SECT. 2
SECT. 10
SECT. 11
20'
N 89°22'30"E, 110.00'
20'
8.12'

#15917
4.00.010.E
f. Collect (T.M.)

ACREAGE	10.66
DATE	09-25-84
DRAWN	MGH
SCALE	1" : 200 ft.

STATE OF OHIO
MICHAEL G. HURA
No. 4712
REGISTERED SURVEYOR

PREPARED FOR MR. DON LAW 934-4593
38017 FRENCH CREEK ROAD, AVON, O.

MICHAEL G. HURA, registered surveyor
12706 MASON RD., VERMILION, O., Ph (216) 965 4040

PERIMETER SURVEY

SUBLOT(s) _____ of _____
_____ Volume ____ Page ____ of PLATS
PART OF O.L. ___ TRACT ____ SECTIONS 3 & 10 OF
AVON TOWNSHIP LORAIN CO., OHIO
PERMANENT PARCEL Nº _____

CITY OF AVON