EXHIBIT C-2

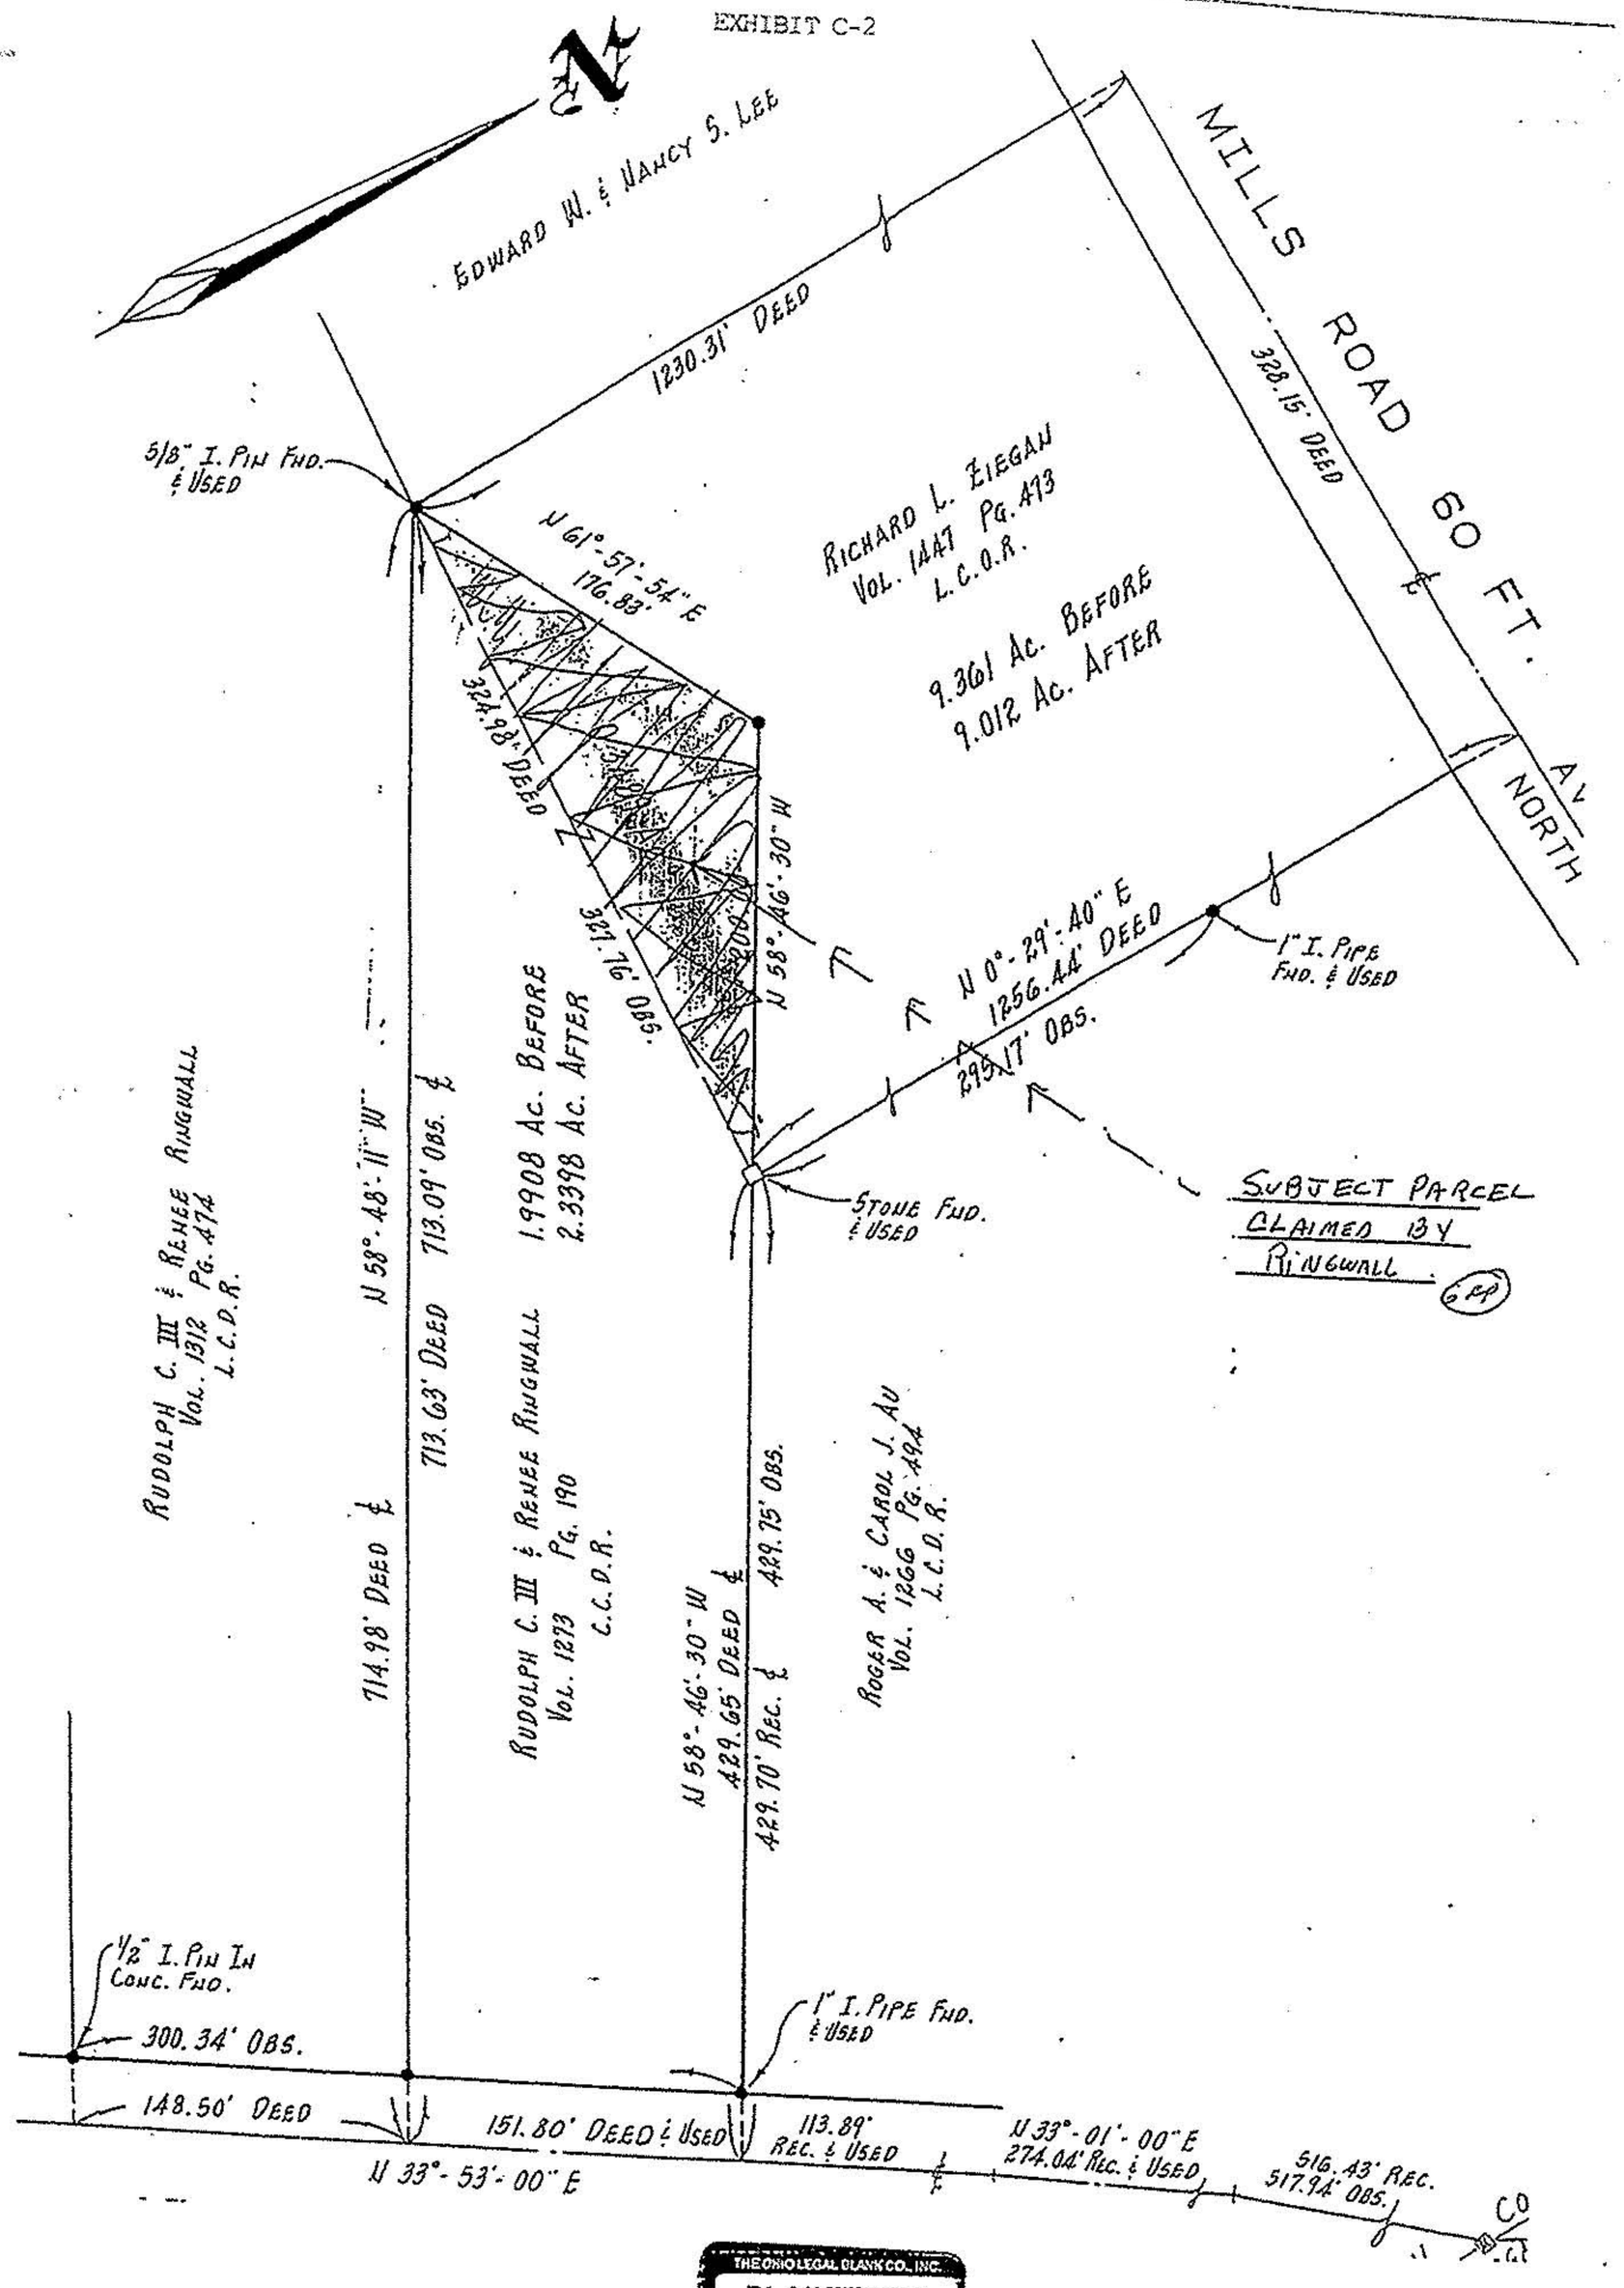

THE OHIO LEGAL BLANK CO., INC.
PLAINTIFF'S EXHIBIT
C-1
CLEVELAND, OHIO - CANTON