


PASADENA AVENUE 80 FT.

06 23-176-105-004

Blaine & Rita Sprague
354

John & Ita Mahnke
353

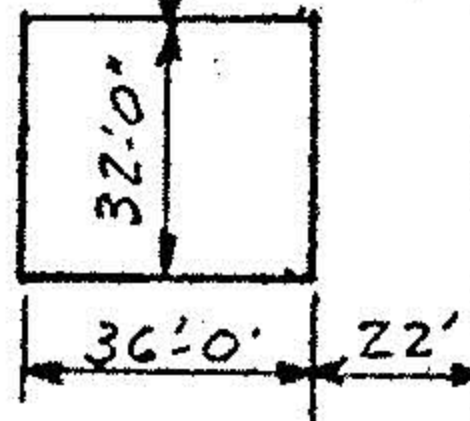

Donald Halpin
352

Albert Haag
351



MAP OF SURVEY FOR

John & Ita Mahnke

SUB-LOT 353 SPRING VALLEY

SUB'N NO 4 Q. 318 176

ELYRIA TWP. EAST OF BLACK RIVER

LORAIN COUNTY OHIO

Scale 1" = 50' July 22-1950

C.E. Penfound Reg. Surveyor

W.J. & Nancy D. Parsons

16

105.0'

107.63'

207.00'

295.0'

118.93'

92°45'

34.48'

80.09'

90°

90°

78°

80'

50'-0"

32'-0"

36'-0"

22'