NOTE: BEARINGS USED IN THIS SURVEY ARE BASED ON THOSE USED IN THE ORIGINAL DEEDS OF CONVEYANCE (VOL. 1019, PG 522, VOL 1175, PG. 396 & VOL. 1185, PG. 17) AND DO NOT CORRESPOND WITH OUR SURVEY OF PROPERTY ADJACENT AND TO THE EAST REVOLVE BEARINGS SHOWN HEREON CLOCKWISE 0°03'30" TO ATTAIN "LEEWARD COVE" DATUM.

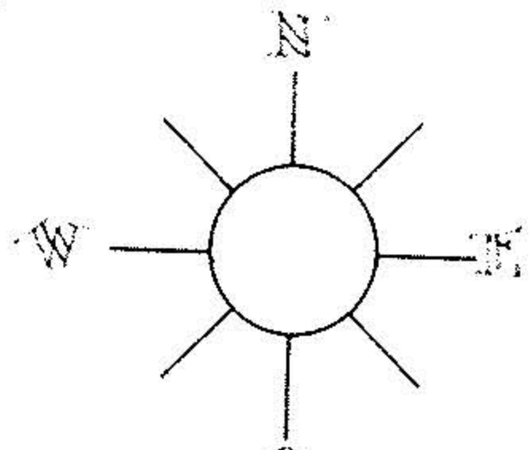

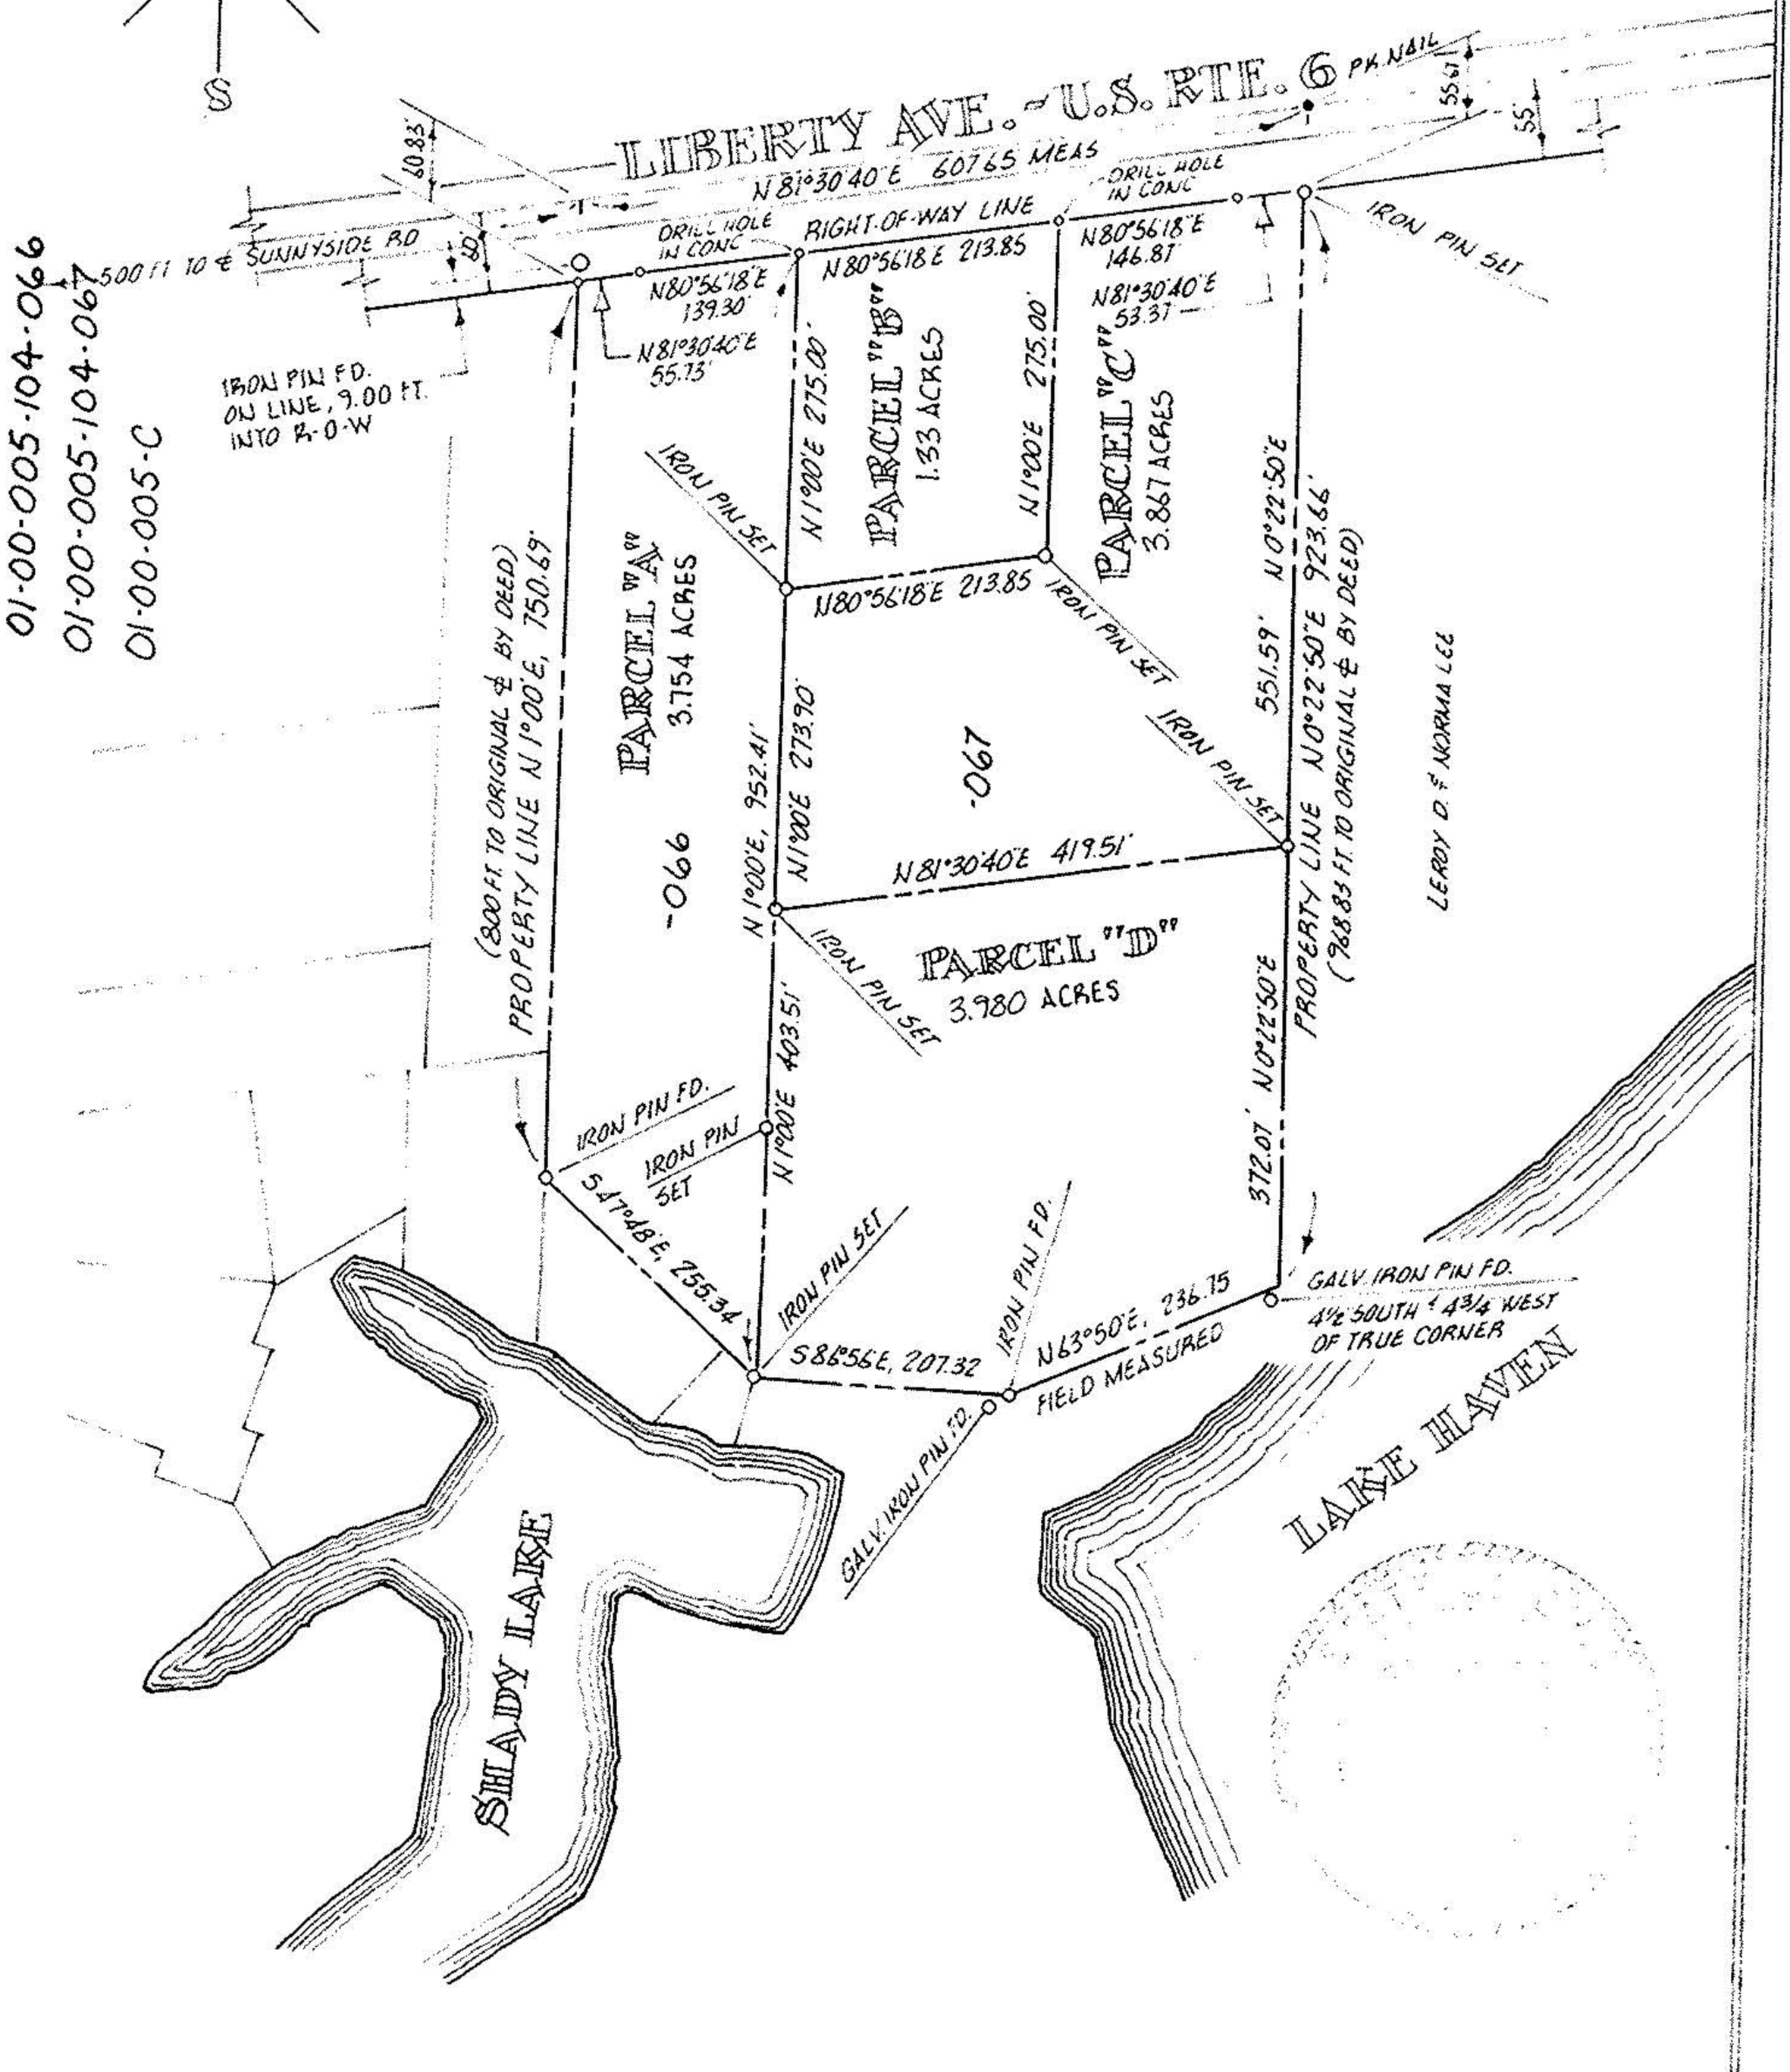

PERIMETER SURVEY

Scale 1" : 200'

Acreage 12.931

SUBLOT _____ of _____

Plat Vol _____ Page _____

Part of O.L. 5 Section _____

Tract _____ BROWNHELM TWP

City of VERMILION

LORAIN Co., Ohio

Michael G. Hura & Associates

4560 Liberty Ave. Vermilion, Ohio

drawn	MGH
date	10-07-80
scale	1" : 300'
field book	

PERMANENT PARCEL NUMBER