LOT SPLIT
NORRIS BUILDERS INC.

SITUATED IN CARLISLE TOWNSHIP, COUNTY OF LORAIN,
STATE OF OHIO, AND BEING KNOWN AS BLOCK "B" IN THE
CARLISLE WOODS SUBDIVISION, CARLISLE TWP. SECT. 18 & 19.
VOL. 58, PG. 58, 59 & 60.

SCALE: 1"=80'

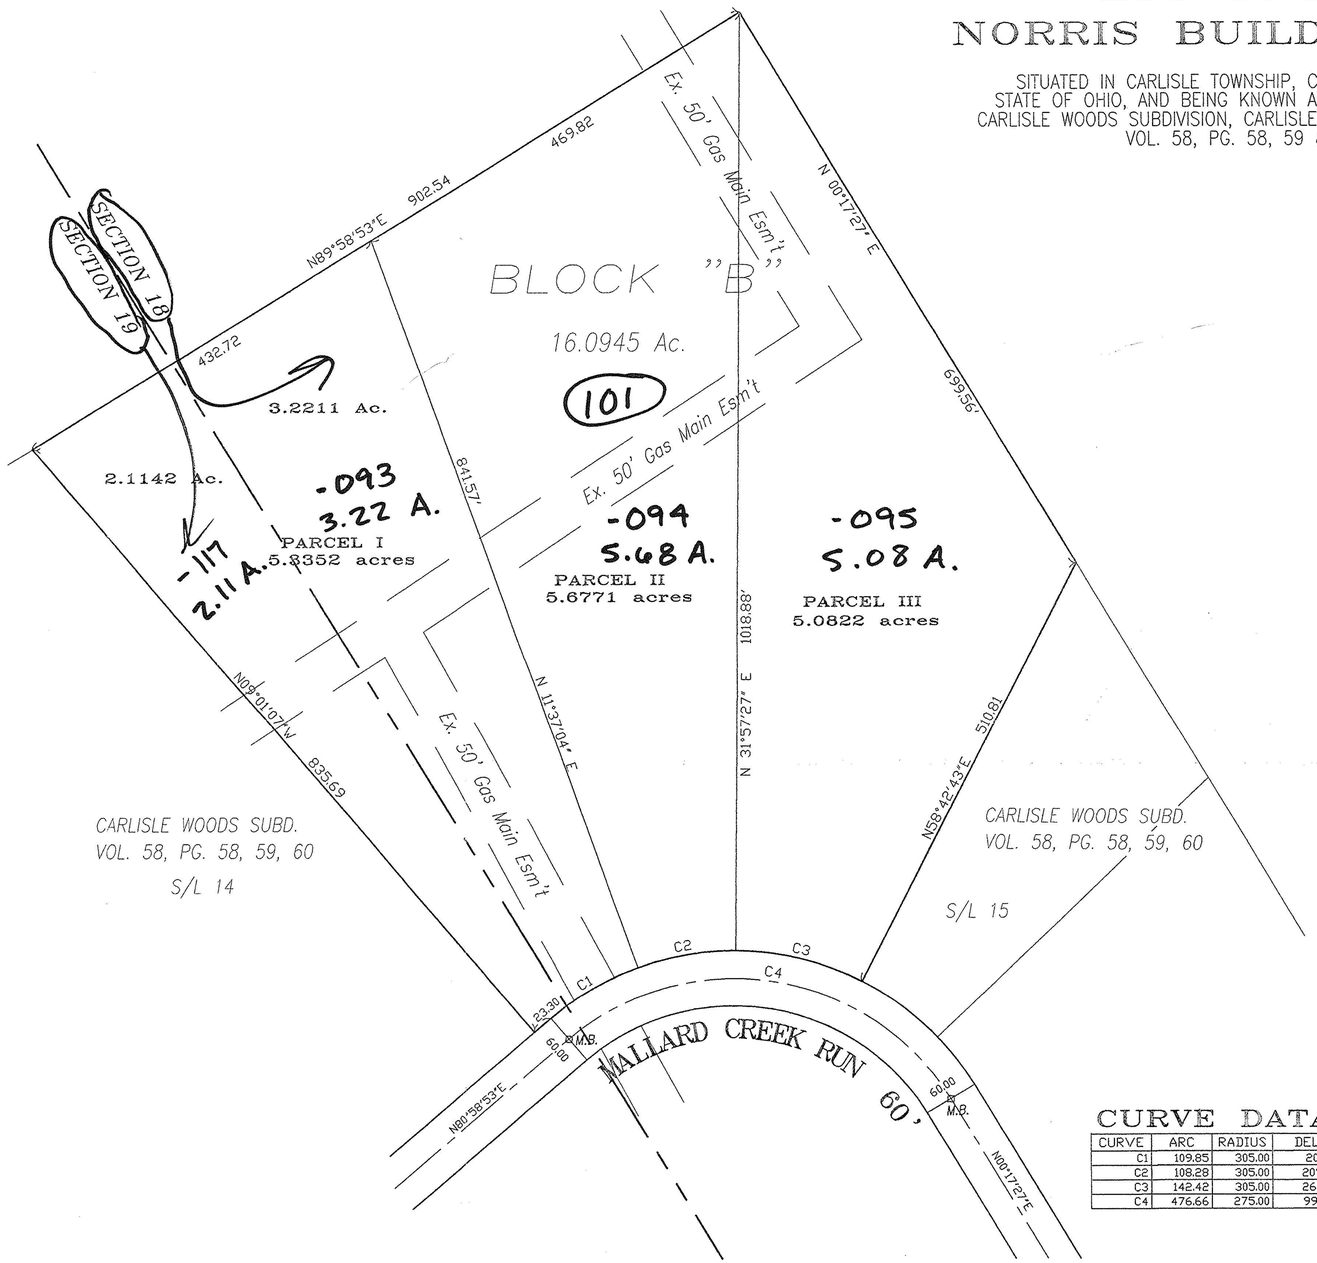

ACCEPTANCE

WE, THE UNDERSIGNED OWNERS OF THE LAND SHOWN ON THIS PLAT, DO HEREBY ACCEPT THIS SPLIT OF THE PARCELS SHOWN HEREON, AND DO HEREBY AGREE TO THE SAME.

_____
NORRIS BUILDERS, INC.
PRESIDENT DARRYL NORRIS

COUNTY OF CUYAHOGA
STATE OF OHIO S.S.

BEFORE ME, A NOTARY PUBLIC IN AND FOR SAID COUNTY AND STATE, DID PERSONALLY APPEAR THE ABOVE NAMED NORRIS BUILDERS, INC. BY DARRYL NORRIS, PRESIDENT, INDIVIDUALLY AND AS SUCH OFFICER THE FREE ACT AND DEED OF SAID CORPORATION WHO ACKNOWLEDGED THAT HE DID SIGN THE FOREGOING INSTRUMENT AND THAT THE SAME WAS HIS FREE WAS HIS FREE ACT AND DEED, IN WITNESS THEREOF I HAVE SET MY HAND AND
OFFICIAL SEAL AT _____, OHIO
THIS_____DAY OF _____, 2004.

_____
NOTARY PUBLIC
MY COMMISSION EXPIRES _____

№ 01615
APPROVED
LORAIN CO.
MAP DEPT.
DATE 4/2/04
PAGE 10-00-018-A
BY T. Spilman
PART #04-01615

CURVE DATA

CURVE	ARC	RADIUS	DELTA	TANGENT	CHORD	CHORD DIRECTION
C1	109.85	305.00	20°38'11"	55.52	109.26	N88°42'02"W
C2	108.28	305.00	20°20'24"	54.71	107.71	N68°12'45"W
C3	142.42	305.00	26°45'19"	72.54	141.13	N44°39'54"W
C4	476.66	275.00	99°18'40"	323.76	419.19	N49°21'53"W

APPROVALS

THIS PLAT APPROVED BY THIS _____ DAY OF _____ 2004
BY THE DIRECTOR OF LORAIN COUNTY PLANNING COMMISSION FOR RECORDING PURPOSES.

_____
DIRECTOR LORAIN COUNTY PLANNING COMMISSION

CERTIFICATION

DIMENSIONS SHOWN ON THIS PLAT ARE EXPRESSED IN FEET AND DECIMAL PARTS THEREOF. ALL BEARINGS ARE TO AN ASSUMED MERIDIAN AND ARE USED TO INDICATE ANGLES ONLY. PERMANENT MONUMENTS WERE FOUND OR SET AT ALL POINTS INDICATED HEREON. ALL OF WHICH I CERTIFY TO BE CORRECT.

DATE: FEBRUARY 2004.

STATE OF OHIO JAMES A. RESAR 6361 REGISTERED SURVEYOR

JAMES A. RESAR, P.E., P.S.

REVISIONS

J.A.R. Engineering & Surveying, Inc.
CONSULTING ENGINEERS / SURVEYORS
24629 DETROIT ROAD WESTLAKE, OHIO 44145
Phone:(440)-871-8345
Proj. No.

LOT SPLIT
CARLISLE WOODS
MALLARD CREEK RUN
CARLISLE TOWNSHIP, OHIO

1/1
02/04