10-00-006-120-

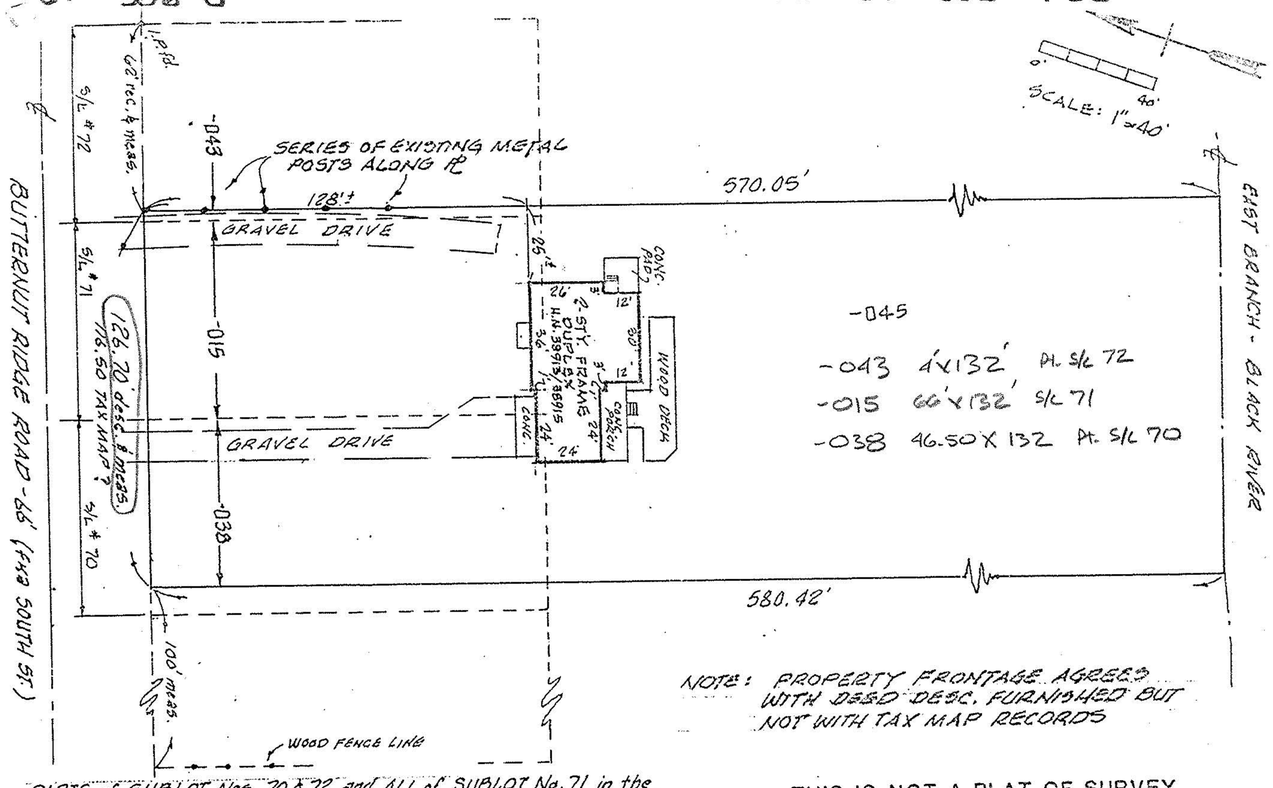

NOTE: PROPERTY FRONTAGE AGREES WITH DEED DESC. FURNISHED BUT NOT WITH TAX MAP RECORDS

PARTS of SUBLOT Nos. 70 & 72 and ALL of SUBLOT No. 71 in the TOWN PLAT of LAPORTE - PLAT VOL. J, Pg. 244; PLUS
PART of ORIG. CARLISLE TWP. SECTION No. 6
LORAIN COUNTY OHIO
PP Nos. 10-00-006-120-015; -038; -043 & -045

THIS IS NOT A PLAT OF SURVEY
FOR MORTGAGE LOAN PURPOSES ONLY

K. E. McCARTNEY & ASSOCIATES
SEPT. 17, 1991 #913664
MID. T. #10-30939-E

P.P. NO. 10-00-006-120-045,038	
SPLIT # 19552-A	**DATE OF SURVEY** OCT. '91
MAP PAGE 10-00-006-G	
SURVEYOR RODGER G. SIMON	

LAUNDON . SIMON . CAHL & ASSOC. INC.
CONSULTING ENGINEERS & SURVEYORS
ELYRIA, OHIO 44035

SURVEY FOR: SUZANNE E. VANEK

Orig. Lot	City of	Date OCT. '91 Scale 1"= 100'
Orig. Sec 6	Village of	Dwn. by R.G.S. Chkd. by R.C.
Tract	County of LORAIN	Job No. 91-2105 F.B. 221 P. 77
Township of CARLISLE	State of OHIO	Printed OCT 15 1991

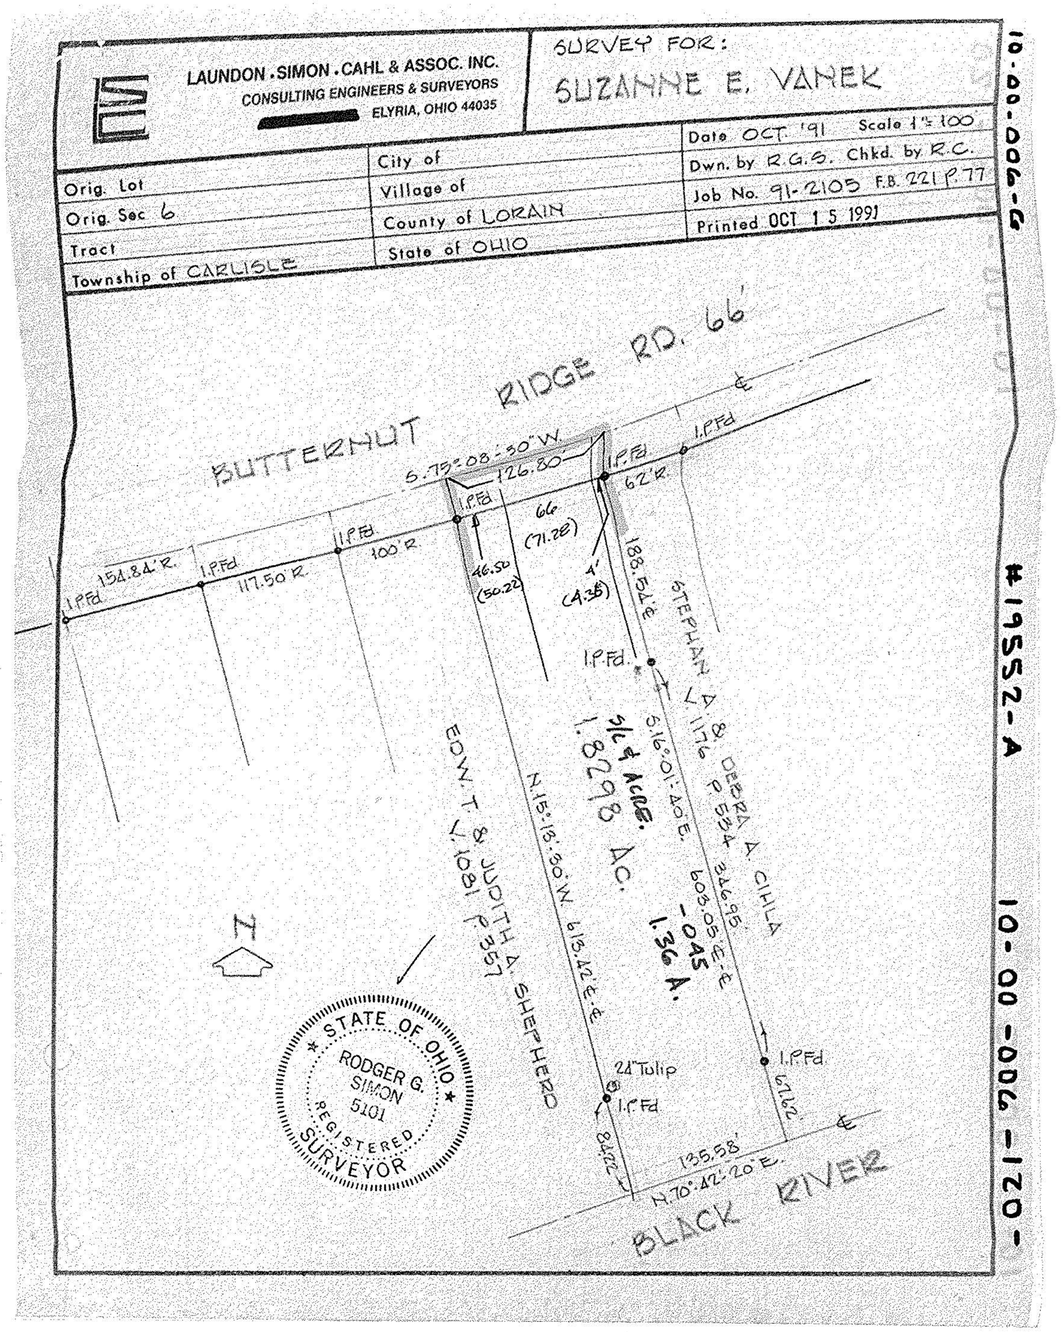

10-00-006-120-

#19552-A