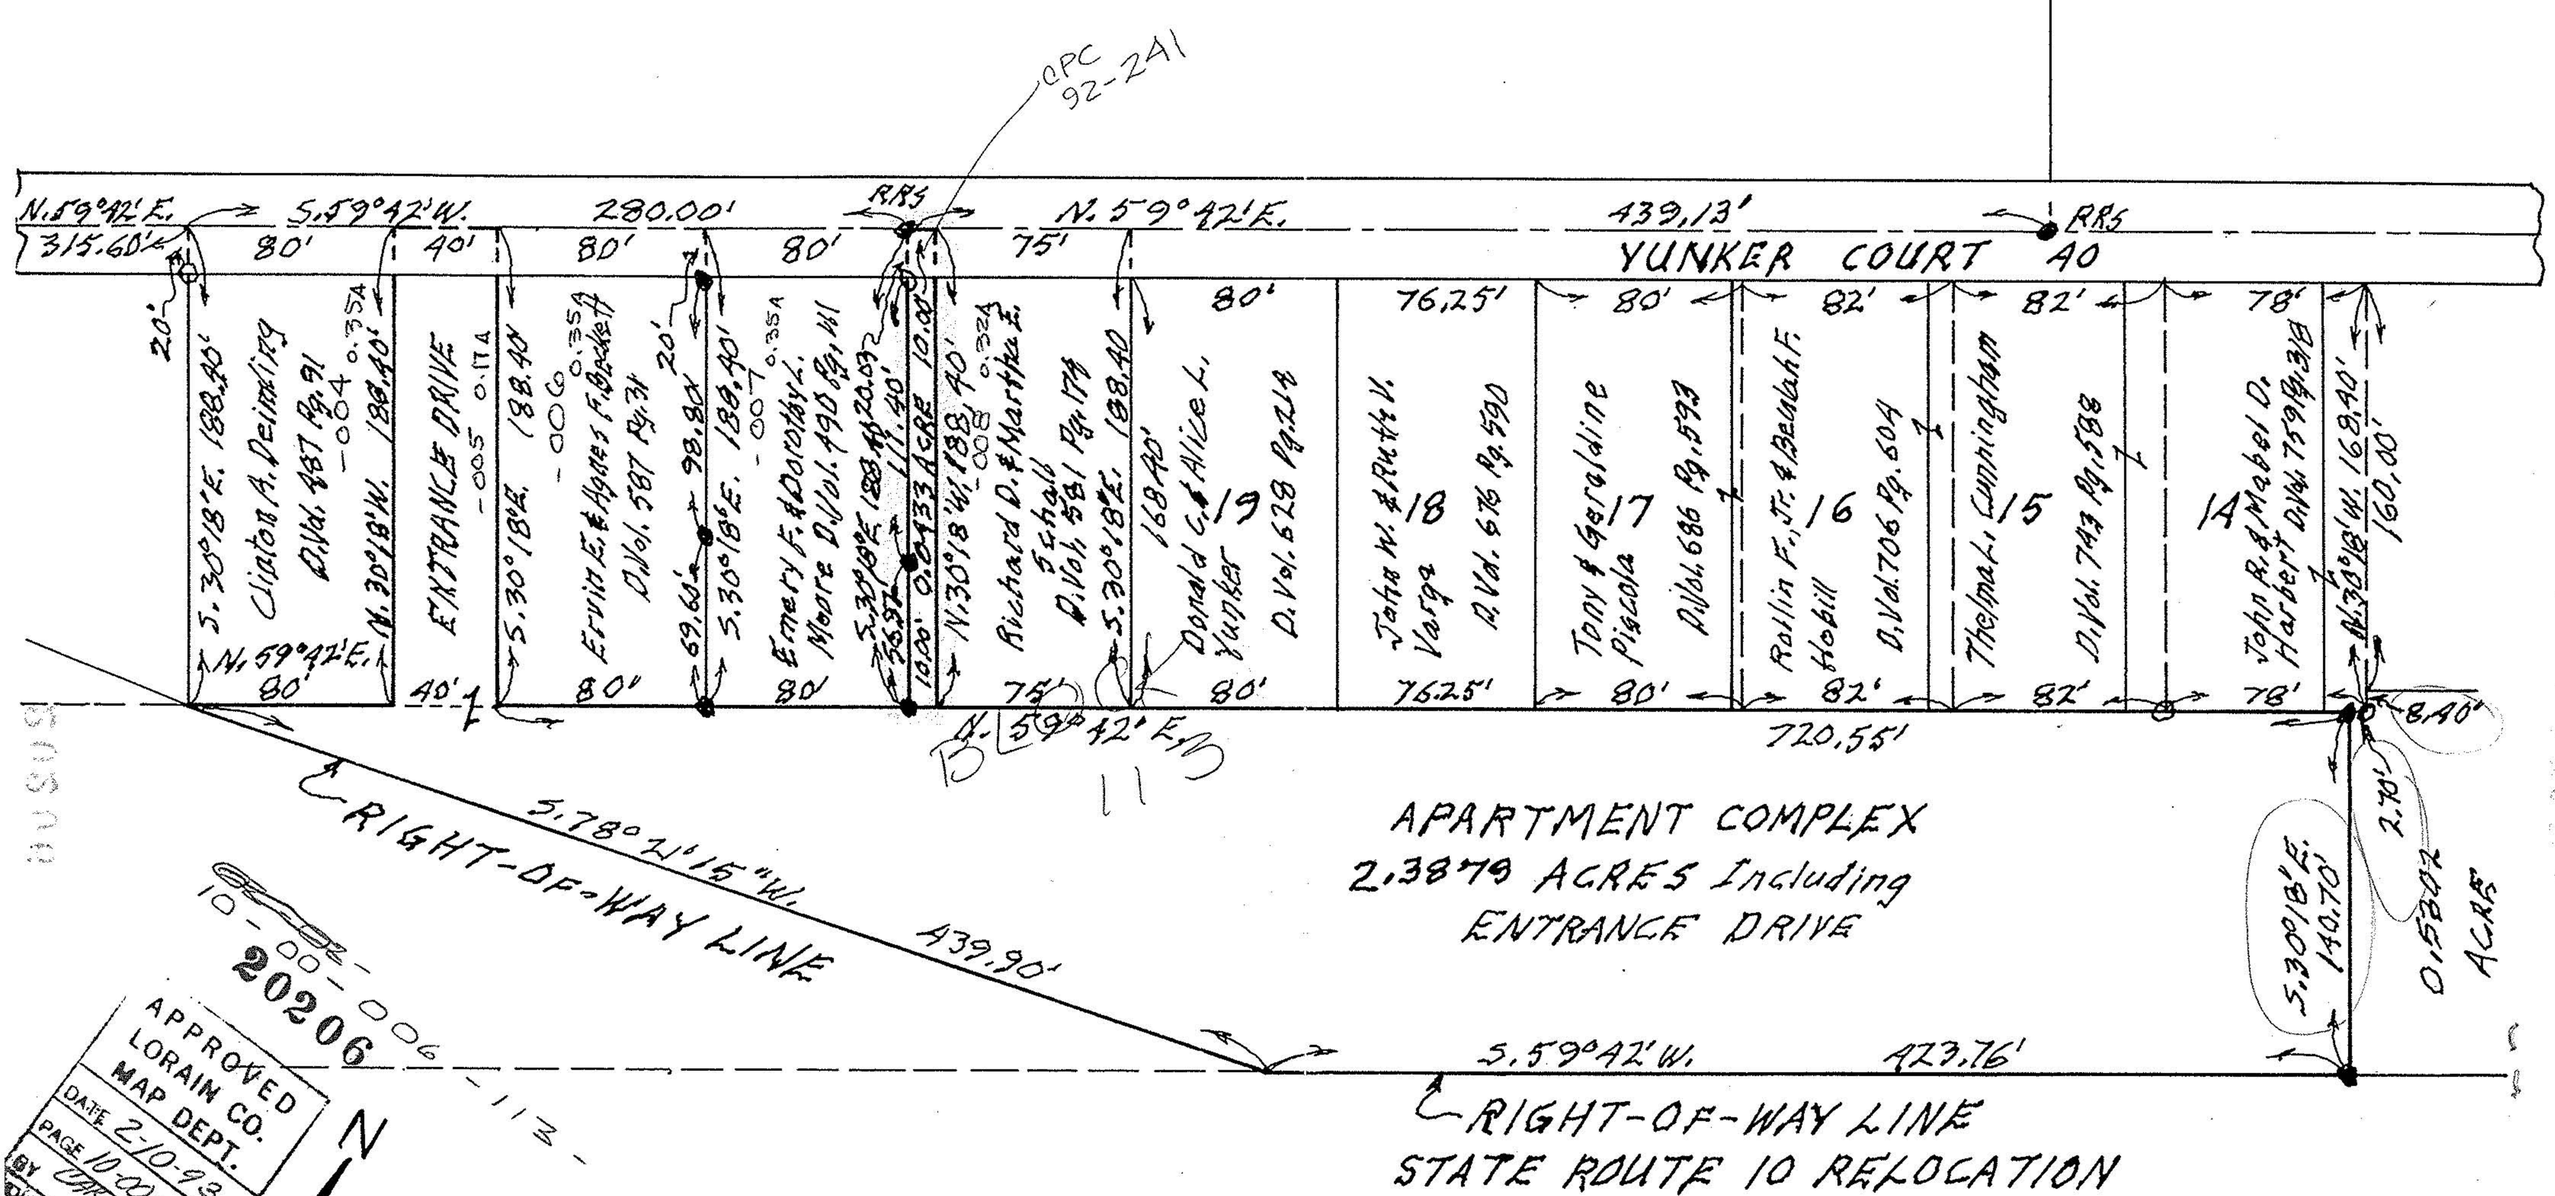

NOTES: o indicates 1" diameter iron pin found.
● indicates 1" diameter iron pin set, unless designated as railroad spike.

SURVEYING FOR DONALD C. & ALICE L. YUNKER
SECTION NO. 6 - CARLISLE TOWNSHIP
LORAIN COUNTY - OHIO
SCALE: 1" = 60'
Gary E. Penfound - Reg. Surveyor No. 4457