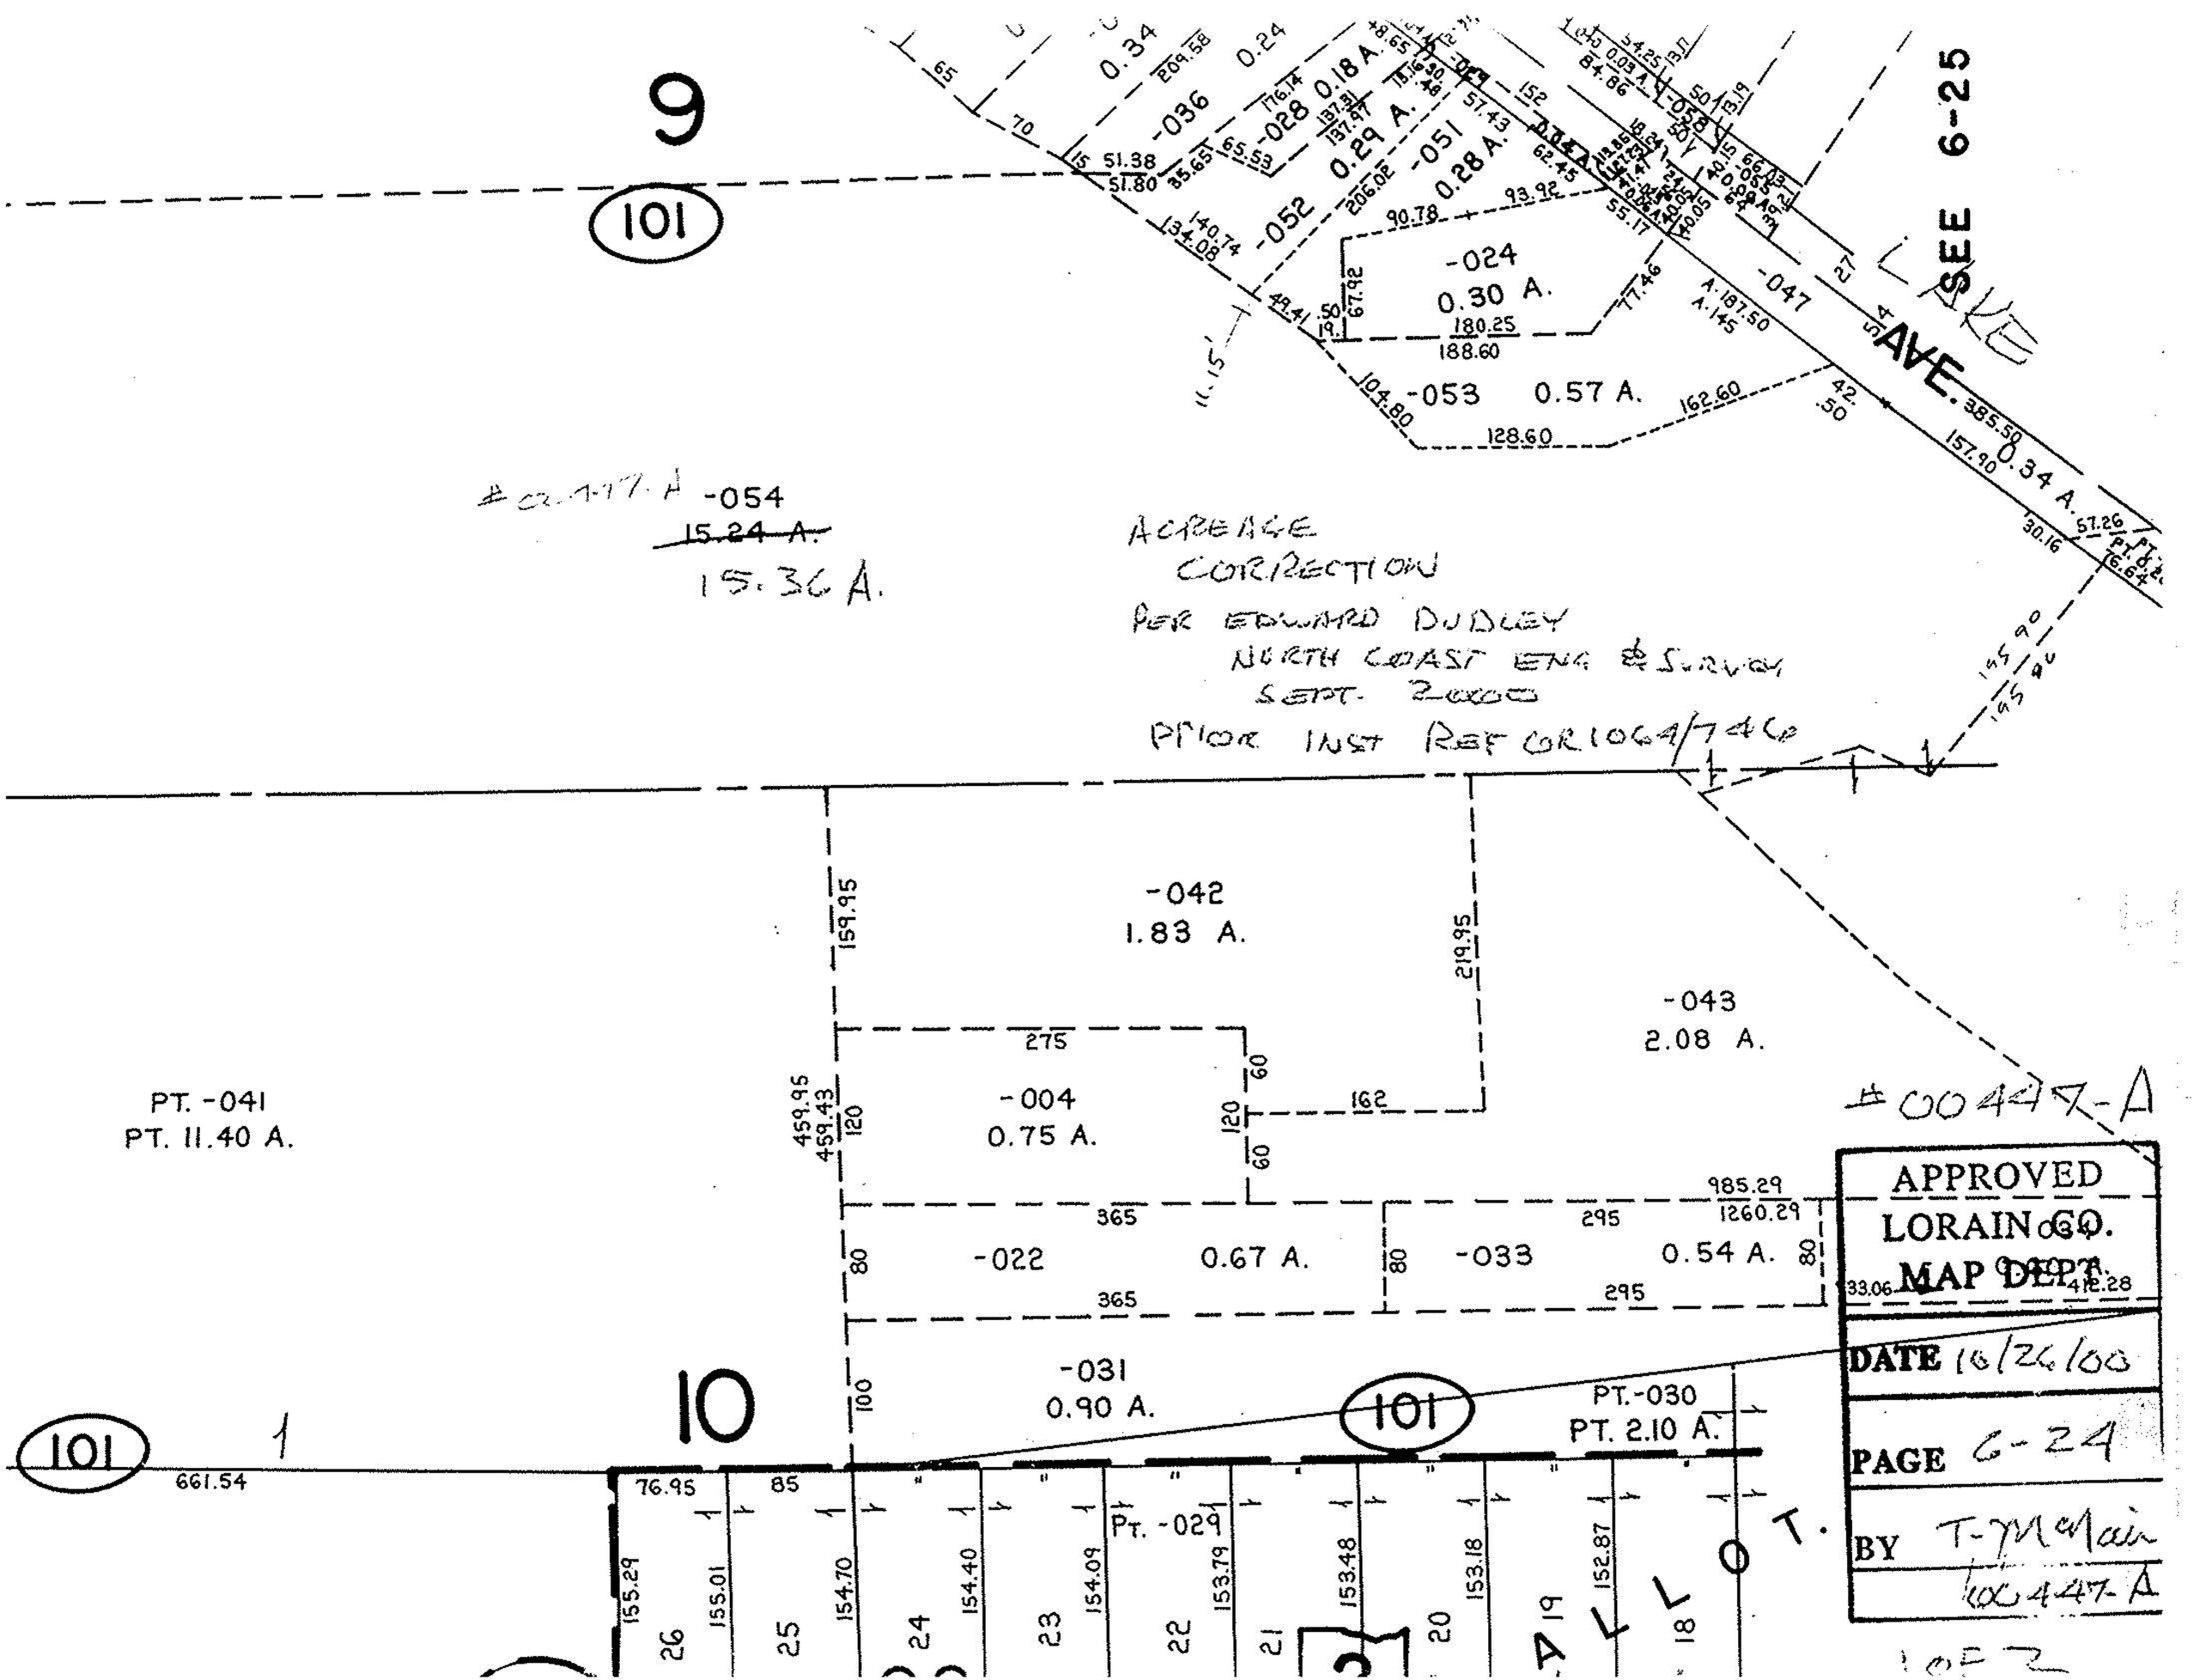

9
101
SEE 6-25
AVE.
-036
-028 0.18 A.
0.29 A.
-052
-051
0.28 A.
-024
0.30 A.
-053 0.57 A.
-047
0.34 A.
#00447-A -054
~~15.24 A.~~
15.36 A.
ACREAGE
CORRECTION
PER EDWARD DUDLEY
NORTH COAST ENG & SURVEY
SEPT. 2000
PRIOR INST REF OR1064/746
-042
1.83 A.
-043
2.08 A.
PT. -041
PT. 11.40 A.
-004
0.75 A.
#00447-A
-022
0.67 A.
-033
0.54 A.
-031
0.90 A.
10
101
PT.-030
PT. 2.10 A.
PT. -029
ALLOT.
APPROVED
LORAIN CO.
MAP DEPT.
DATE 10/26/00
PAGE 6-24
BY T-McMain
00447-A
1 OF 2