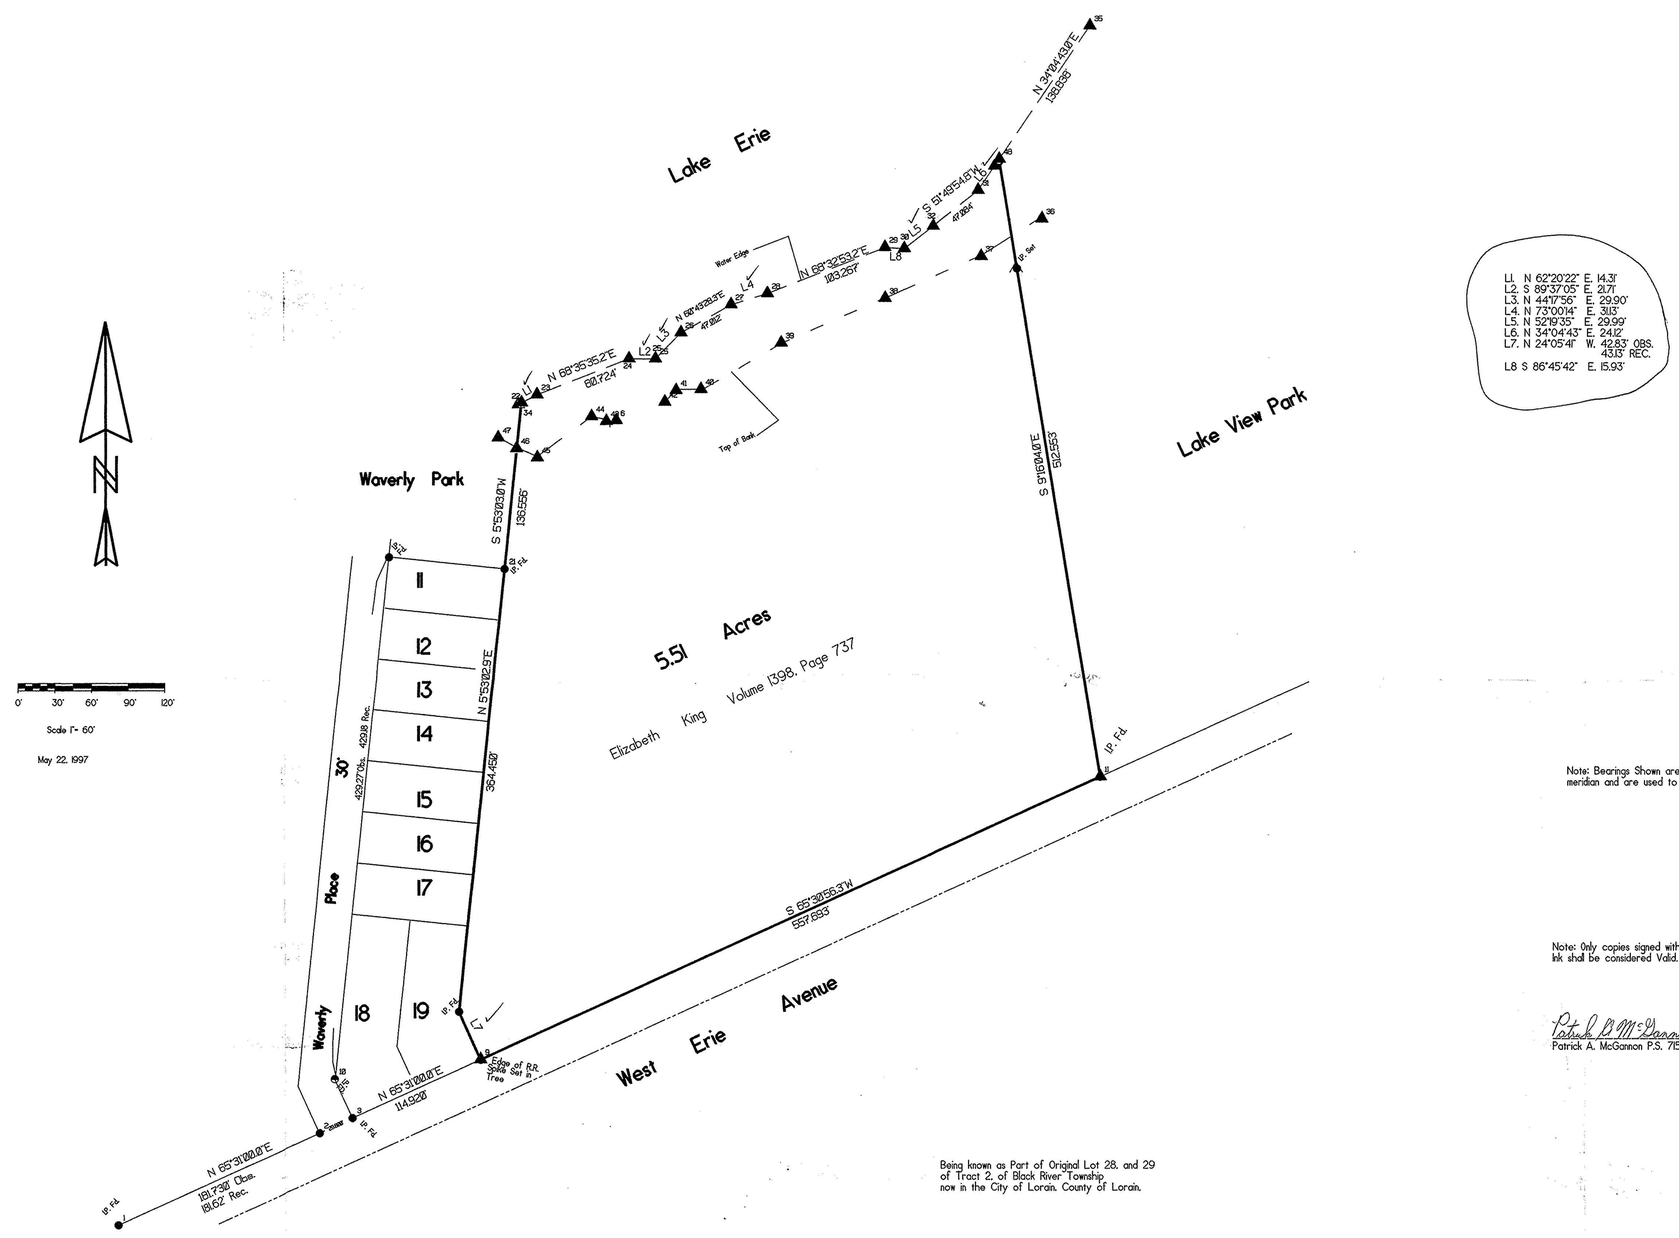

Being known as Part of Original Lot 28, and 29 of Tract 2, of Black River Township now in the City of Lorain, County of Lorain.

Note: Bearings Shown are to an assumed meridian and are used to describe angles only.

Note: Only copies signed with Red Ink shall be considered Valid.

Patrick A. McGannon P.S. 7154

REV. MAP. 3/30/01

Boundary Survey
City of Lorain Engineering Department " Elizabeth King Property "

STATE OF OHIO
PATRICK A. McGANNON
7154
REGISTERED
PROFESSIONAL SURVEYOR

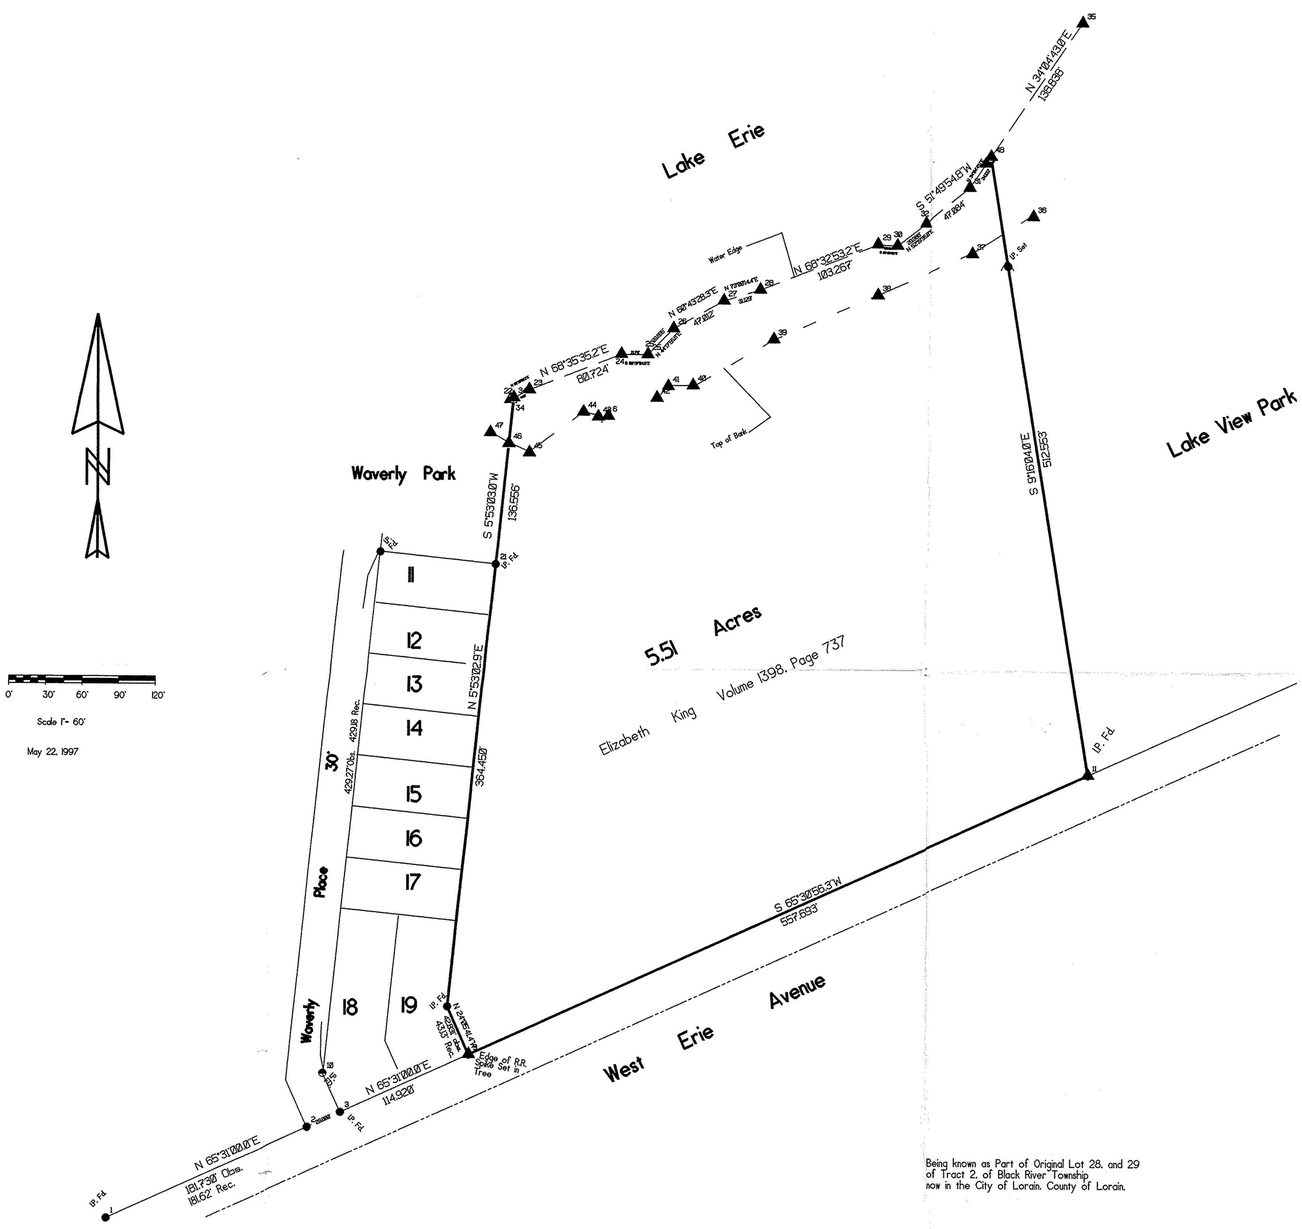

Being known as Part of Original Lot 28, and 29 of Tract 2, of Black River Township now in the City of Lorain, County of Lorain.

Note: Bearings Shown are to an assumed meridian and are used to describe angles only.

Note: Only copies signed with Red Ink shall be considered Valid.

Patrick A. McGannon P.S. 7154

FIRST COPY 3/6/01

Boundary Survey
City of Lorain Engineering Department " Elizabeth King Property "

STATE OF OHIO
PATRICK A. McGANNON
7154
REGISTERED
PROFESSIONAL SURVEYOR