KS ASSOCIATES, INC.
424 Middle Ave. P.O. Box 89
ELYRIA, OHIO 44036
(216) 322-6317

JOB TENNYSON AVE 97267

SHEET NO. OF

CALCULATED BY DATE

CHECKED BY DATE 9-22-97
REV. 10-16-98
REV. 11-17-98

SCALE 1" = 50'

SURVEY MAP
OF PART OF
SHEFFIELD TOWNSHIP
ORIGINAL LOT NO. 40

CITY OF SHEFFIELD LAKE
COUNTY OF LORAIN
STATE OF OHIO

SURV. 10-16-98

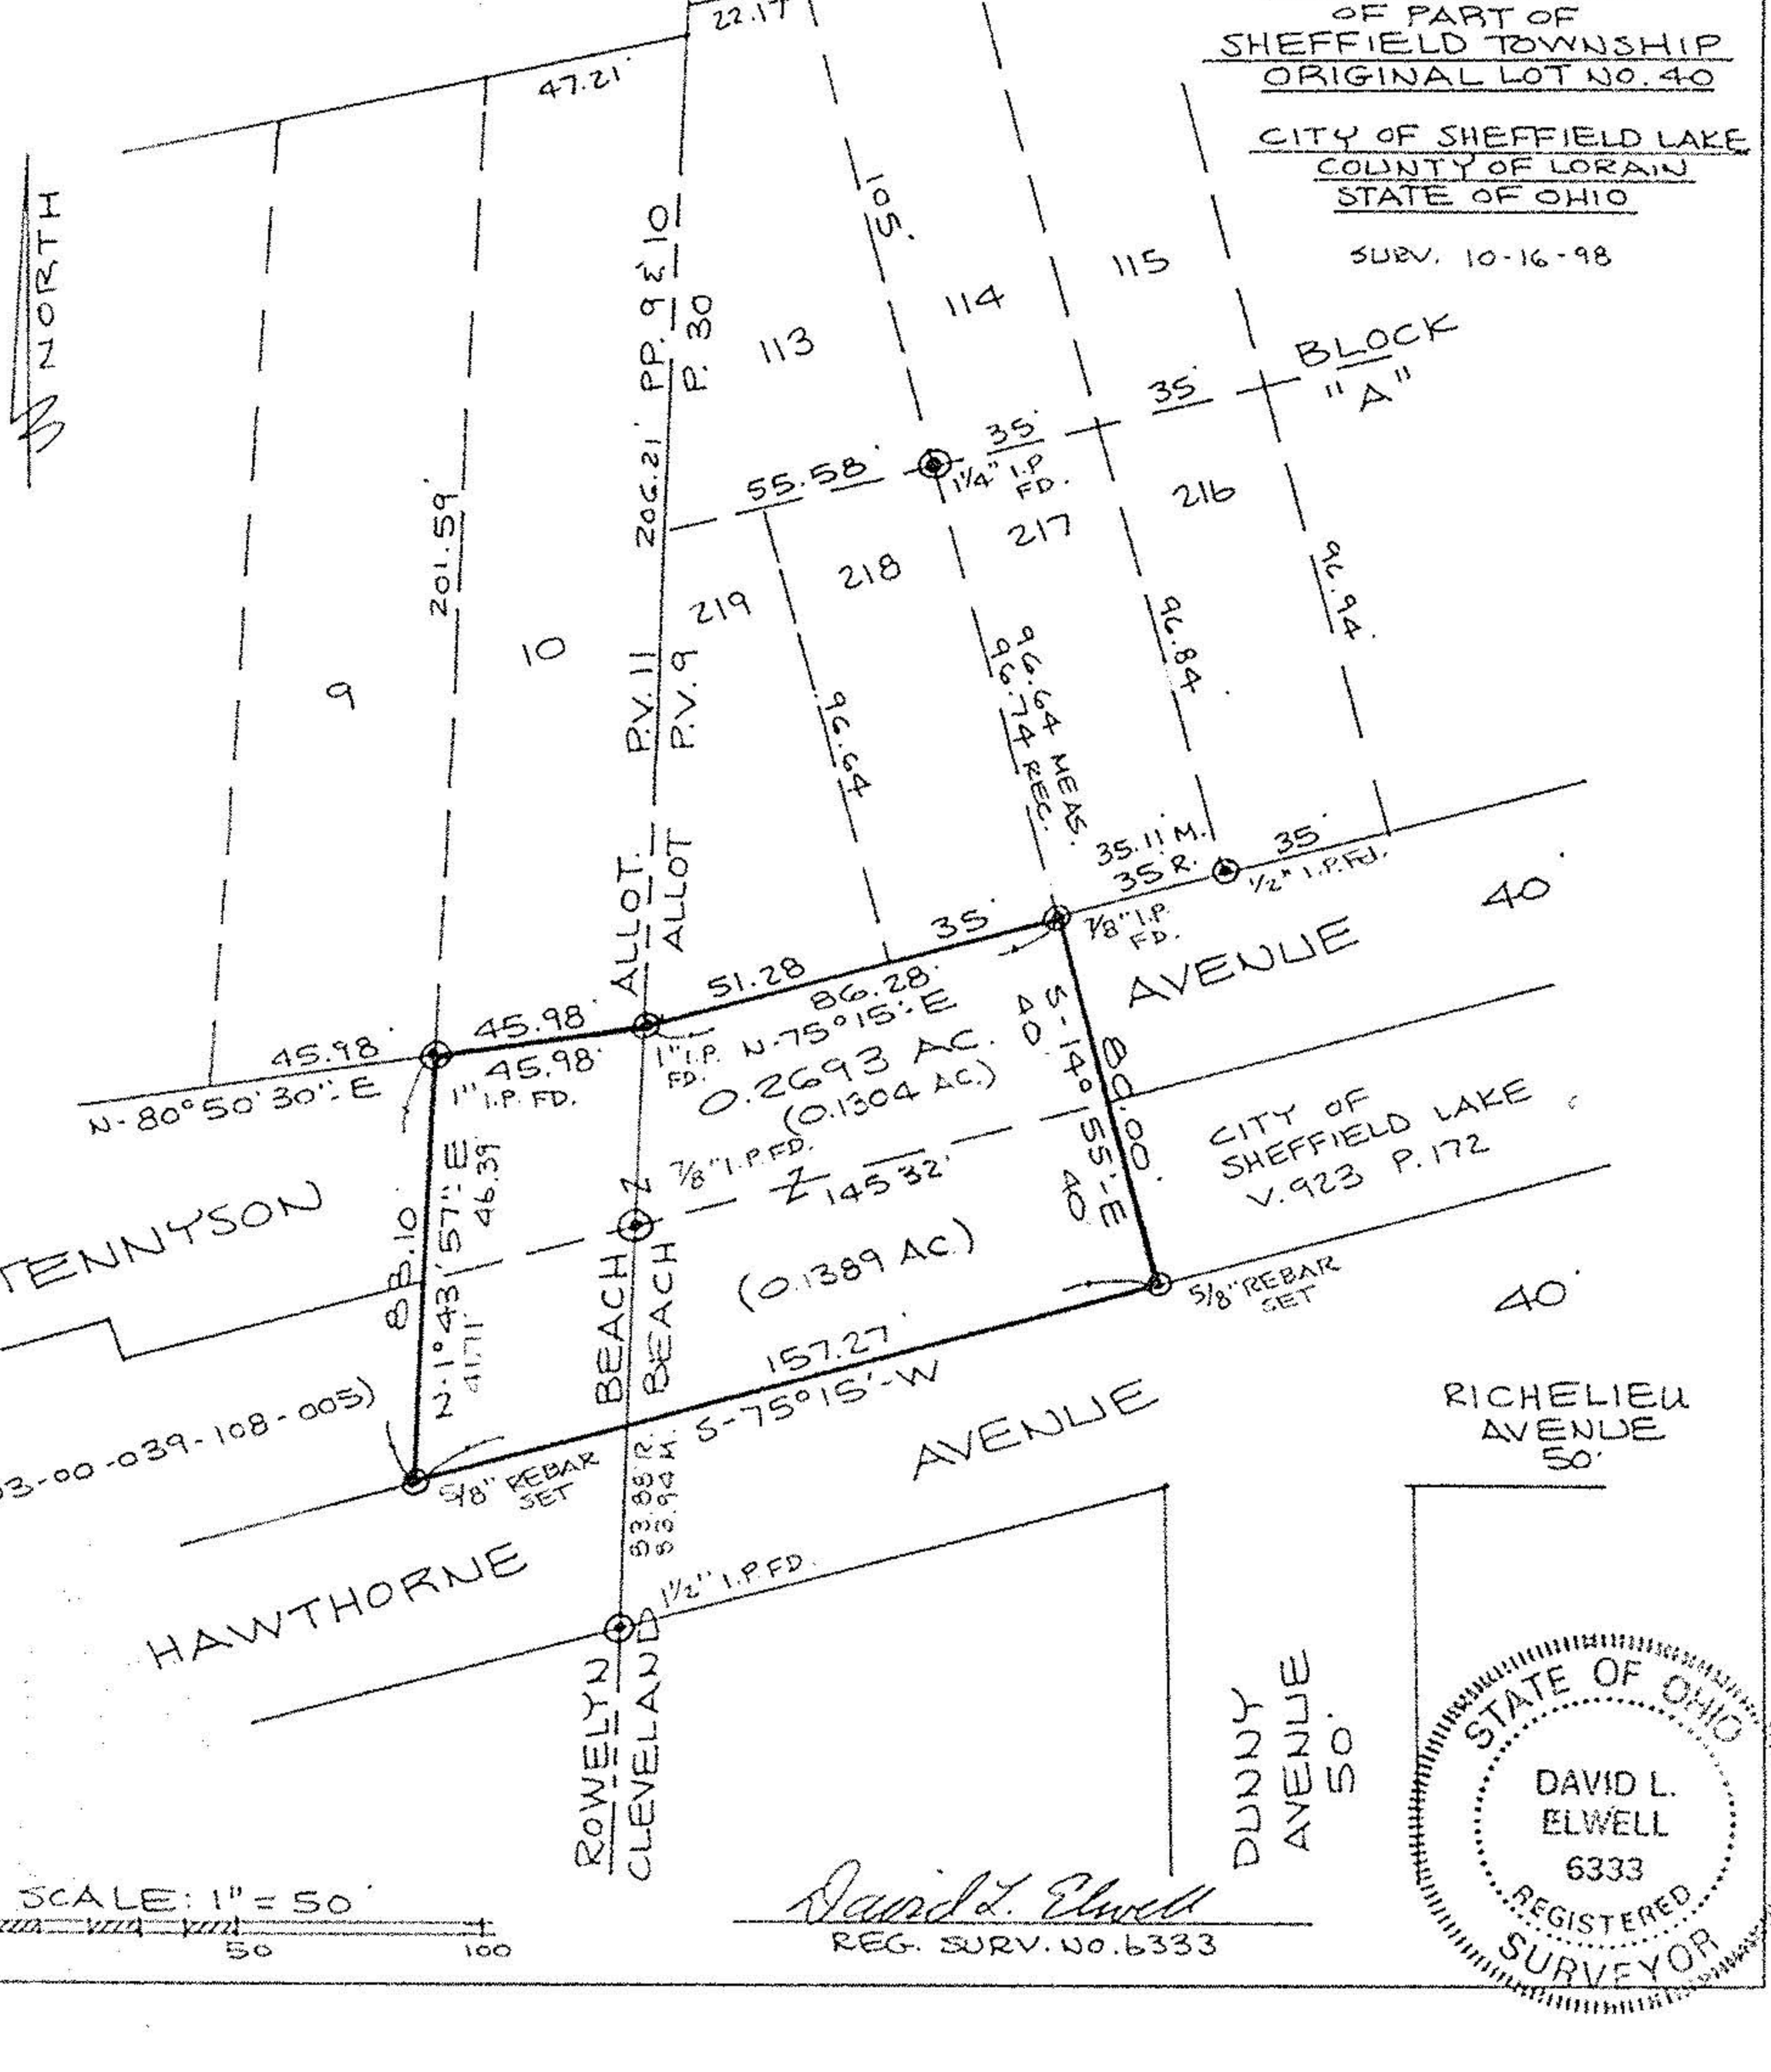

SCALE: 1" = 50'
0 50 100

David L. Elwell
REG. SURV. NO. 6333

STATE OF OHIO
DAVID L. ELWELL
6333
REGISTERED SURVEYOR