

N 89°04'00" E 1875.17 (OBS.) 1875.32 (REC.)
584.30

66.00 (REC. & MSD.)

ESTATE OF NICHCLAS M. RALICH
PPN: 04-00-002-101-001
DOC. #970482485

886.90 (DEED)
886.99 (MSD.)

N 00°48'49" W 872.46
04-00-002-101-002
1.2007 ACRES
871.01

N 87°41'00" E 597.00
575.37

PPN:04-00-002-101-042
28.2226 ACRES
TOTAL

R=1456.70
D=13°54'17"
A=353.51
C=352.65
N 33°08'59" E

N 88°13'00" E 875.72 (MSD.)

PARCEL "A"
JOHN KRYSTOWSKI
PPN:04-00-002-101-078
6.6304 Ac.

R=1456.70
D=16°17'00"
A=413.99
C=412.60
S 48°14'37" W

1084.49 (MSD.)
S 89°00'00" W

PAUL & ANNA FARKAS
PPN:04-00-002-101-043
VOL. 1022, PG. 124

PAUL & ANNA FARKAS
PPN:04-00-002-101-015
VOL. 1022, PG. 124

S 89°00'00" W 405.40 (REC.)
402.59 (OBS.)


1695.10 (REC. & USED)

S 89°00'00" W 2163.69 (OBS. C/L TO TWP. LINE)


ANTONE & ANNA KRZYSTOWSKI
PPN:04-00-002-101-018
VOL. 155, PG. 551

APPROVED LORAIN CO. MAP DEPT
DATE 5-19-03
PAGE
BY D. Holland
No 00858-A

4-00-003E
4-00-002-A
3-L
3-00-004-A
3-00-014-B

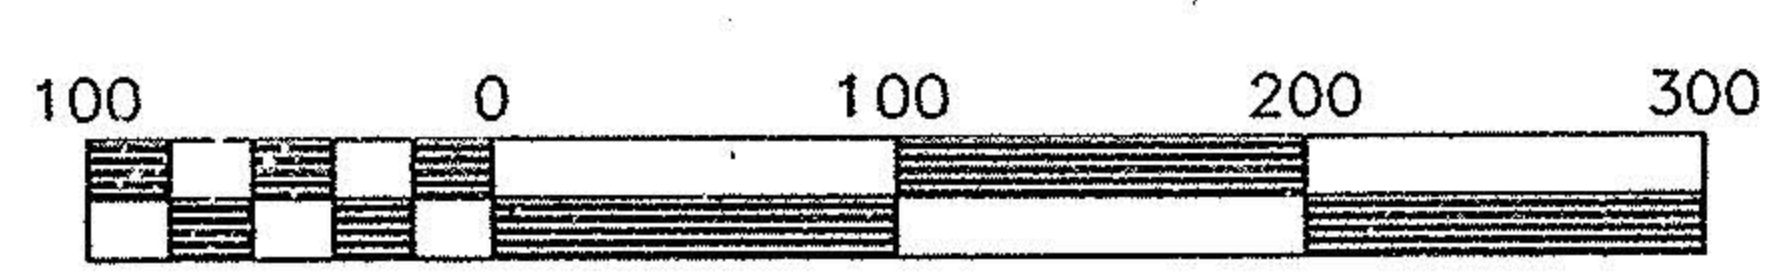

Scale 1" = 100'
MAY 9, 2003

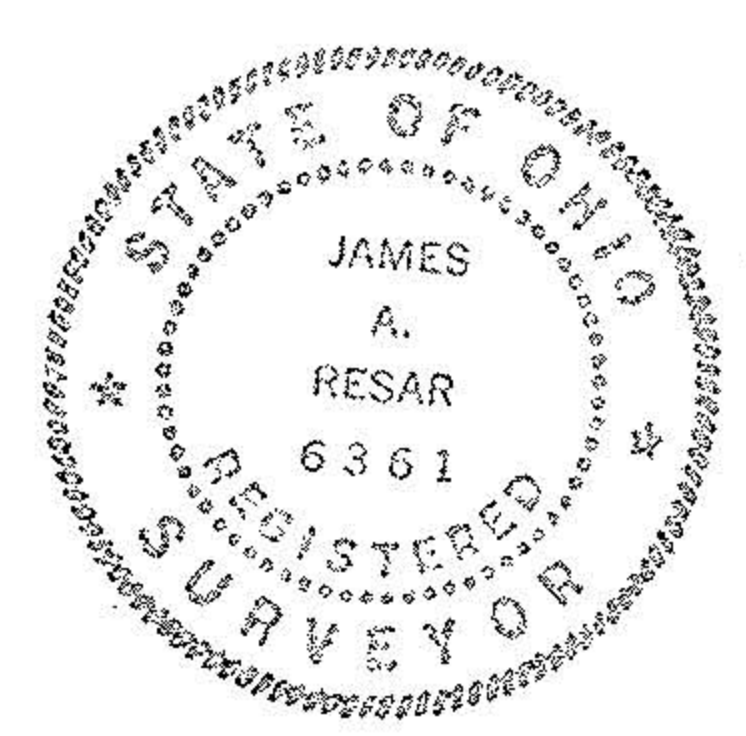

J.A.R. Engineering & Surveying, Inc.
CONSULTING ENGINEERS / SURVEYORS
24629 DETROIT ROAD WESTLAKE, OHIO 44145
Phone: (440)-871-8345

SURVEY MAP
JOHN C. KRYSTOWSKI
PPN: 04-00-002-101-012 & 04-00-002-101-002
AVON, OHIO

1
1
05/03