


02-01-002-103-008

2-01-003-A

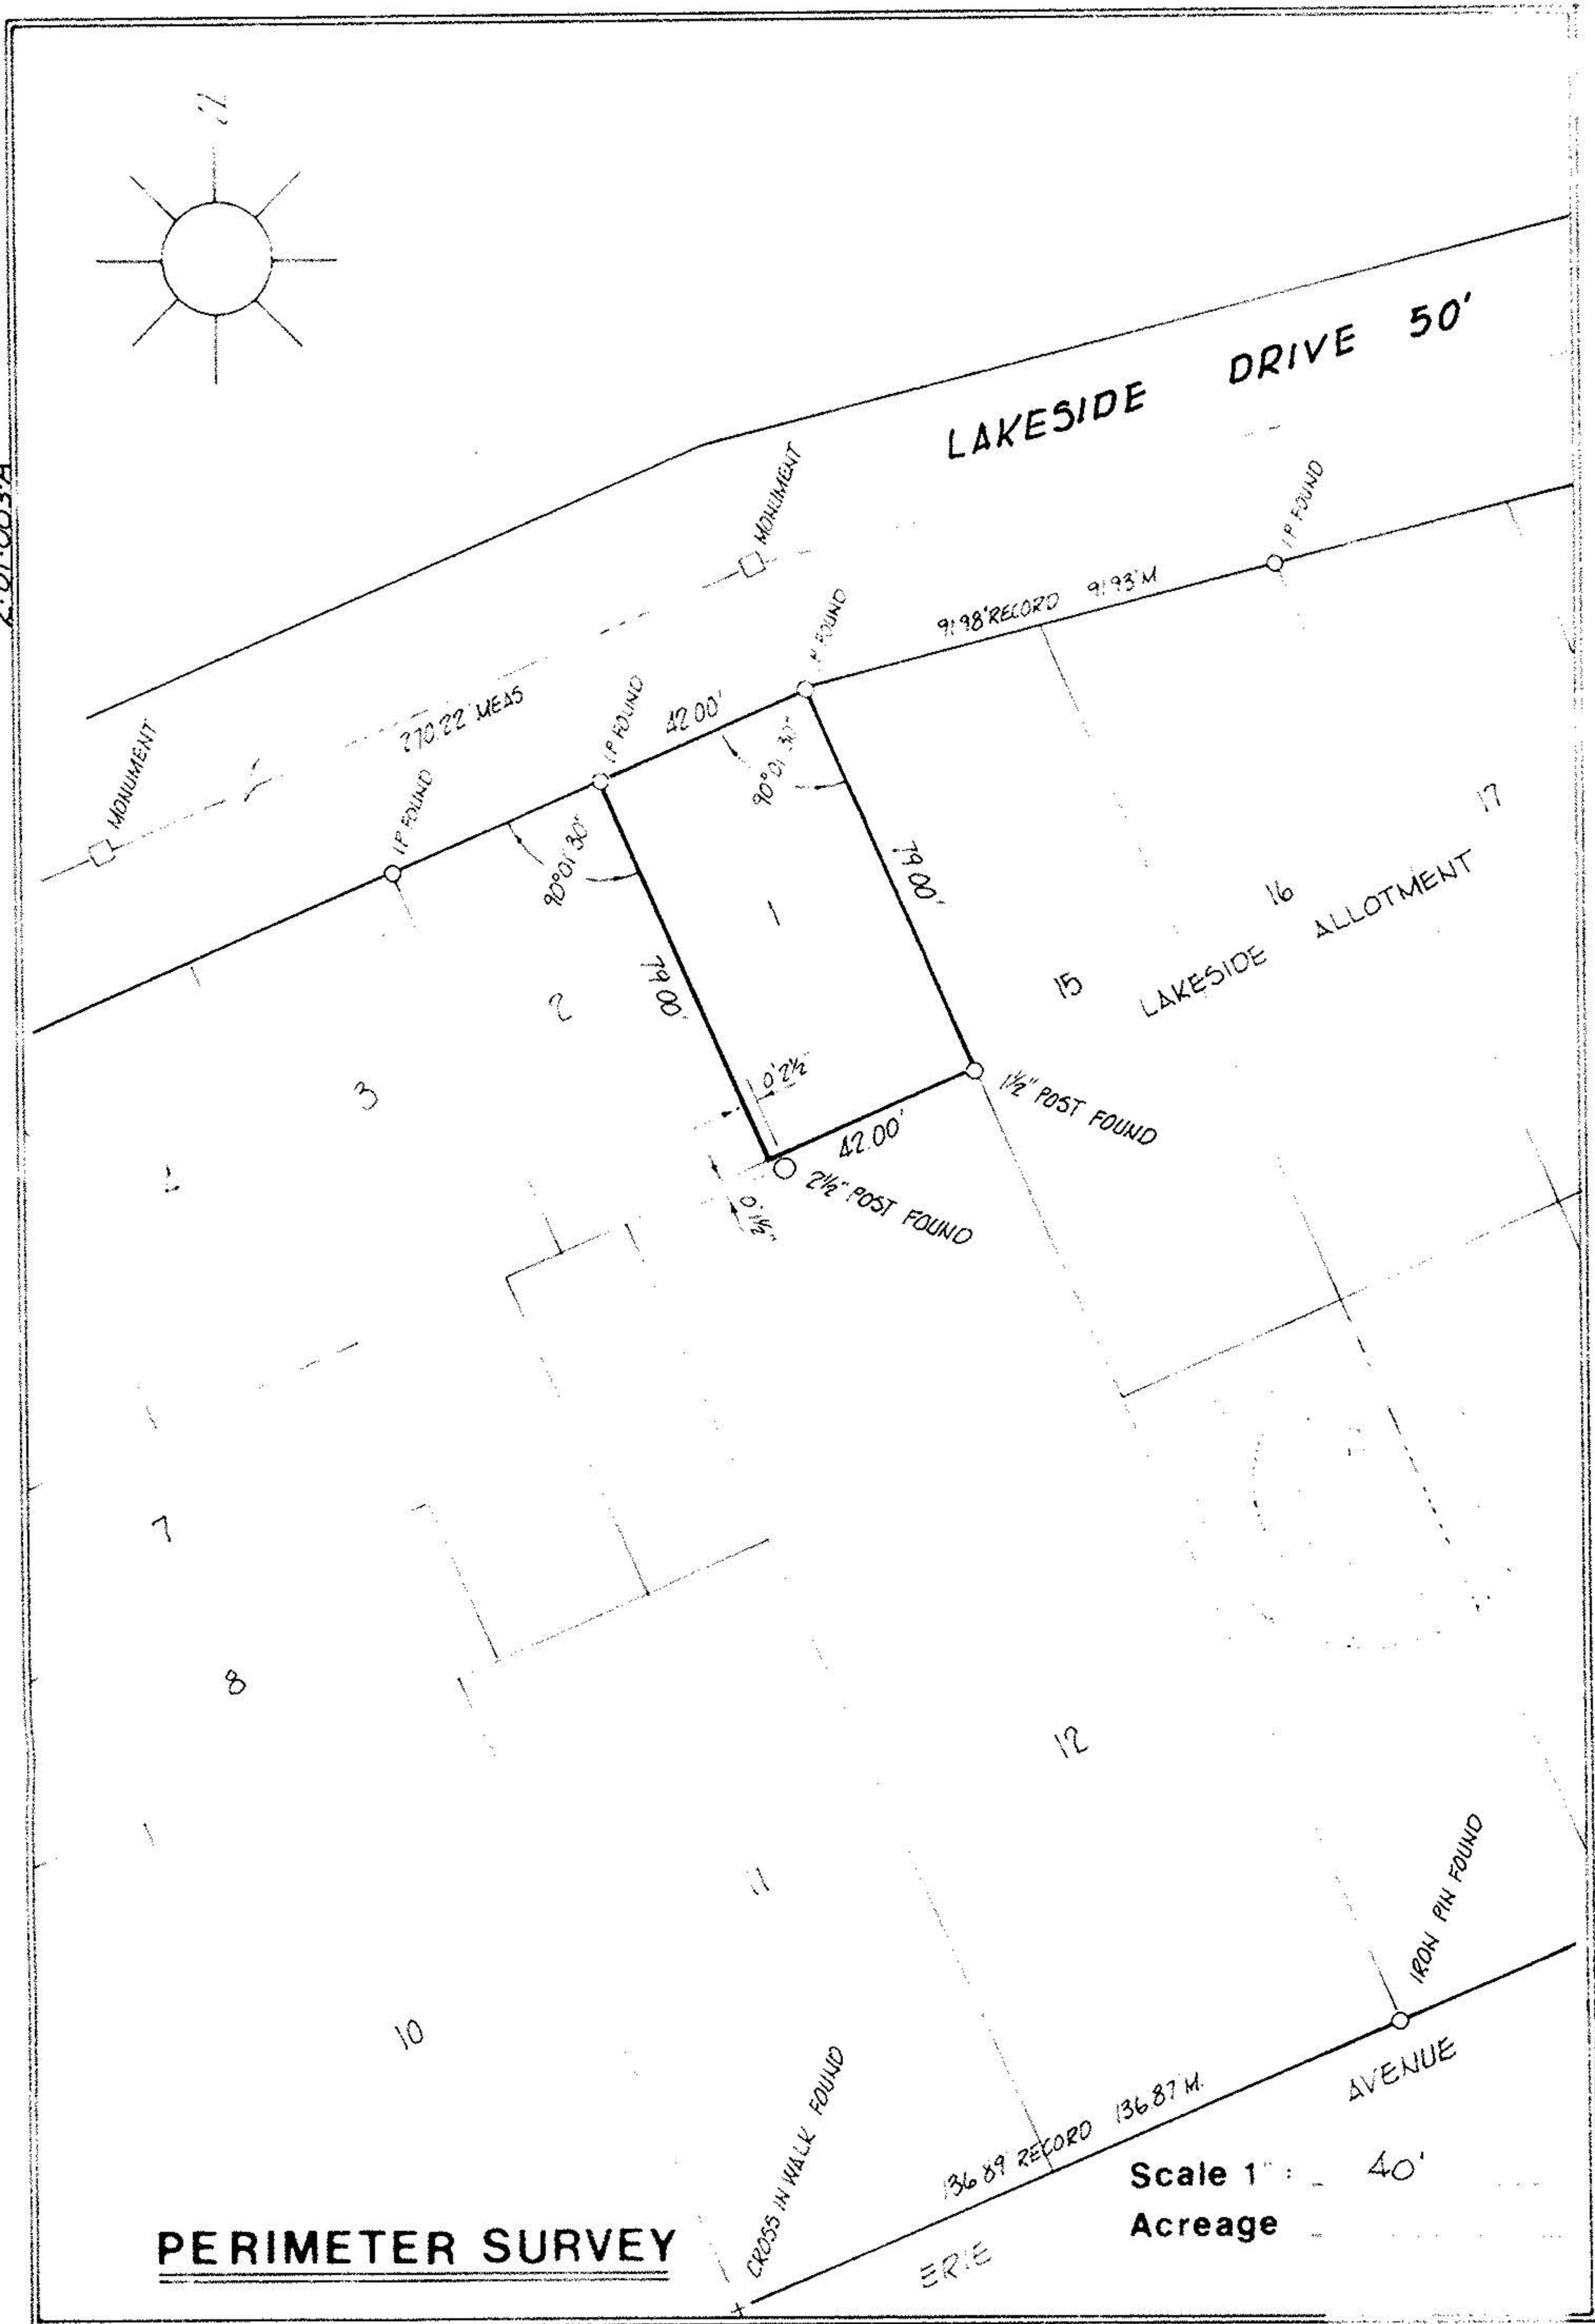

PERIMETER SURVEY

Scale 1" = 40'
Acreage

SUBLOT 1 of MOORE'S 5 PLAT
 Plat Vol 5 Page 20
 Part of O.L. 3 Section
 Tract BLACK RIVER TWP
 City of LORAIN
LORAIN Co., Ohio

Michael G. Hura & Associates
 4560 Liberty Ave. Vermilion, Ohio
 drawn par
 date 5 5 80
 scale 1" = 40'
 field book

PERMANENT
 PARCEL NUMBER
 02-01-003-103-008