# SURVEY
OF PART OF
## ORIGINAL RIDGEVILLE TWP. LOT NO. 27
CITY OF NORTH RIDGEVILLE COUNTY OF LORAIN
STATE OF OHIO

PREPARED BY:
HAPONEK & ASSOCIATES
SURVEYORS & ENGINEERS
N. RIDGEVILLE, OH

PREPARED FOR:
RAY SALISBURY
26043 REDWOOD DR.
OLMSTEAD FALLS, OH

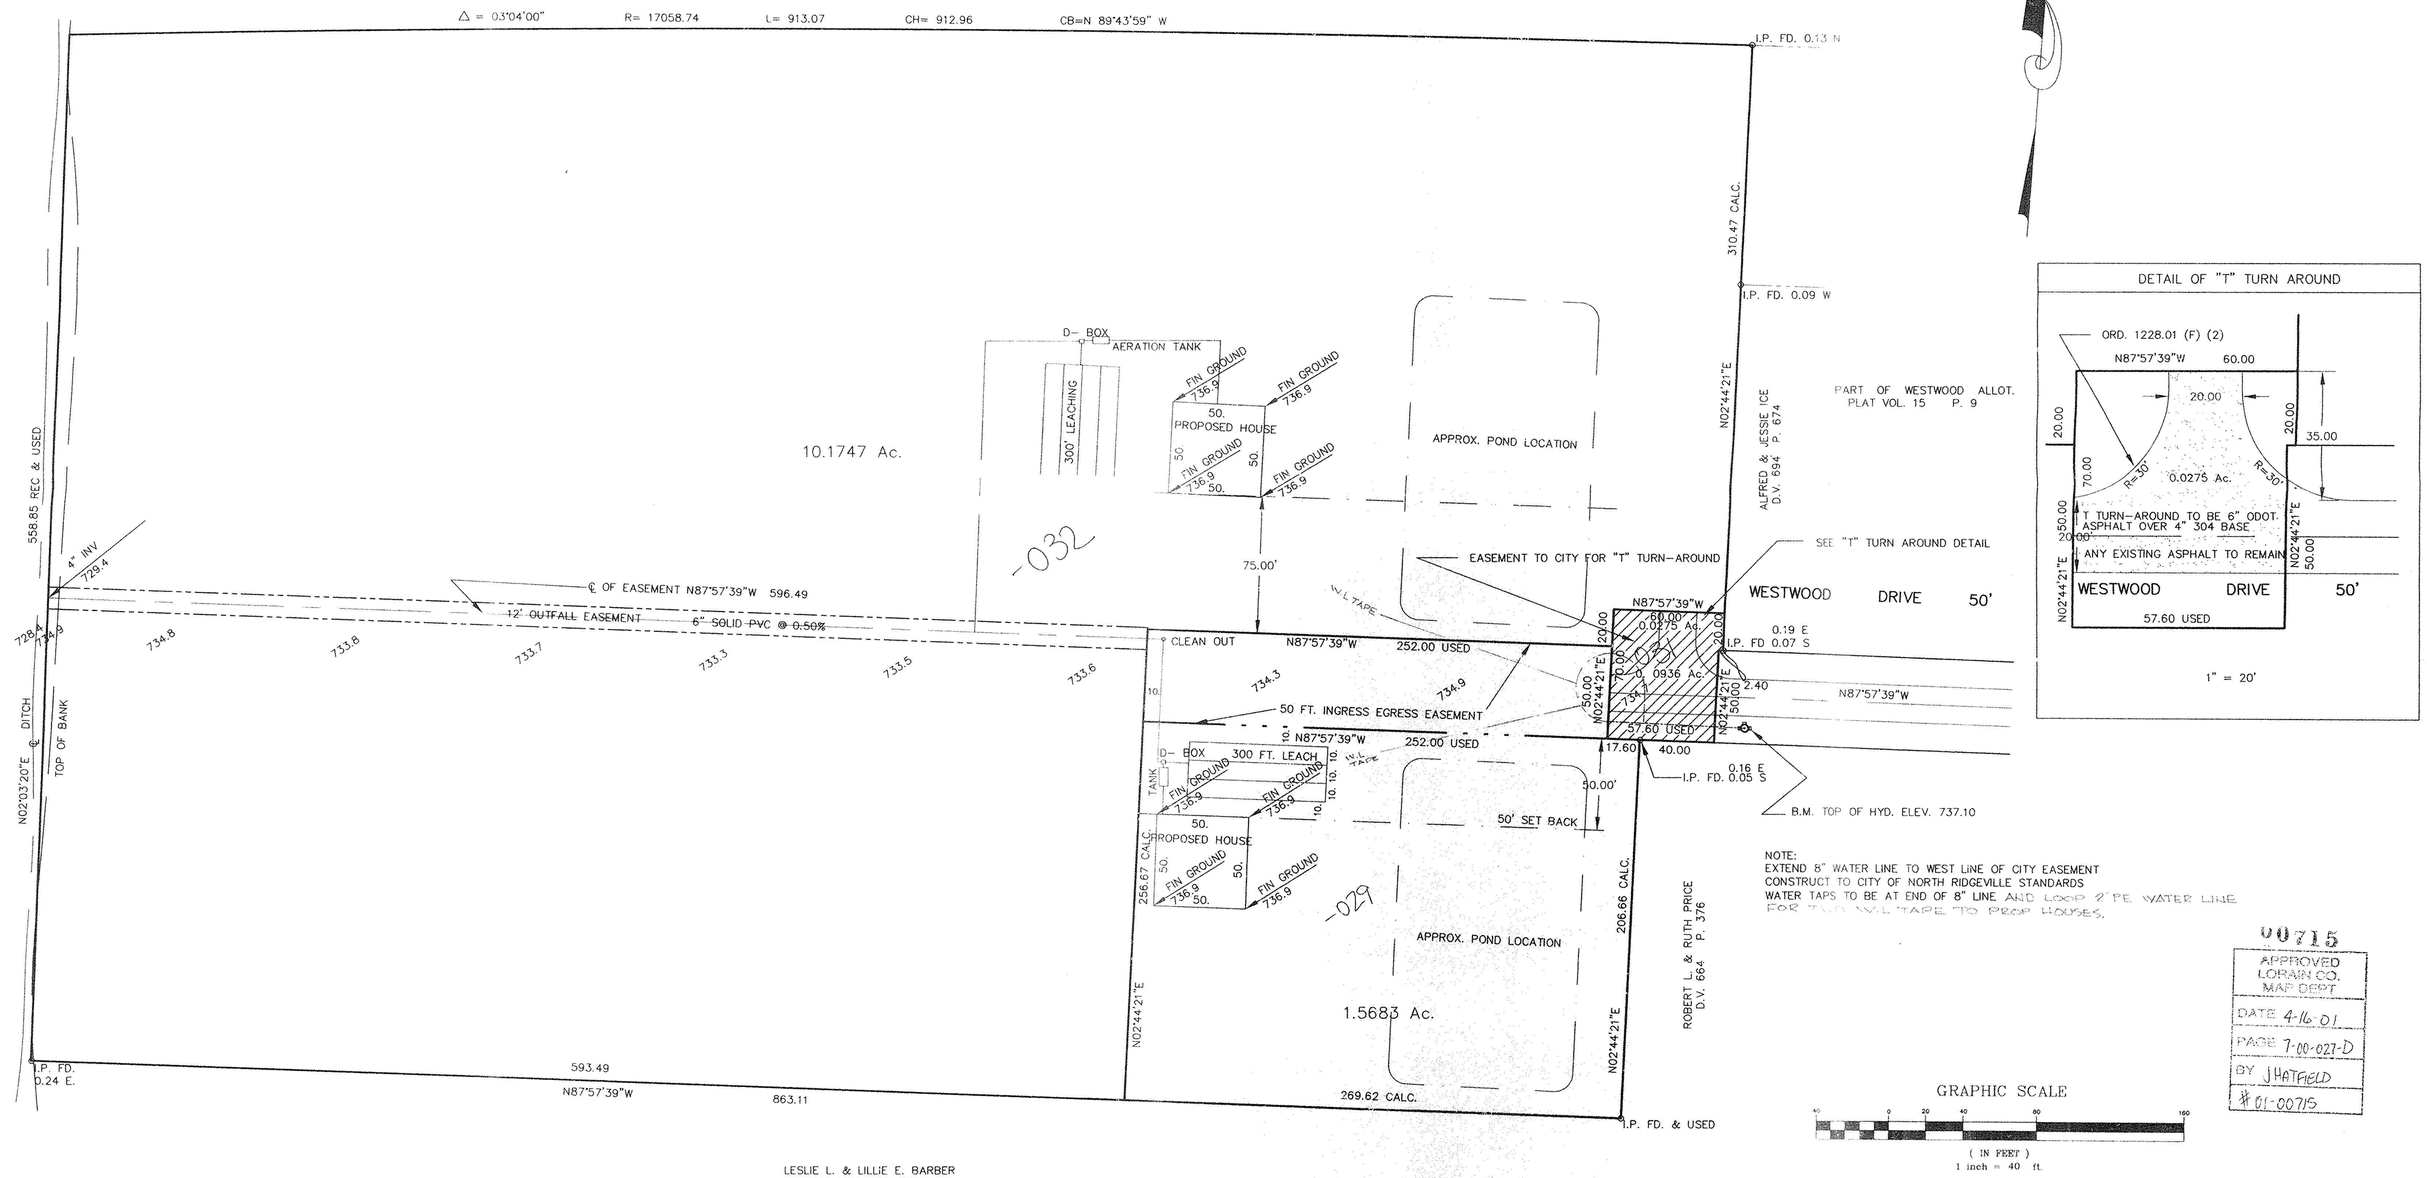


NOTE:
EXTEND 8" WATER LINE TO WEST LINE OF CITY EASEMENT
CONSTRUCT TO CITY OF NORTH RIDGEVILLE STANDARDS
WATER TAPS TO BE AT END OF 8" LINE AND LOOP 8" PE WATER LINE
FOR TWO W.L TAPS TO PROP HOUSES.

00715
APPROVED
LORAIN CO.
MAP DEPT.
DATE 4-16-01
PAGE 7-00-027-D
BY J HATFIELD
# 01-00715

REVISED APRIL 12, 2001
REVISED: JAN. 9, 2001
REVISED: DEC. 26, 2000