
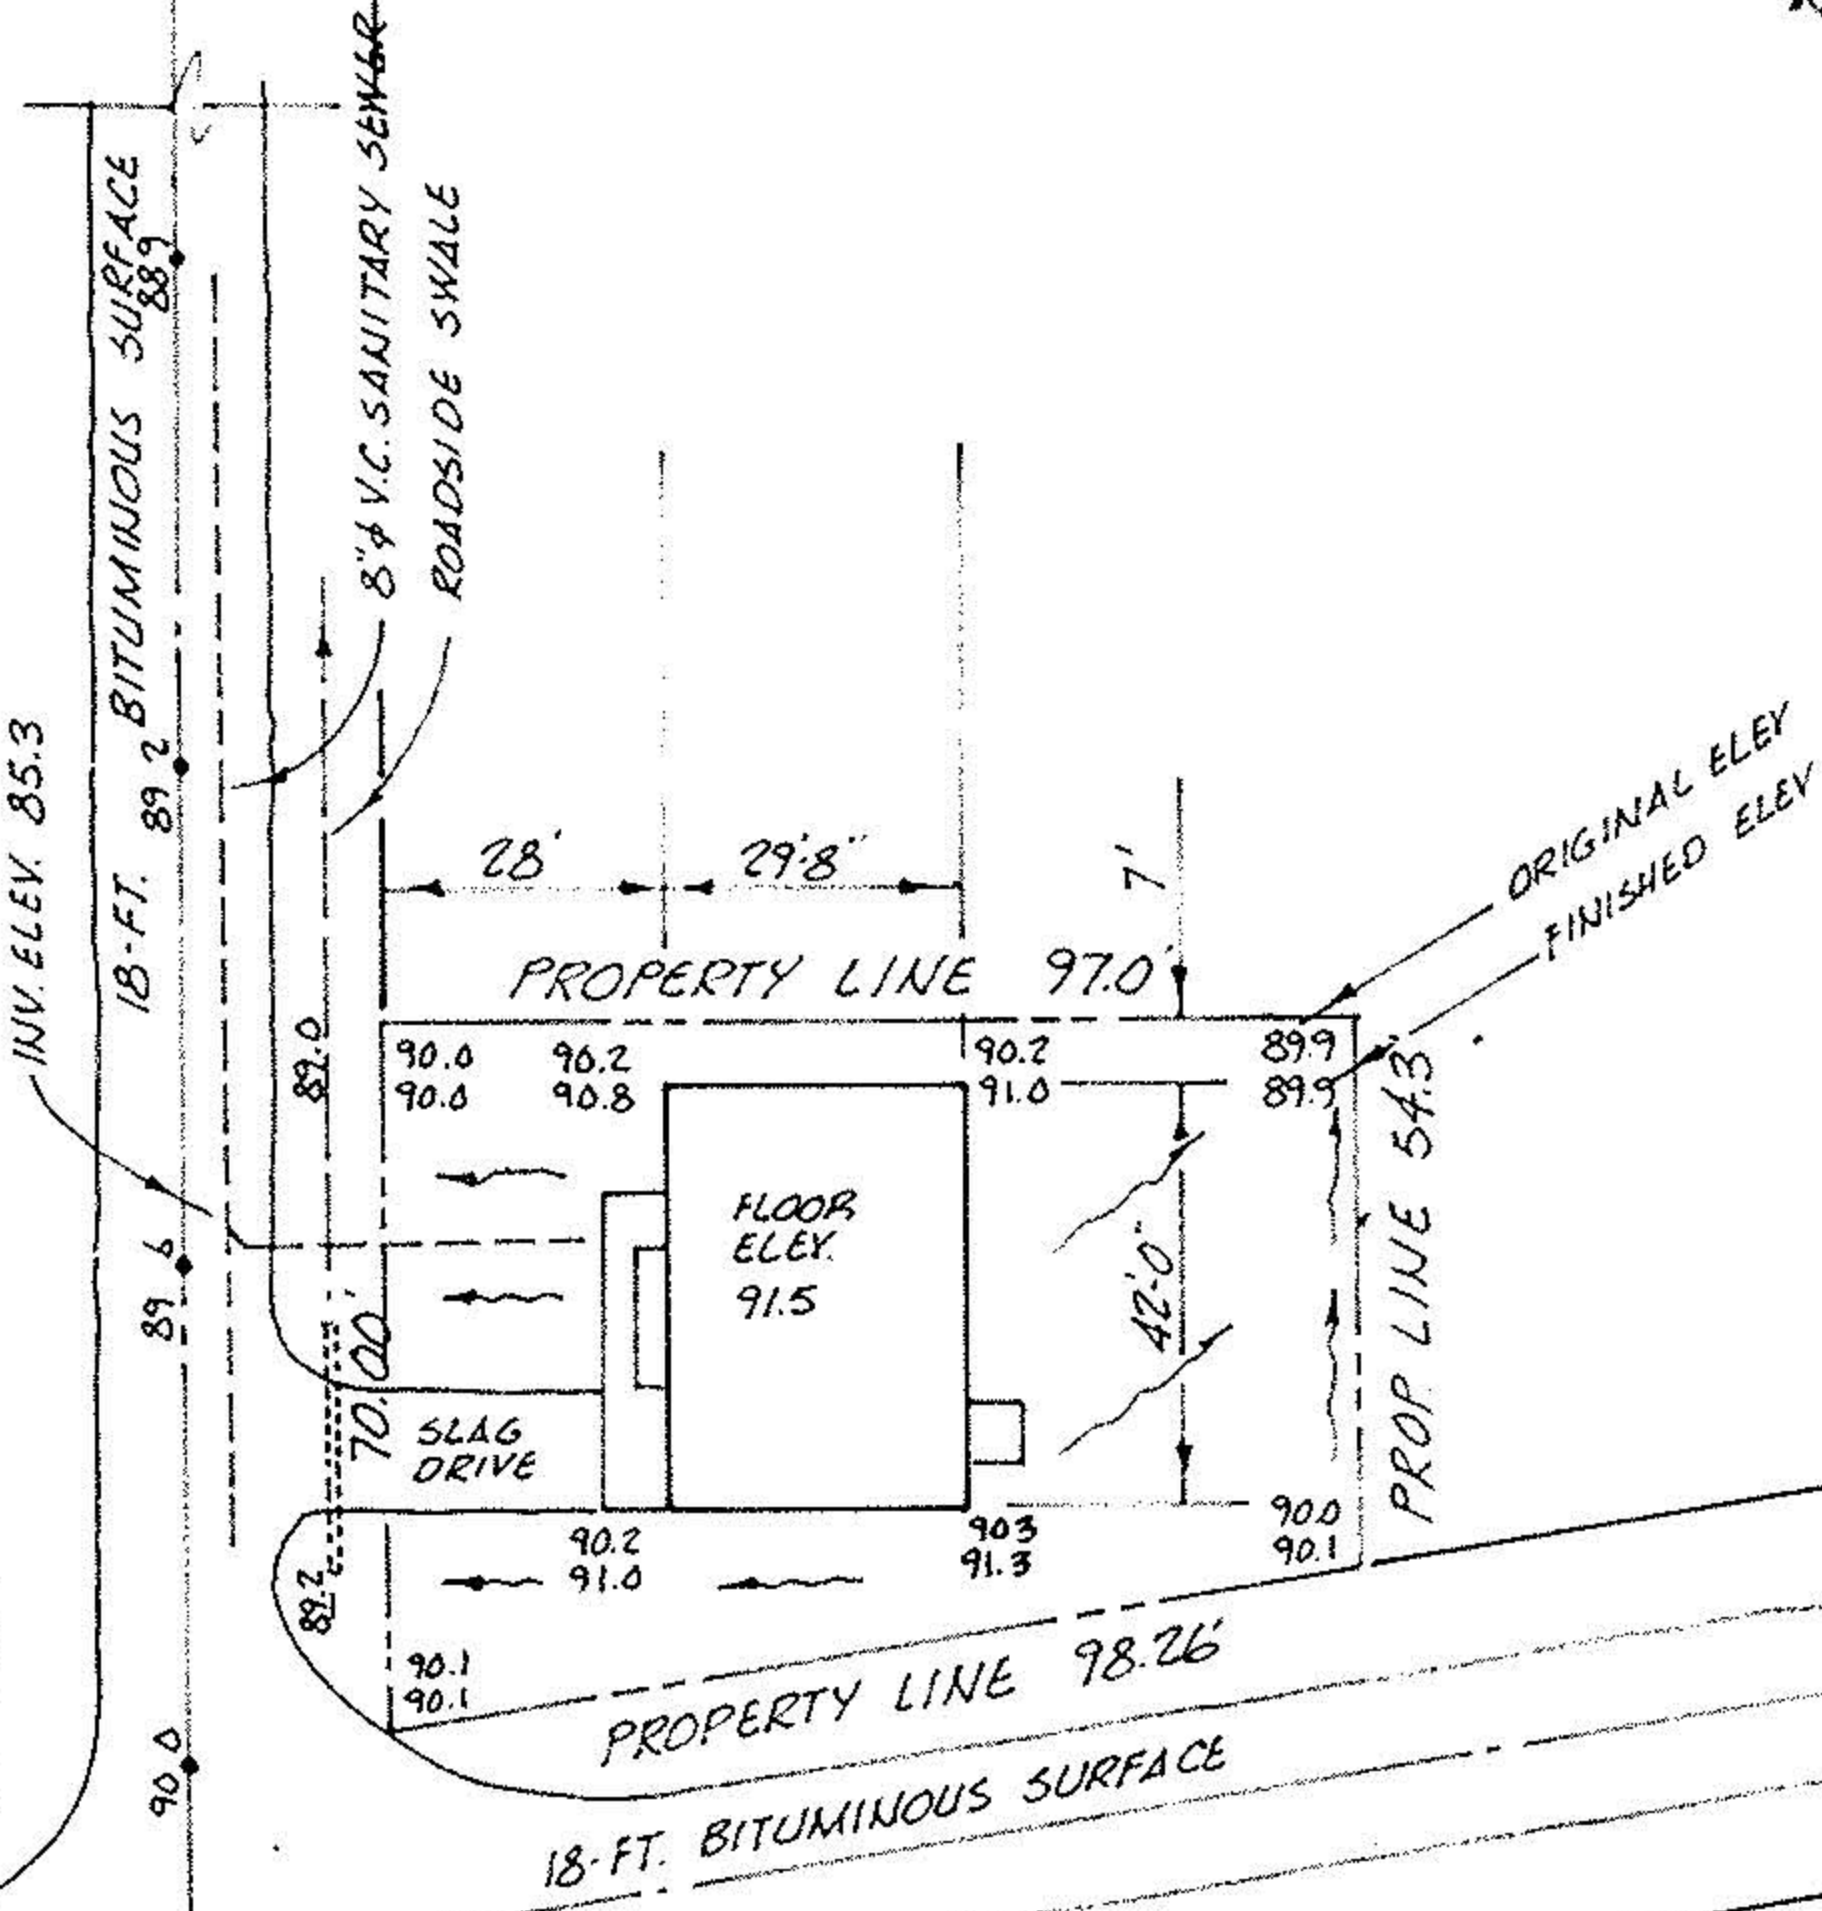


01-00-002-107-075  
1-00-002-B

WOODBRIDGE RD 40'

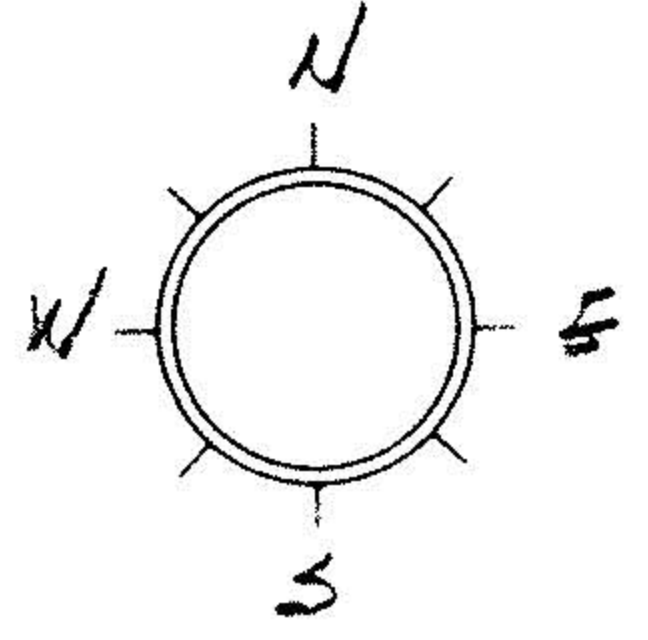

BERNELY RD 40'

acreage

DWG  
No

**PERIMETER SURVEY**

Sublot 1480A of VERMILION - ON - THE LAKE SUB 'N' N:1  
 Vol. 10 Page 18  
 Part of O.L. 2 Sect.      Tr.       
 City of VERMILION  
BROWNHELM Twp. LORAIN Co.

**MICHAEL G. HURA**  
 REGISTERED SURVEYOR  
 199 PARK AVENUE  
 AMHERST, OHIO 44001

drawn M.  
 date 3-27-74  
 scale 1" = 40'