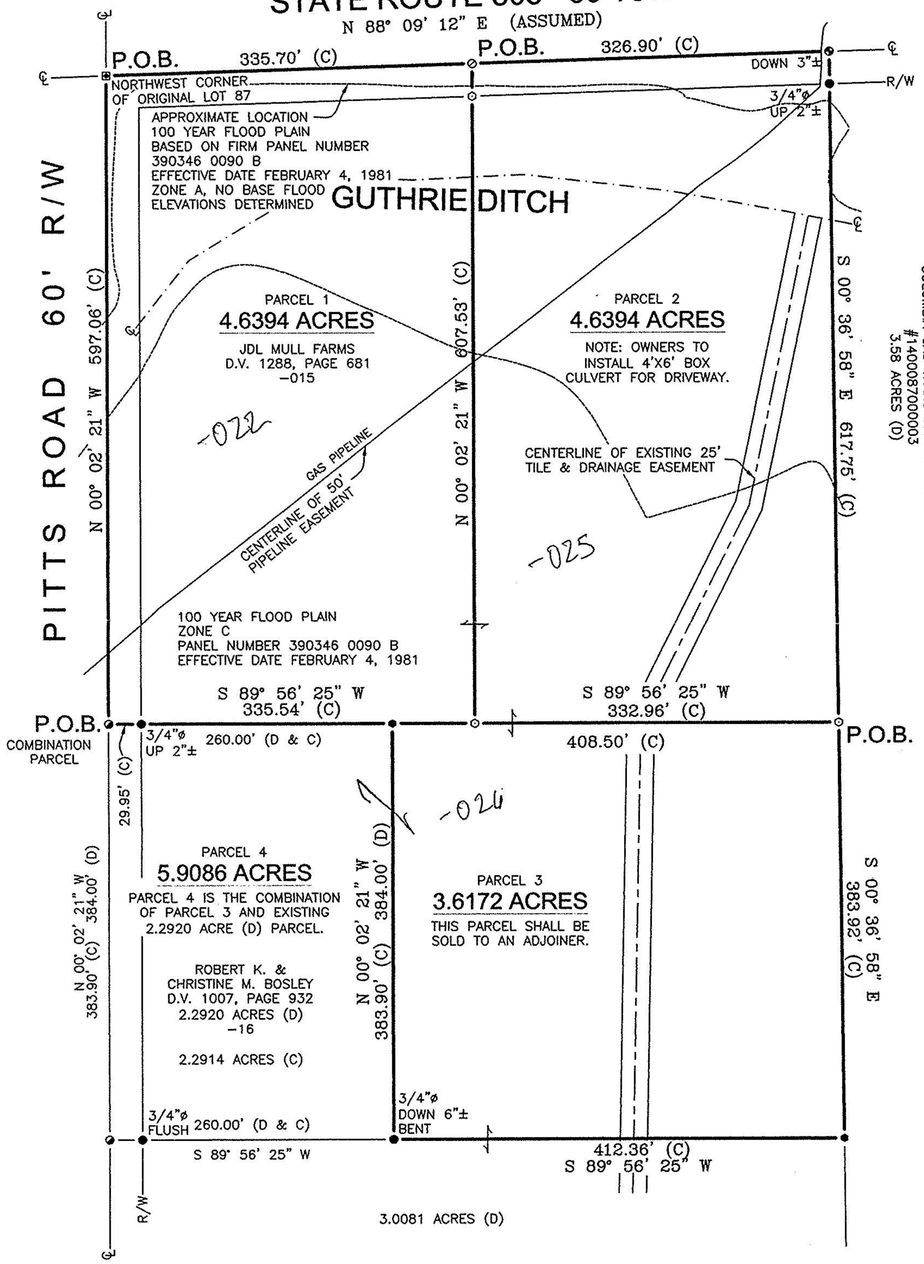

0 100' 200'

SCALE IN FEET

REFERENCES

DEED VOLUME AND PAGE AS SHOWN

SURVEY FOR SPRINKLE/MULL BY
HANK & ASSOC., INC., DATED OCTOBER 17, 2001

2 WORKING DAYS
BEFORE YOU DIG
CALL TOLL FREE 800-362-2764
OHIO UTILITIES PROTECTION SERVICE

LEGEND

SET	FOUND	DESCRIPTION
⊚	▲	CONC. MONUMENT
⊕	◔	RAILROAD SPIKE
⊘	◪	NAIL
⬡	⬢	IRON ROD
⊙	⊕	DRILL HOLE
	▲	STONE
	▣	MONUMENT BOX
	●	IRON PIPE
	■	WOOD POST
	(D)	DEED
	(P)	PLAT
	(M)	MEASURED
	(S)	SURVEYED
	(C)	CALCULATED

PARCEL 4
ACREAGE SUMMARY
2.2914 ACRES (C)
+3.6172 ACRES
5.9086 ACRES

№01578
APPROVED
LORAIN CO.
MAP DEPT
DATE 1-29-04
PAGE 14-F
BY JHatfield
04-01578

NOTE:
ALL IRON ROD SET ARE 5/8" DIA. x 30" LENGTH WITH PERSONALIZED CAPS (HANK AND ASSOC.) DRIVEN FLUSH.

SURVEYOR'S STATEMENT

I HEREBY DECLARE THAT THE ABOVE PARCEL WAS SURVEYED DURING MARCH, 2003, PROPERTY LINES SHOWN ARE LOCATED FROM DEEDS ON RECORD AND ARE DEED LINES. BEARINGS ARE ASSUMED FOR ANGULAR MEASUREMENT ONLY. ALL INFORMATION SHOWN IS TRUE AND CORRECT TO THE BEST OF MY KNOWLEDGE AND BELIEF (PER CHAPTER 4733-37 OF THE OHIO ADMINISTRATIVE CODE).

STATE OF OHIO
JAMES GORDON HOMAN, JR.
S-6972
REGISTERED PROFESSIONAL SURVEYOR

JAMES G. HOMAN, JR., P.S. # 6972 — DATE 11-17-03

NOV 18 2003

REVISIONS:	CHECKED BY:	DRAWN BY:
ADD PARCEL 4 11-17-03 JGH	JGH	DST
	SCALE 1" = 100'	DATE: 02-13-03

SURVEY FOR: SPRINKLE/MULL
LOCATED IN PART OF THE ORIGINAL LOT 87, PITTSFIELD TOWNSHIP, LORAIN COUNTY, OHIO.

HANK AND ASSOCIATES, INC.
ENGINEERING SURVEYING
137 SOUTH WASHINGTON STREET
TIFFIN, OHIO 44883
PHONE: (419) 447-4300 FAX: (419) 447-2076

JOB NO. 2031.034