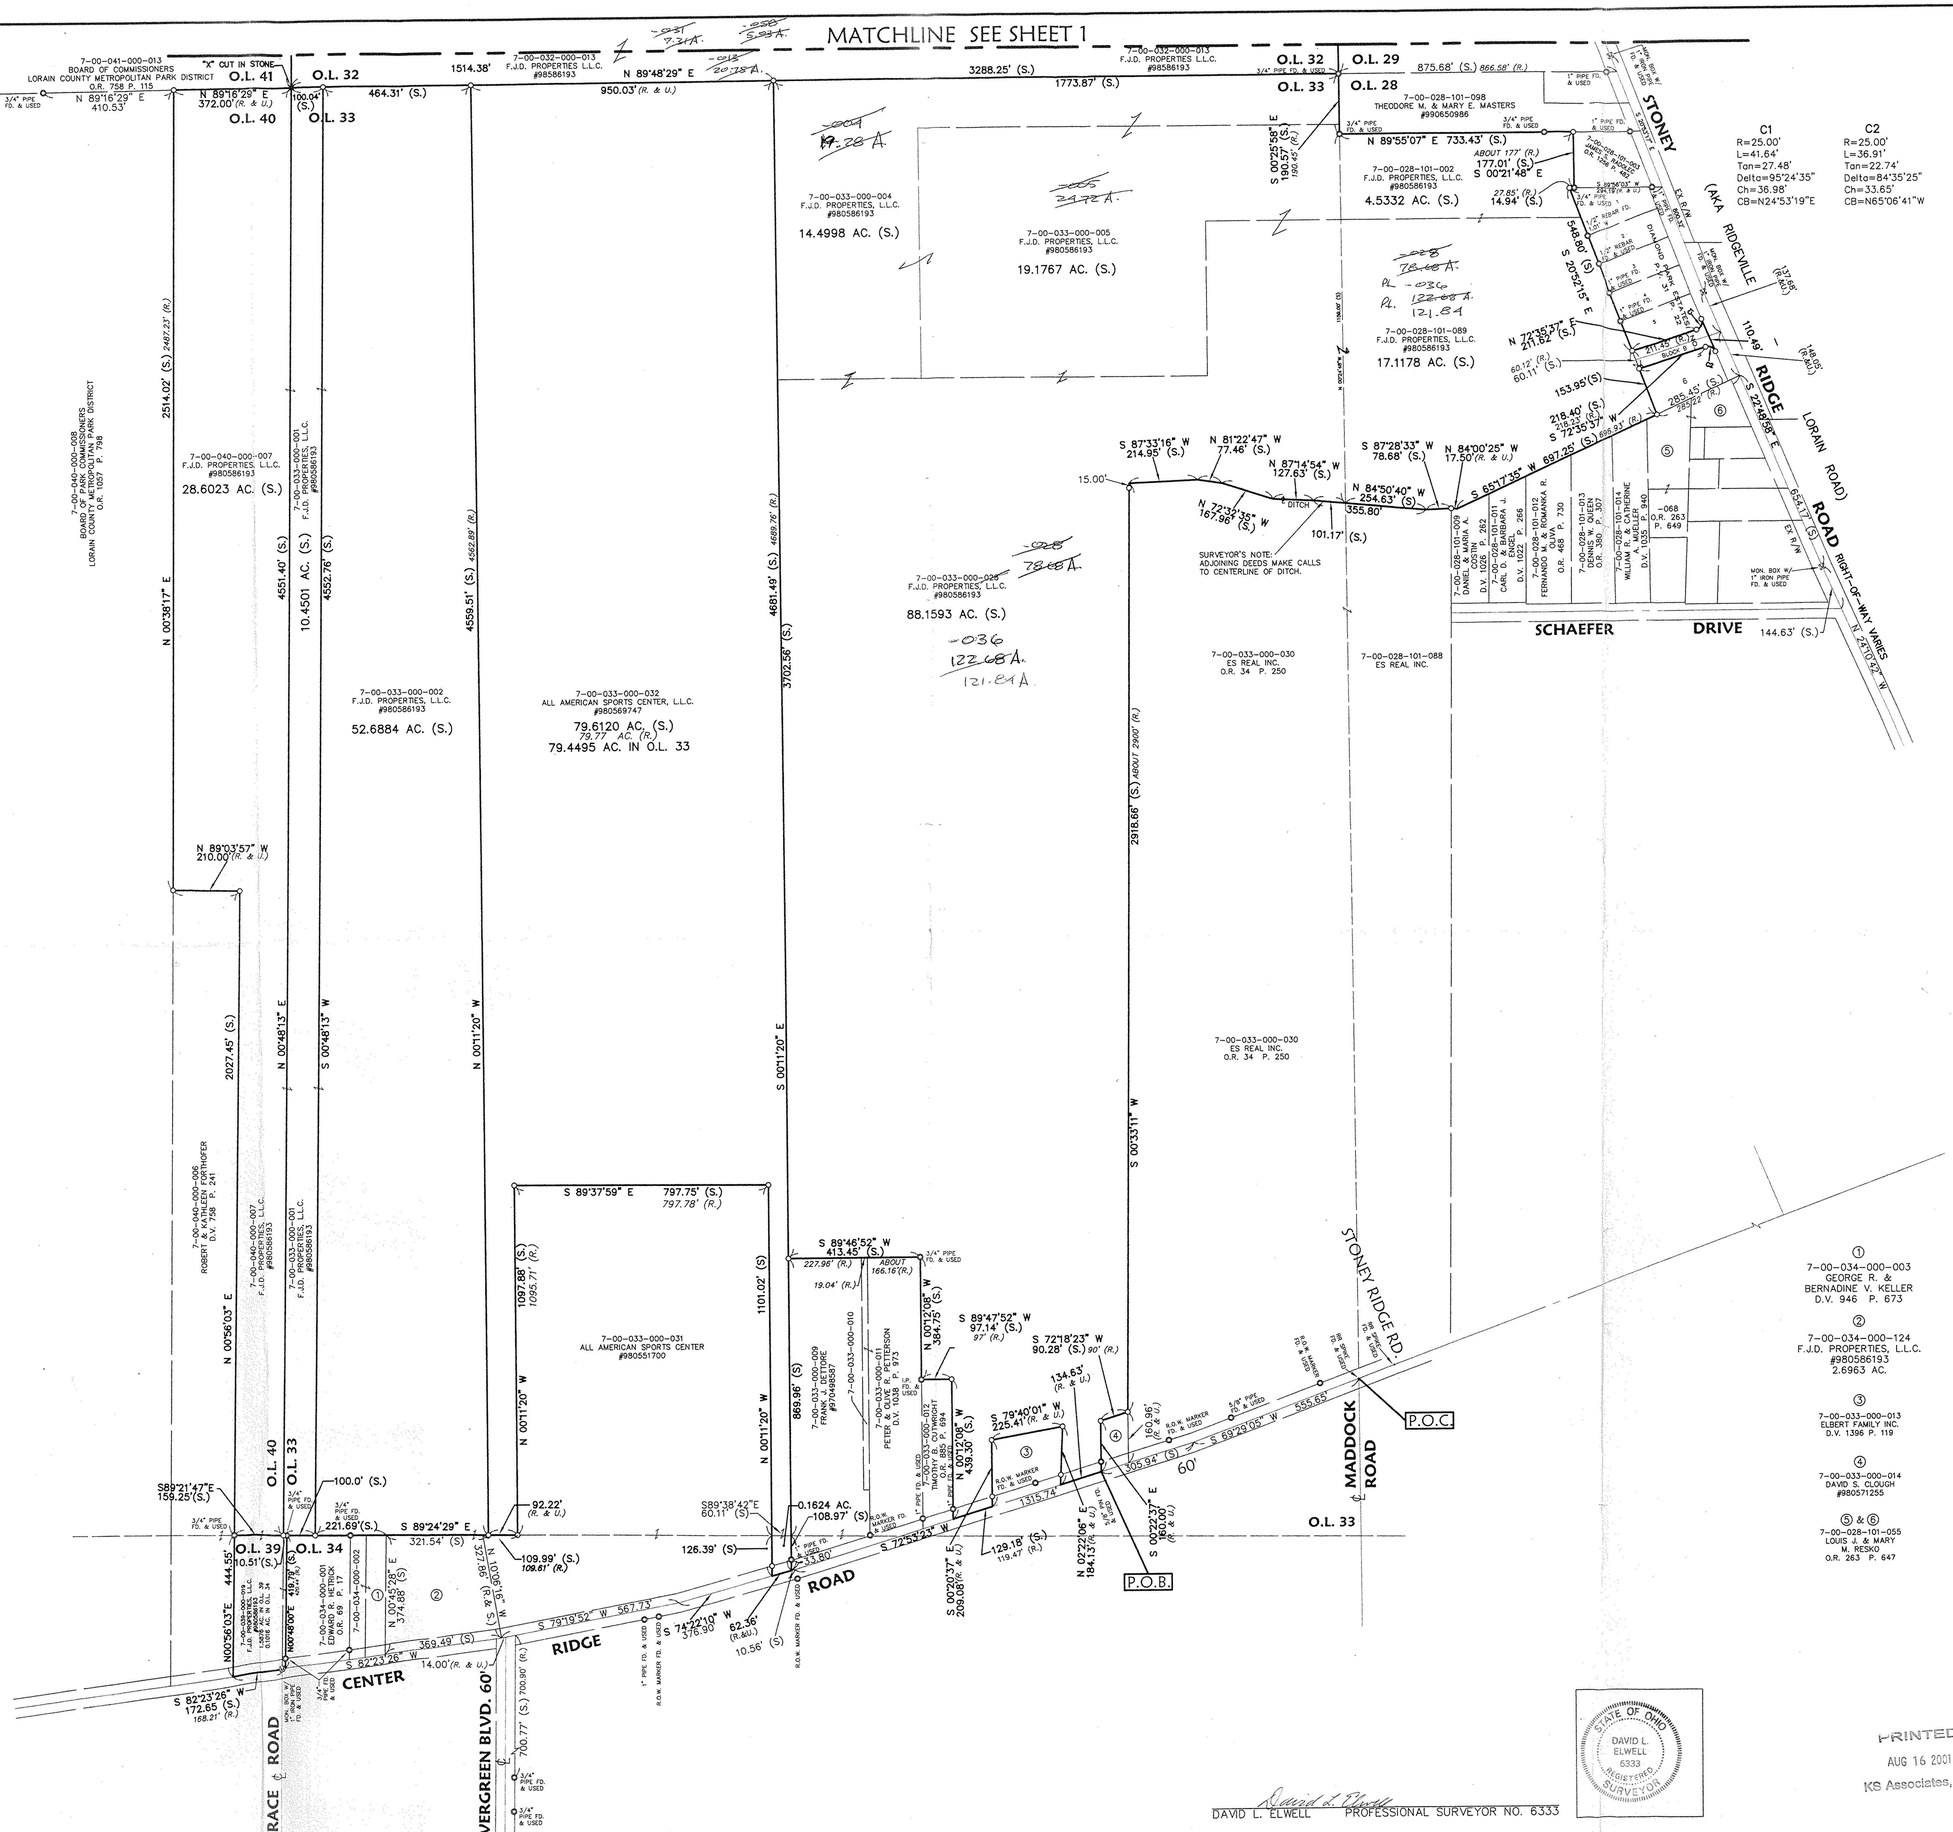

LEGEND

- ⊠ – MONUMENT BOX FOUND
- ⊹ – RR SPIKE FOUND
- ◎ – IRON PIN/PIPE FOUND
- ○ – 5/8" CAPPED REBAR SET

ABBREVIATIONS

AC.	–	ACRES
R./REC.	–	RECORD
S.	–	SURVEYED
U.	–	USED
FD.	–	FOUND

DAVID L. ELWELL PROFESSIONAL SURVEYOR NO. 6333

STATE OF OHIO
DAVID L. ELWELL
6333
REGISTERED
SURVEYOR

PRINTED
AUG 16 2001
KS Associates, Inc.

REVISIONS	DATE	BY	DESCRIPTION

DATE: 2/13/01
DRAWN BY: RGR
CH'D BY:
DWG. NAME: 6-AUG07
XREF'S: 99232-SURVEY01
PATH:
F.B.

KS ASSOCIATES, INC.
800 Burns Road, Suite 100
P.O. Box 5054
Elyria, Ohio 44036
Phone (440) 365-4730
Fax (440) 365-4790
mail@ksassoc.com
www.ksassoc.com

KS ASSOCIATES

SURVEY MAP

OF PART OF
ORIGINAL RIDGEVILLE TOWNSHIP LOTS NOS. 28,29,32 & 33
CITY OF NORTH RIDGEVILLE COUNTY OF LORAIN STATE OF OHIO

SHEET 2 OF 2

JOB NO. 99232