


BOUNDARY SURVEY
 OF PART OF
ORIGINAL AMHERST TOWNSHIP LOT NO. 60
CITY OF AMHERST COUNTY OF LORAIN STATE OF OHIO

JOB NO. 99189

REVISED: NOV. 29, 1999 - DEC. 3, 1999 - JAN. 3, 2000 - JULY 23, 2001
 DATE: OCTOBER 13, 1999
 REVISED: NOVEMBER 18, 1999

COOPER FOSTER PARK ROAD

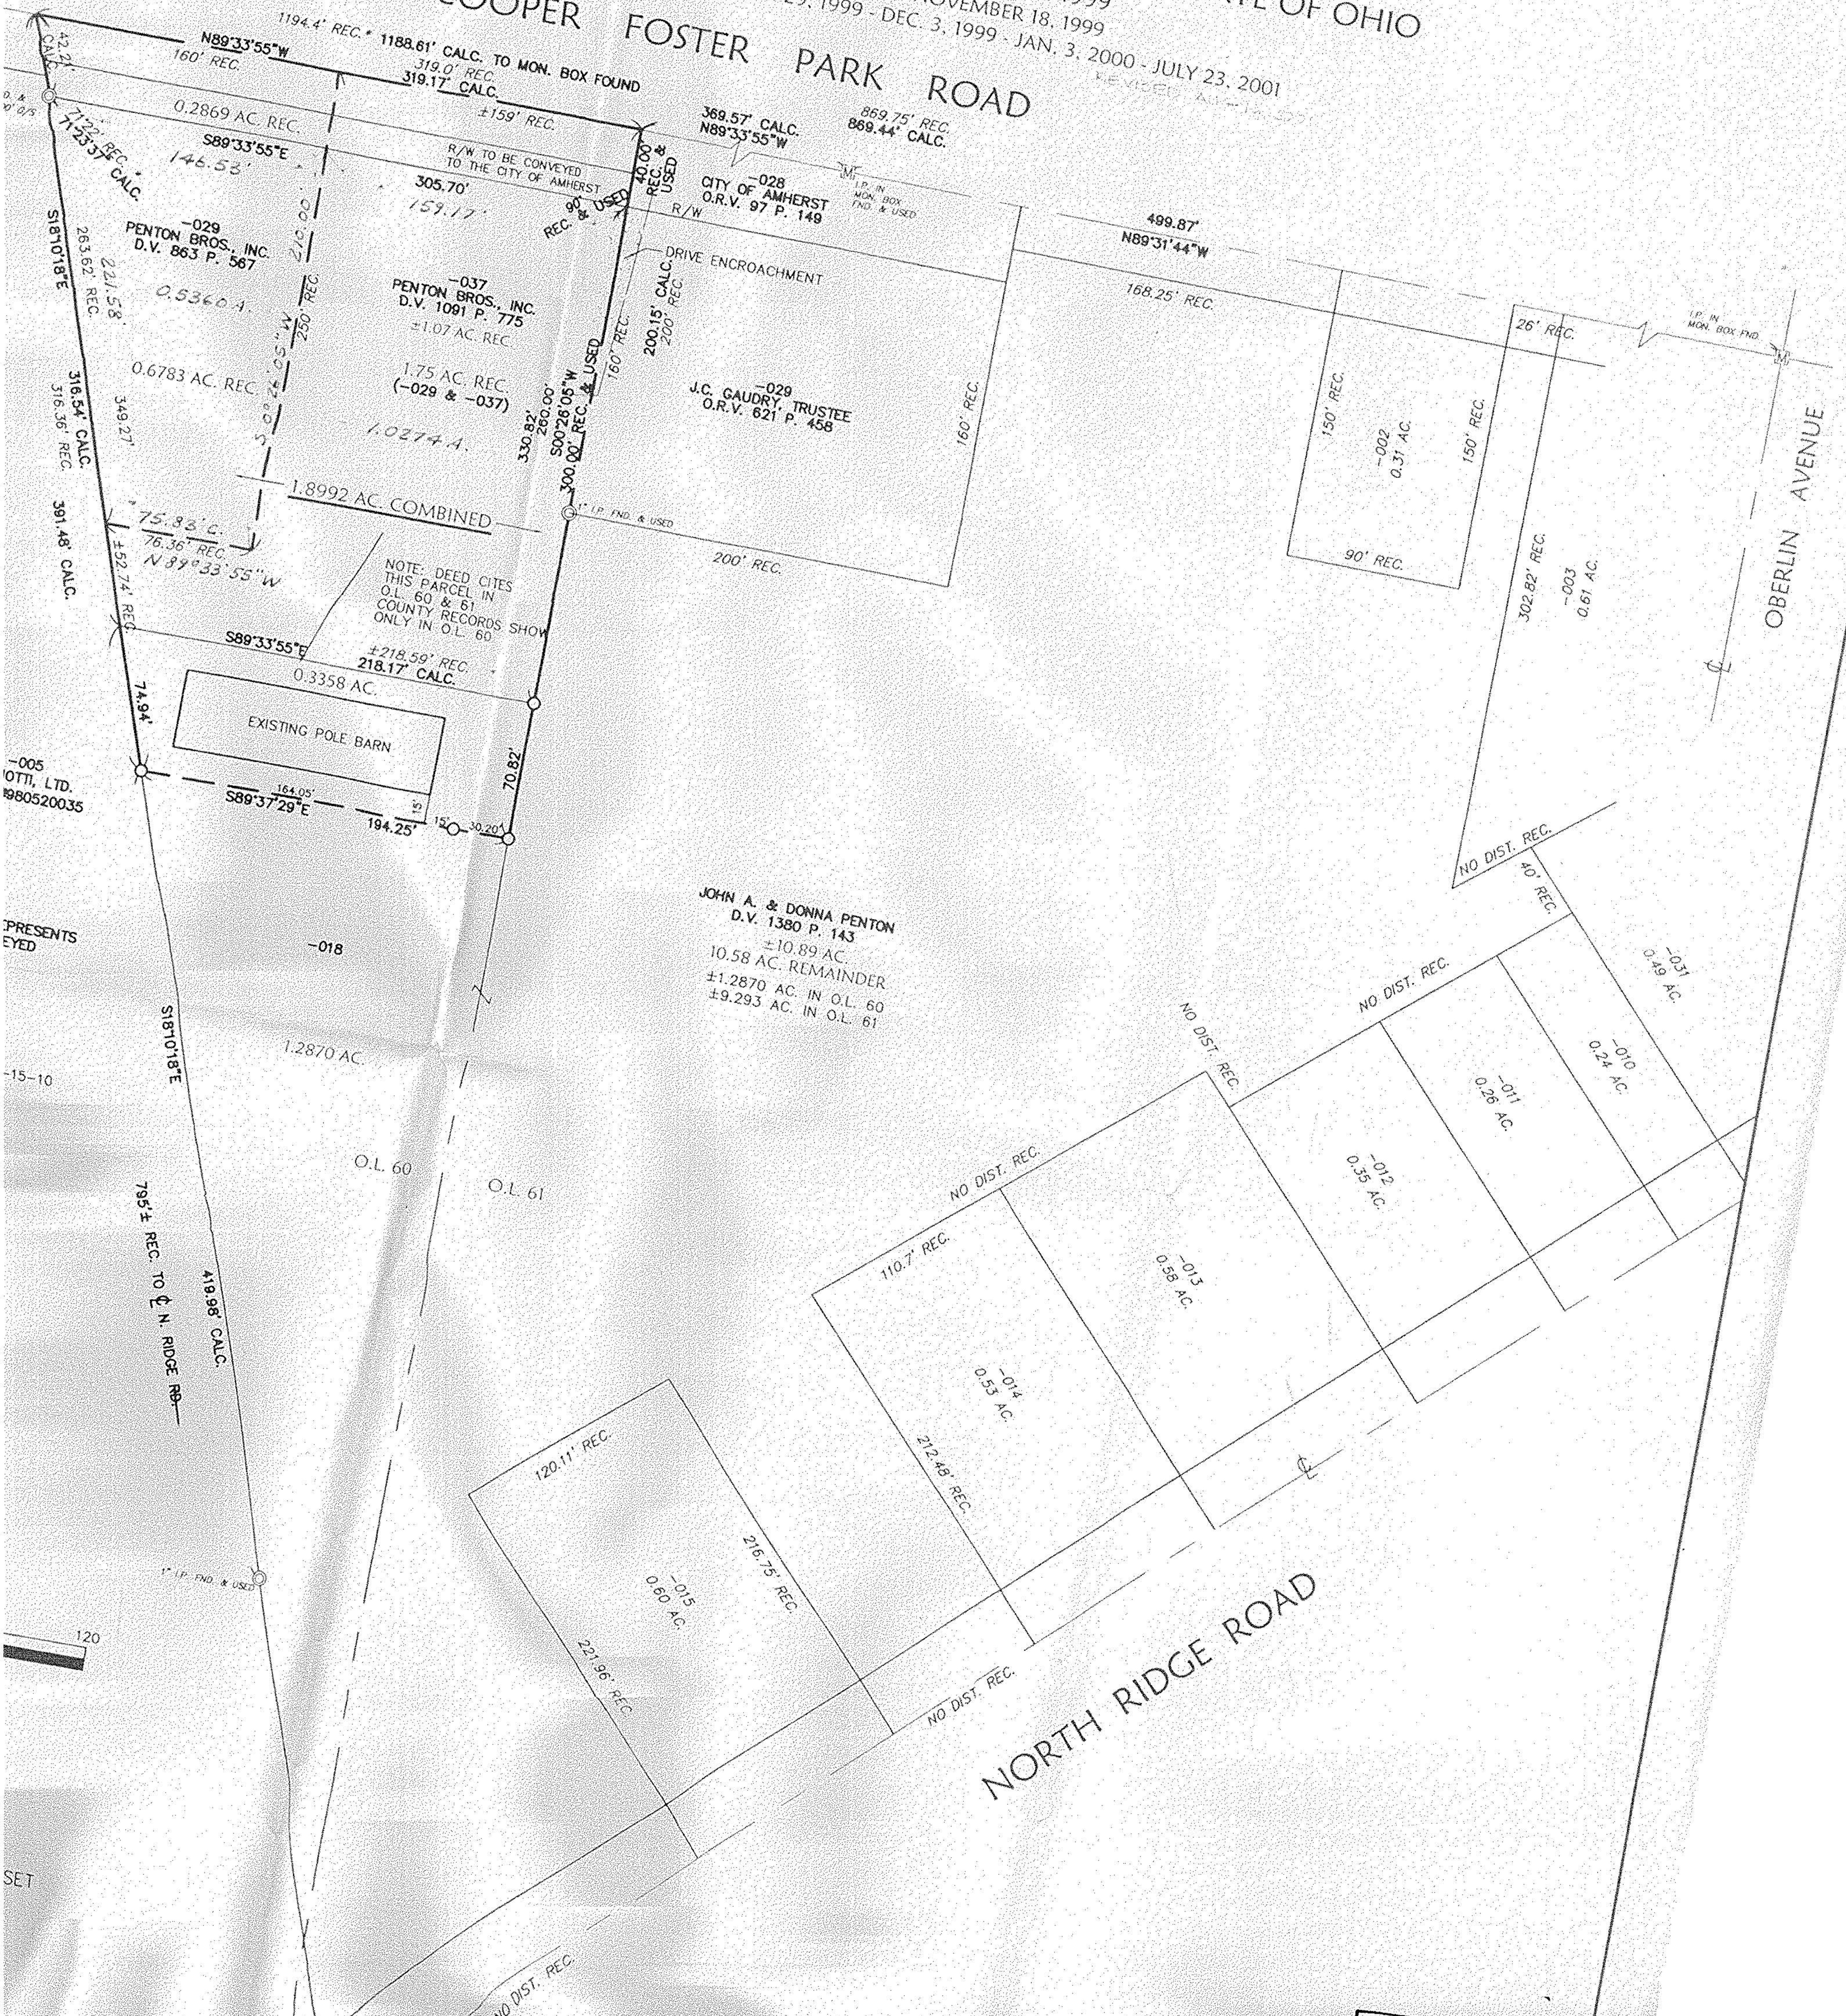

JOHN A. & DONNA PENTON
 D.V. 1380 P. 143
 ±10.89 AC.
 10.58 AC. REMAINDER
 ±1.2870 AC. IN O.L. 60
 ±9.293 AC. IN O.L. 61

APPROVED
 LORAIN CO.
 MAP DEPT
 DATE 11-14-03
 PAGE 5-00-0009
 [Signature]
 #01509

KS ASSOCIATES
 424 Middle Avenue
 Phone (440) 322-6317
 Fax (440) 284-0623
 mailroom@ksassoc.com
 www.ksassoc.com