PARENT PARCEL: 07-00-020-101-100, 07-00-020-101-007

CHILD PARCEL: 07-00-020-101-104 THRU -115

STARTING POINT: CENTERLINE OF SANDLEWOOD AVE & POPLAR ST.

NO. 00803

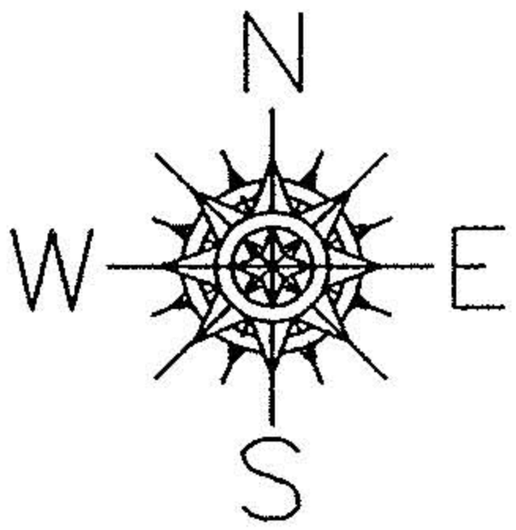

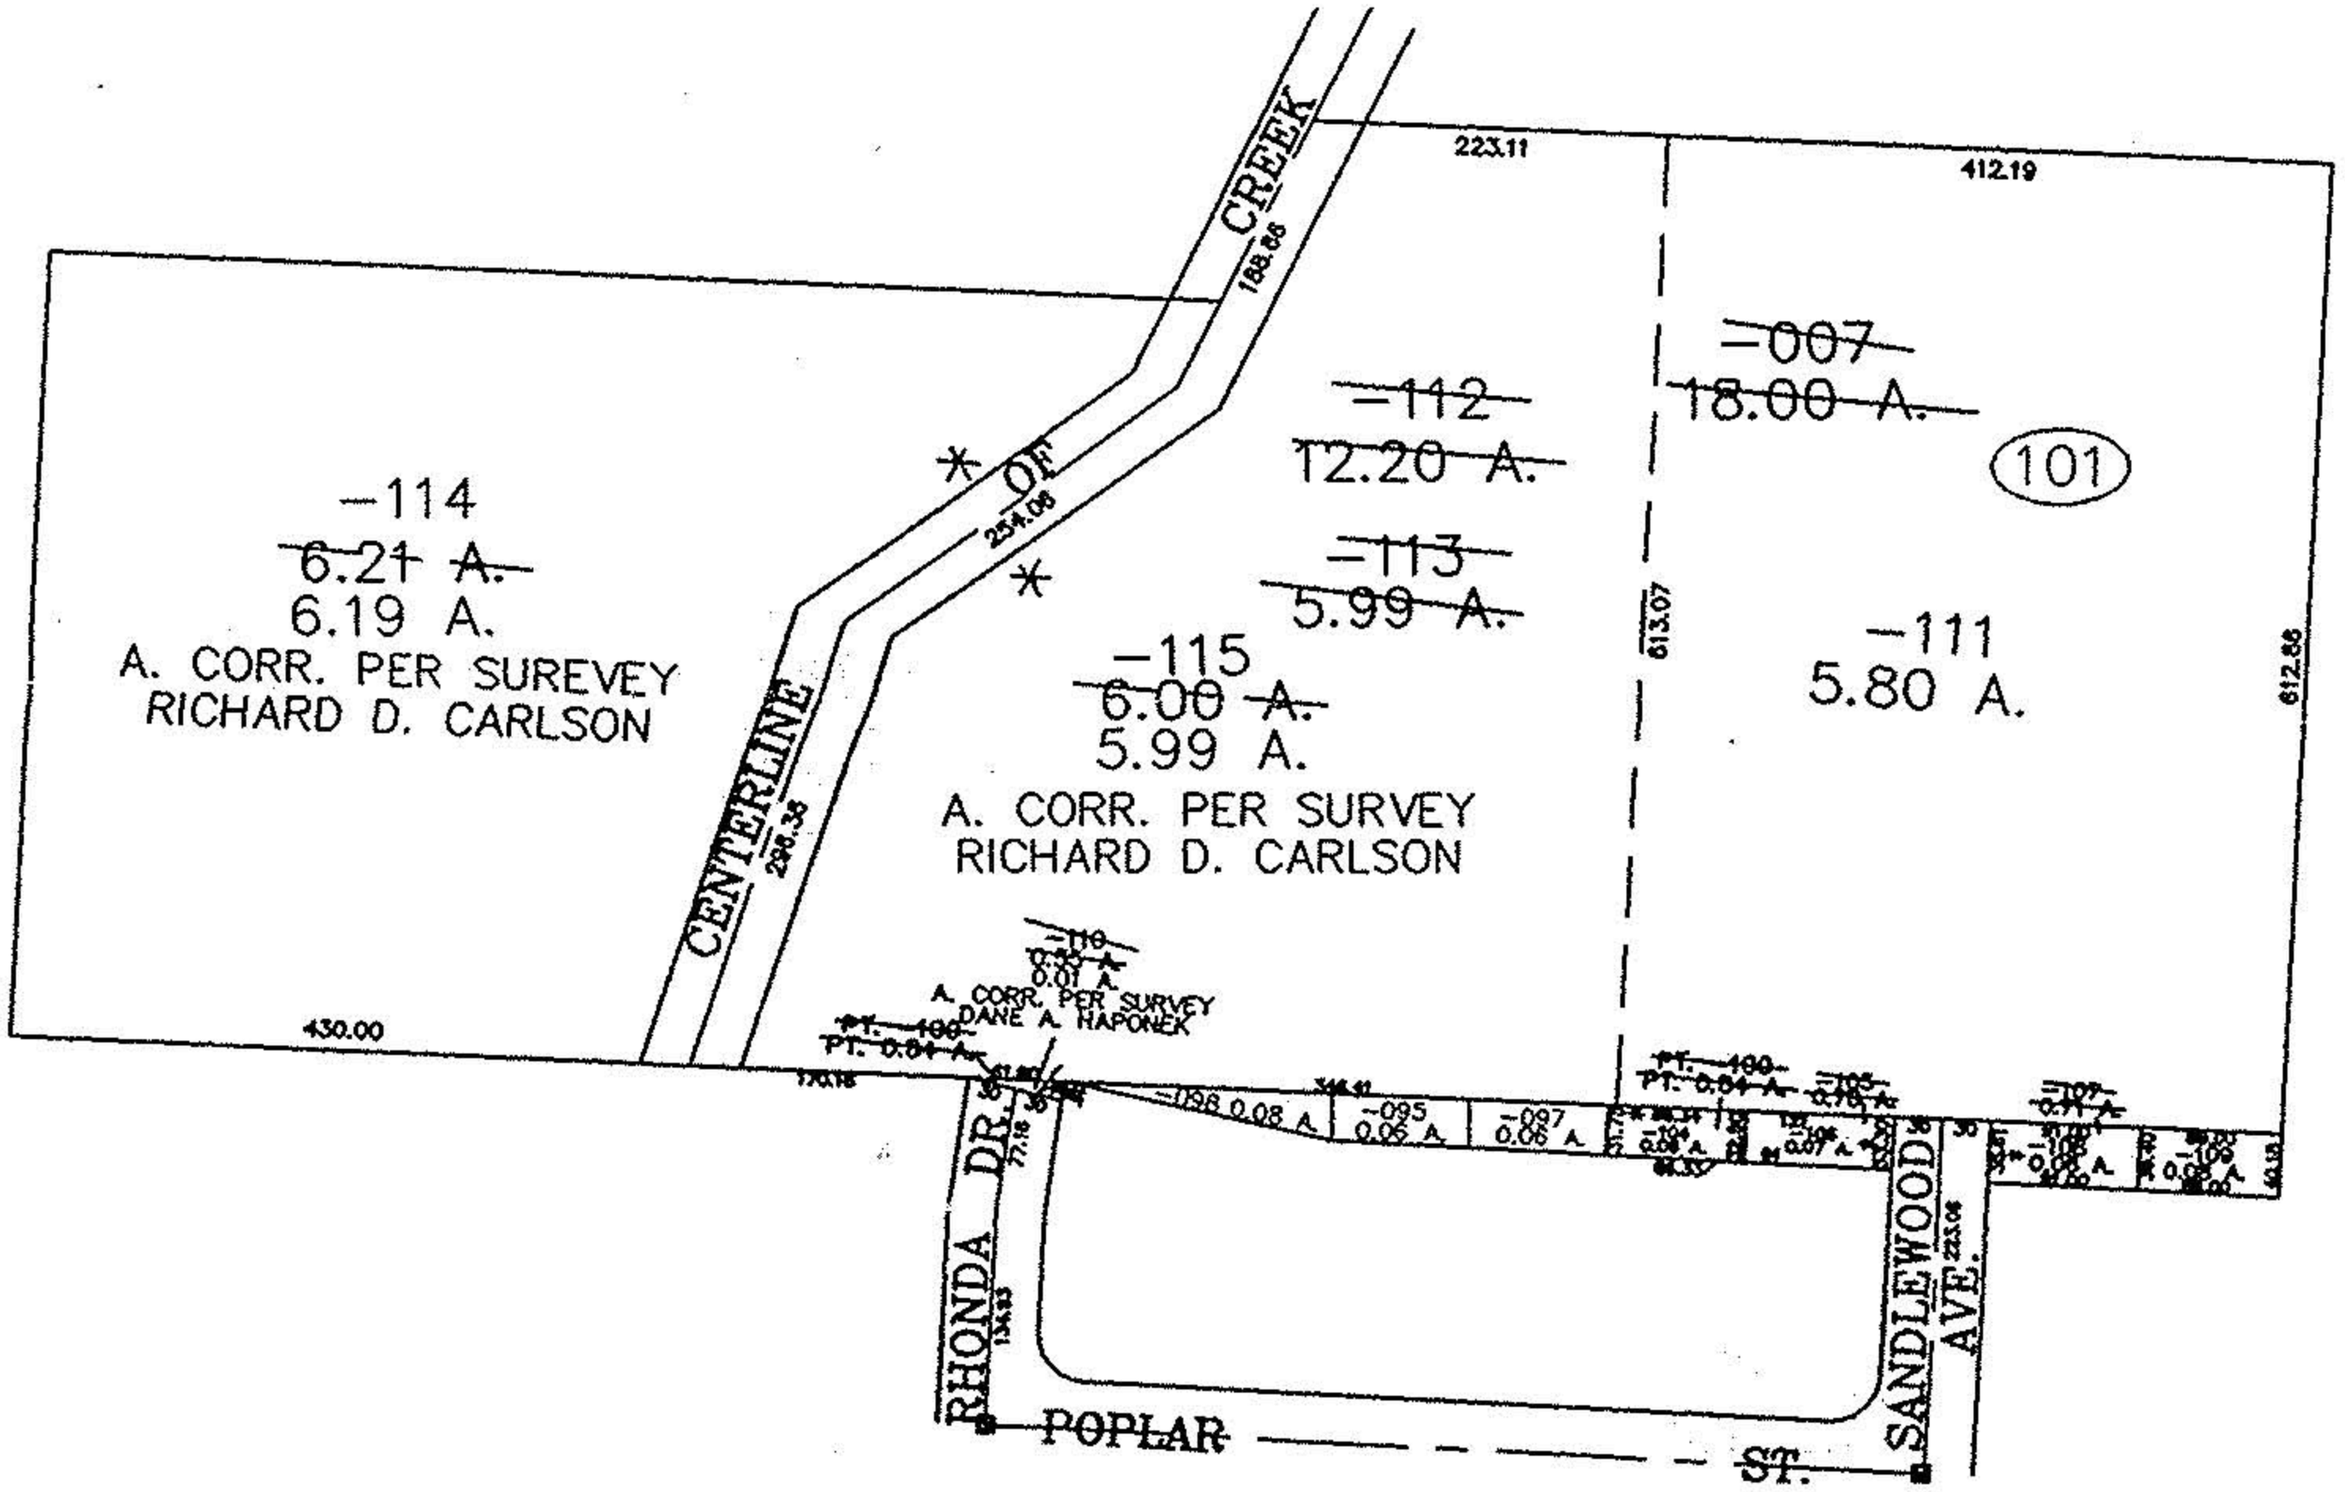

SPLITS/DEEDS PROCESSED

LORAIN COUNTY TAX MAP DEPARTMENT
226 MIDDLE AVE. ELYRIA, OHIO

SURVEYED BY: DANE HAPONEK, RICK CARLSON

CLOSURE: 0.01 ; 10,000

MAP PAGE(S): 7-00-020-A, C

APPROVED BY: JAH DATE: 7-13-01

SCALE: 1"= 200 PRIOR INSTRUMENT: 980584765