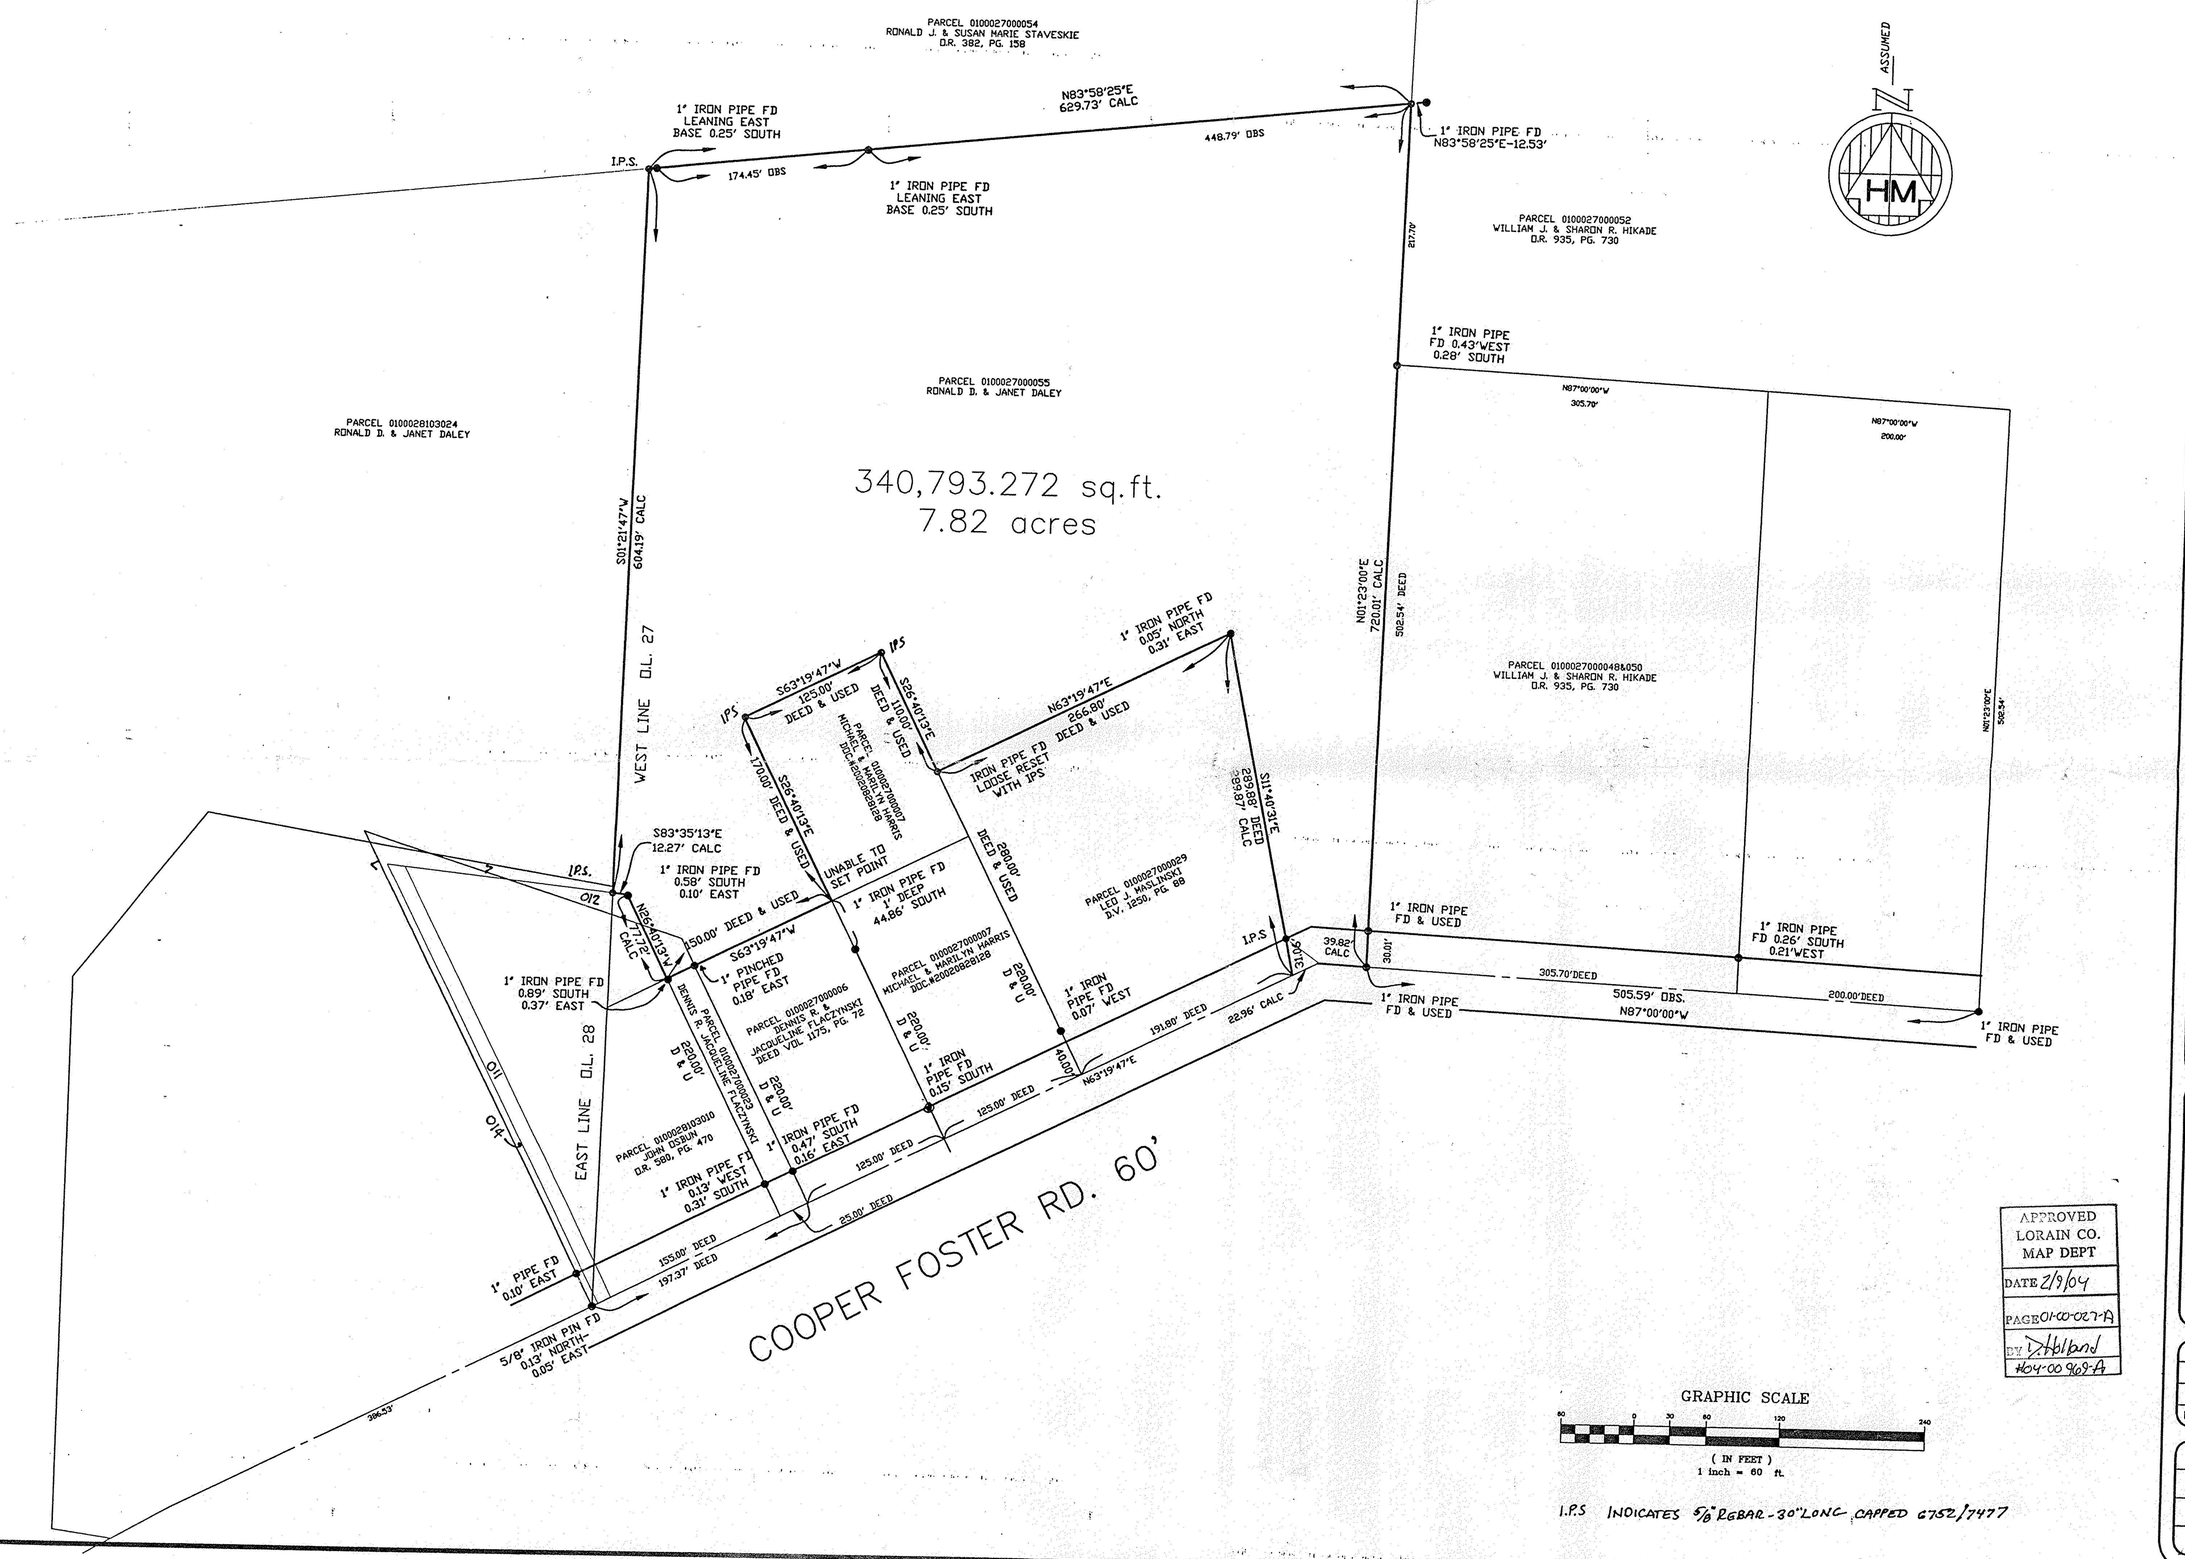

APPROVED
LORAIN CO.
MAP DEPT
DATE 2/9/04
PAGE 01-00-027-A
BY D. Holland
#04-00 968-A

GRAPHIC SCALE

60 0 30 60 120 240

(IN FEET)
1 inch = 60 ft.

I.P.S INDICATES 5/8" REBAR-30" LONG CAPPED 6752/7477

BOUNDARY SURVEY

JANET DALEY

ORIGINAL BROWNHELM TOWNSHIP LOT 27
NOW IN THE CITY OF VERMILLION
LORAIN COUNTY, OHIO

HOFMANN—METZKER, INC.
REGISTERED PROFESSIONAL
SURVEYORS
24 BEECH ST - P.O. BOX 343
BEREA, OHIO 44017
440-234-7350 FAX 440-234-7[illegible]

GEORGE HOFMANN E-MAIL
george_hm@ameritech.net

STATE OF OHIO
GEORGE A. HOFMANN
6752
REGISTERED SURVEYOR

GEORGE A. HOFMANN
12-11-03
DATE

NO.	REVISION	DATE

DRAWING DWG	1/1
ORDER NO. 03-272	
F.B. 789 PG. 30	
12-11-03	