Plat of Survey for the Boy Scouts of America

Being a part of Lots 9 and 10 within Tract 12,
Henrietta Township, Lorain County, Ohio

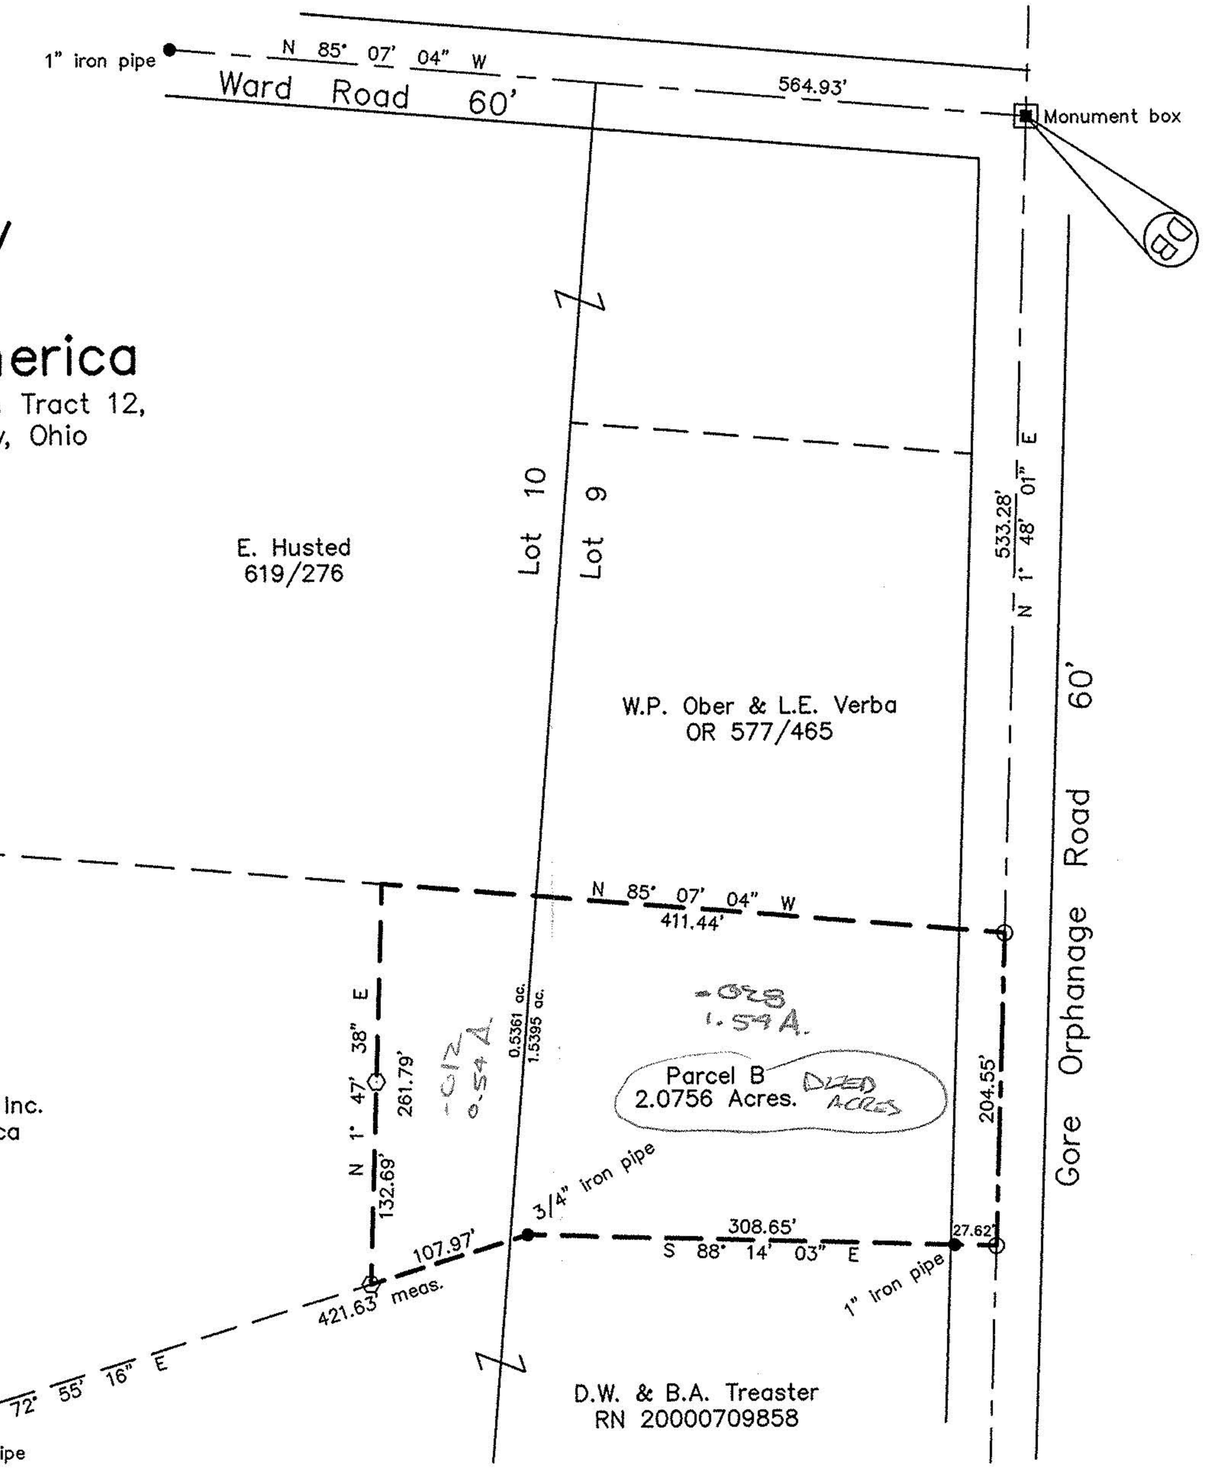

Assumed Meridian

○ 9/16" Hex Bar Set ○ Nail Set
● Monument Found
0 1 2 3
Inch Scale E/C 1:10000

Timothy Riley
ENGINEER – SURVEYOR
Norwalk, Ohio

Timothy Riley
Timothy Riley
Reg. Surveyor No. 6925

STATE OF OHIO ★ SURVEYOR ★ PROFESSIONAL
Timothy O. Riley #S-6925

APPROVED
LORAIN CO.
MAP DEPT
DATE 4-18-03
PAGE 8-E
BY D. Holland
No 01349

Date: 3-17-2001	Dwn By: CAD
Scale: 1" = 100'	Ckd By: TOR
Tract 12, Lots 9 & 10, Henrietta Twp.	
Job No. 32,006 B Gore Orphanage Rd	