

14-00-077-000-

(54.67 AC. ± REM) (14-00-077-000-001)
62.00 AC. ±

S-88°09'54"-W 700.00'

Iron Pin Set Iron Pin Set

ROBERT JOHN DIEDRICK & MARY ELIZABETH DIEDRICK


D.V. 617 R 68

456.00'

456.00'

- 006 7.3278 AC.

#18777
APPROVED
LORAIN CO.
MAP DEPT.
DATE 12-19-89
PAGE 14-c
BY T. McMan
18777

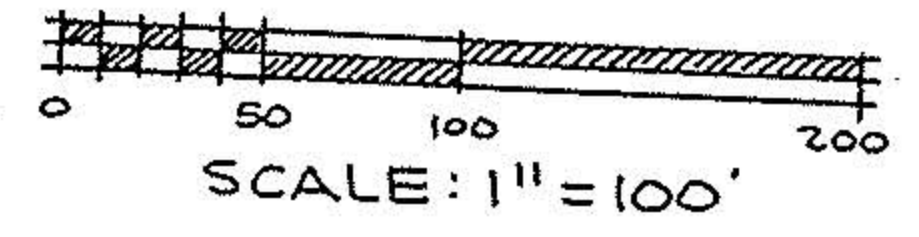

HALLAUER ROAD

S-1°50'06"-E

Iron Pin Set

N-1°50'06"-W

Iron Pin Set

1270.81' M.

N-88°09'54"-E (Assumed)

700.00'

P.K. Set

P.K. Set

WAKEMAN - BELDEN - RICHFIELD ROAD

(S.R. 303)

WHAT IS DIMENSION FROM NEW PL TO EXISTING PL ON -001?
10' ± SCALED OFF AERIAL PER? DAUELLWELL 12/18/89

HAWLEY ROAD



David L. Elwell
REG. SURV. NO. 6333

BOUNDARY SURVEY
PART OF PITTSFIELD TOWNSHIP
TOWNSHIP OF PITTSFIELD COUNTY OF LORAIN
STATE OF OHIO

PREPARED BY
KS ASSOCIATES INC.
ENGINEERS SURVEYORS