No 01470

APPROVED
LORAIN CO.
MAP DEPT

DATE 9-23-03

PAGE 15-A

BY JHatfield

#03-01470

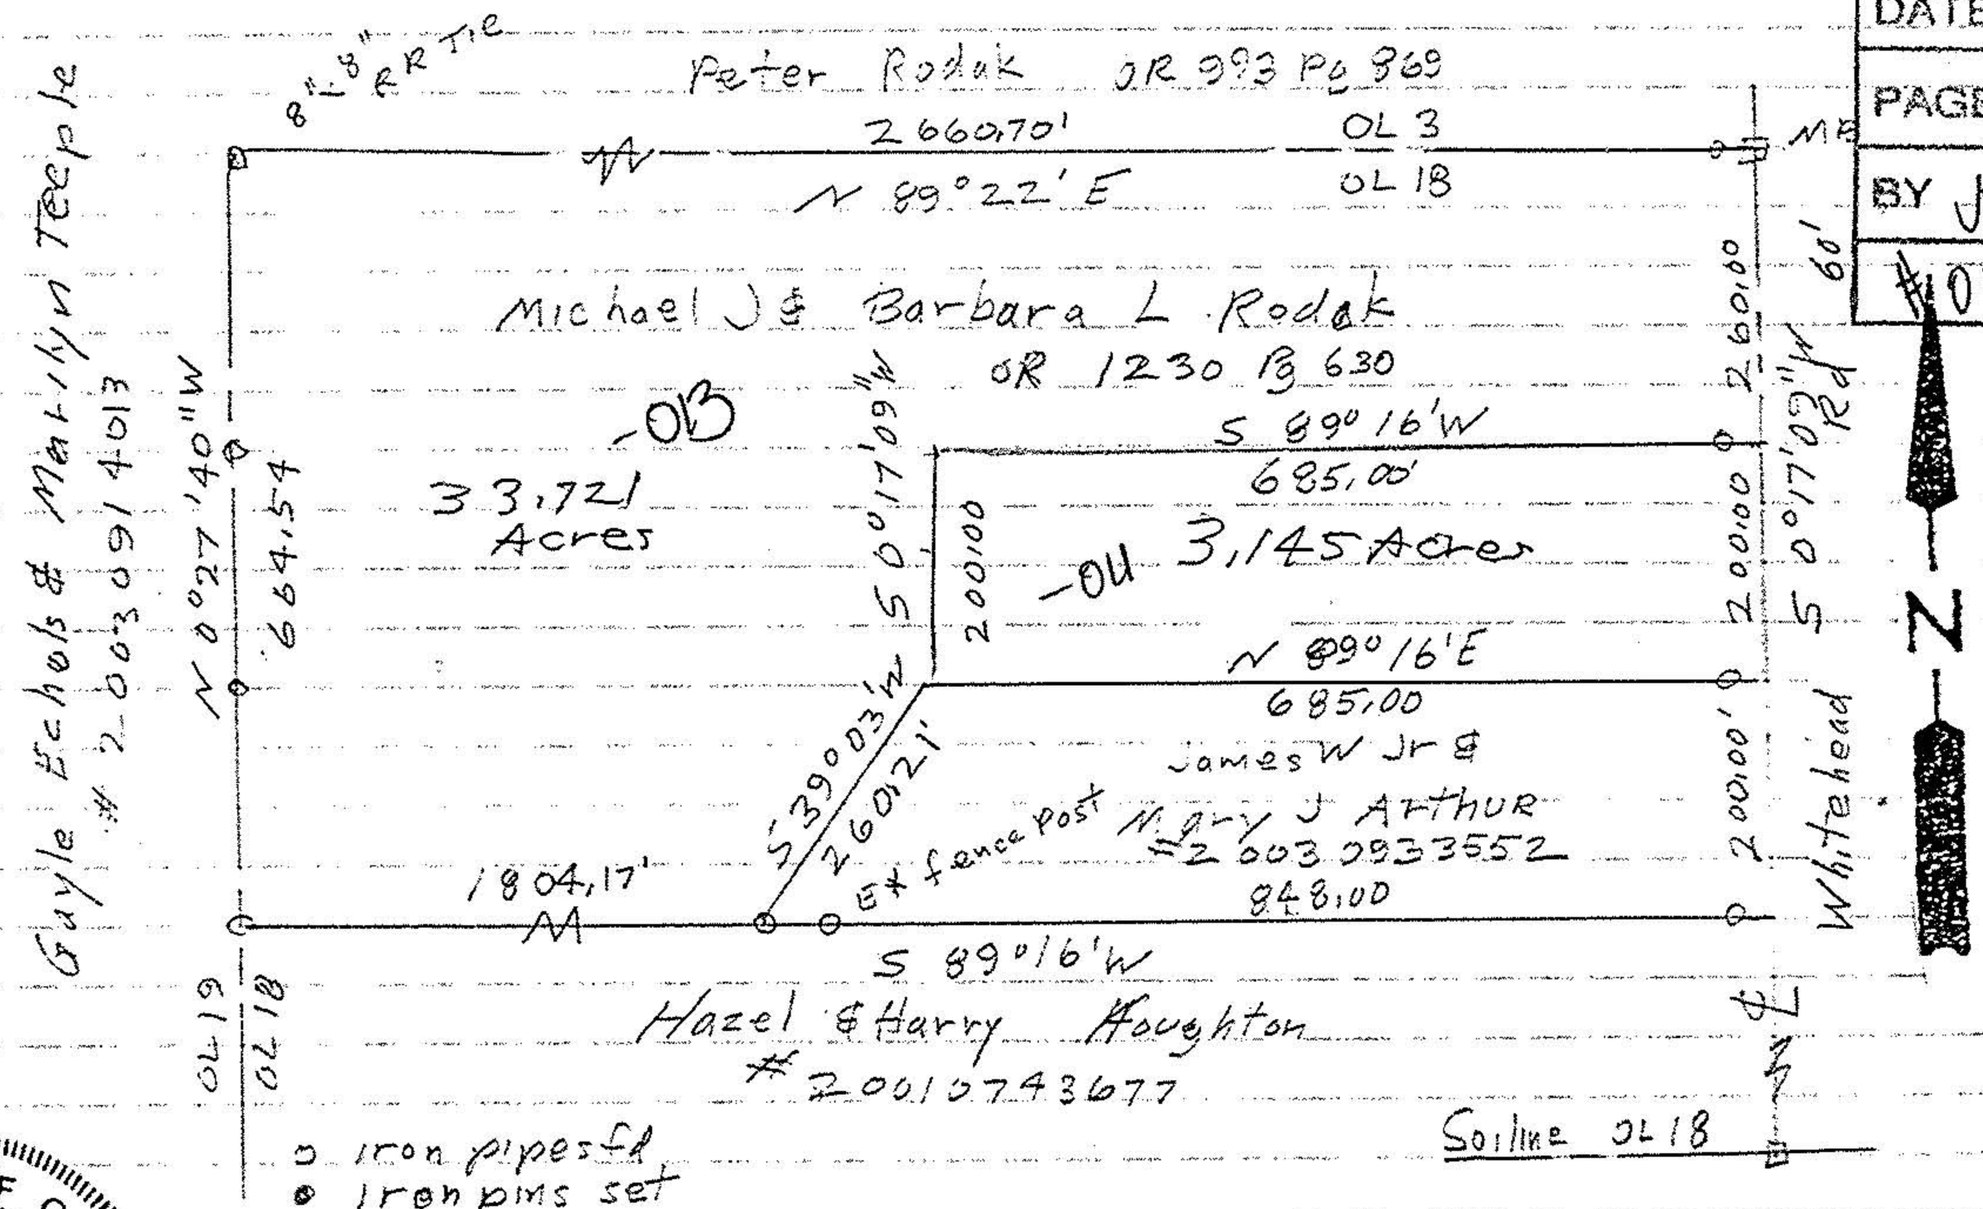

○ iron pipes fd
● iron pins set
□ Monument boxes
Ref Bearing ℄ Whitehead

John Pozywak

Survey for Mike Rodak
Original Lot 18 LaGrange Twp
Lorain County OHIO
Scale 1"=200 March 1996
August 2003

STATE OF OHIO
JOHN POZYWAK
5292
REGISTERED
SURVEYOR