





BOUNDARY SURVEY

CITY OF AMHERST ~ LORAIN COUNTY ~ STATE OF OHIO
 PART OF ORIGINAL AMHERST TOWNSHIP LOTS 99 & 100
 P.P.N. 05-00-099-000-067
 DOC. NO. 02-0869081

PREPARED FOR
 SUSAN WOLLERMAN-POST
 1057 GULF ROAD
 ELYRIA, OHIO 44035
 (440) 366-0067

SURVEYOR'S CERTIFICATION

THIS IS TO CERTIFY THAT AT THE REQUEST OF THE OWNERS I HAVE SURVEYED AND PLATTED 6.7767 ACRES OF LAND AS SHOWN HEREON IN ORIGINAL AMHERST TOWNSHIP LOT NO. 99 AND 100, CITY OF AMHERST, COUNTY OF LORAIN, STATE OF OHIO. DISTANCES ARE SHOWN IN FEET AND DECIMAL PARTS THEREOF. BEARINGS SHOWN ARE ASSUMED AND USED TO DESCRIBE ANGLES ONLY. ALL OF WHICH I CERTIFY TO BE CORRECT.

 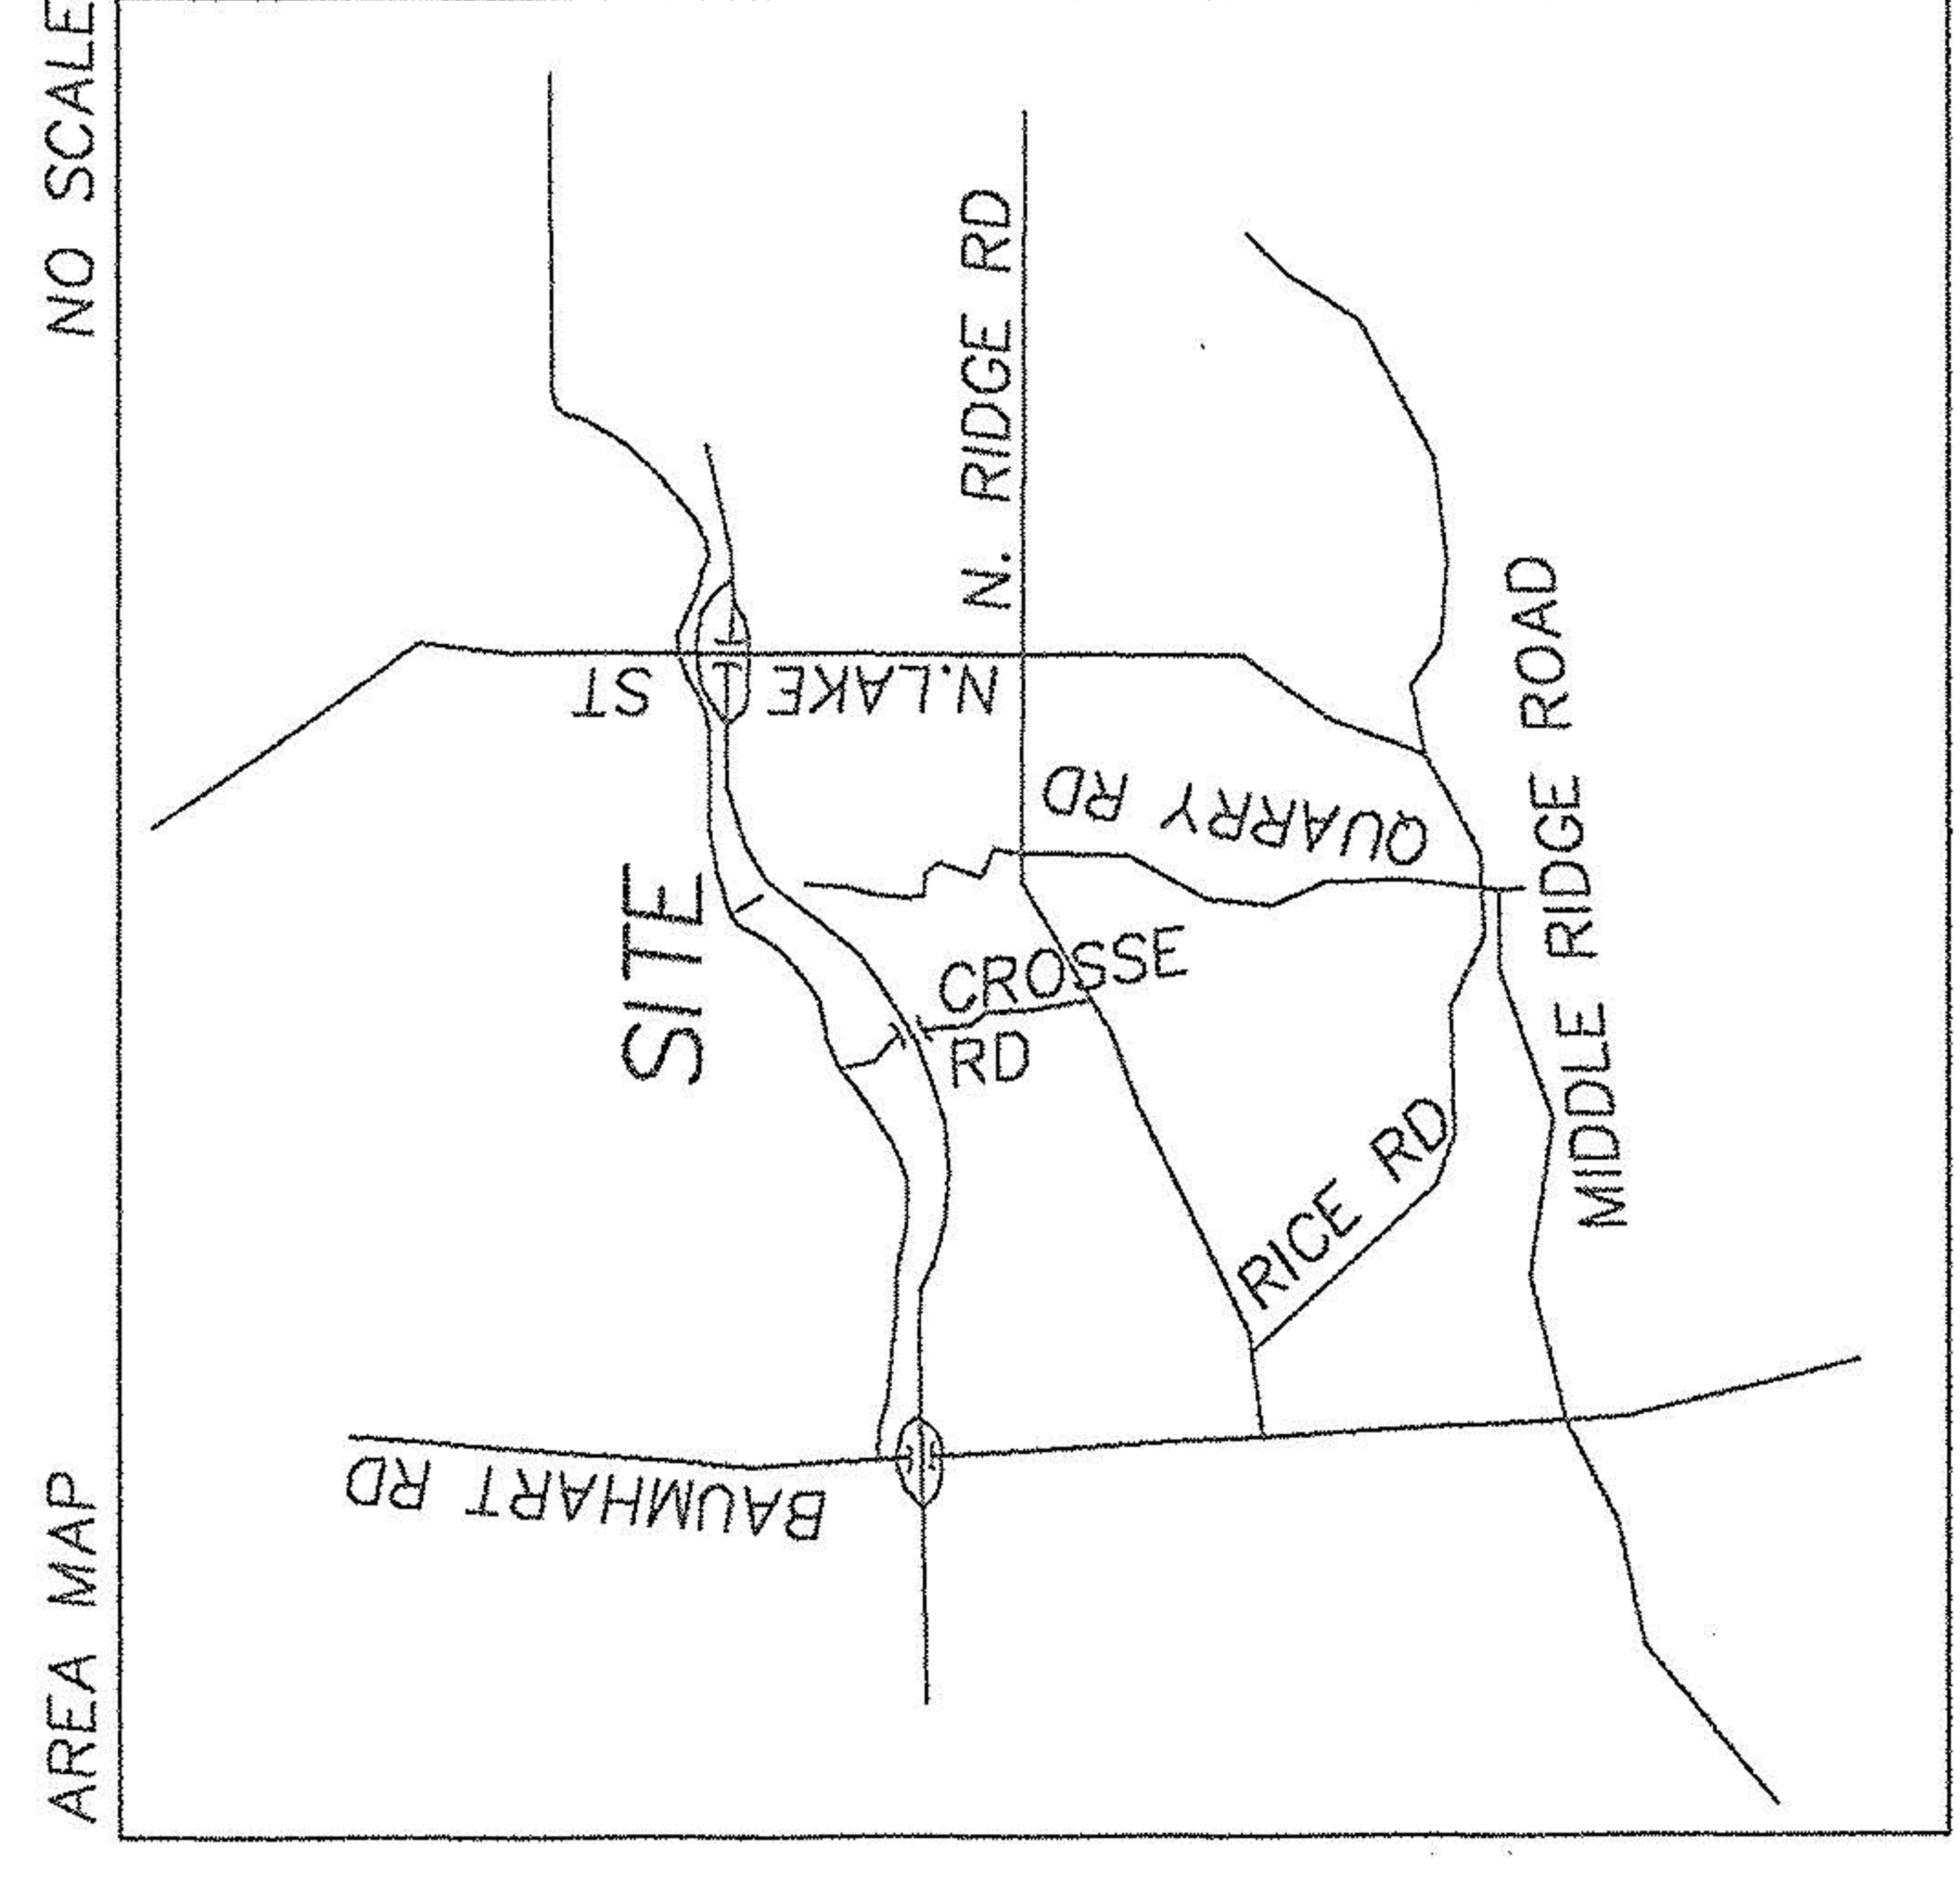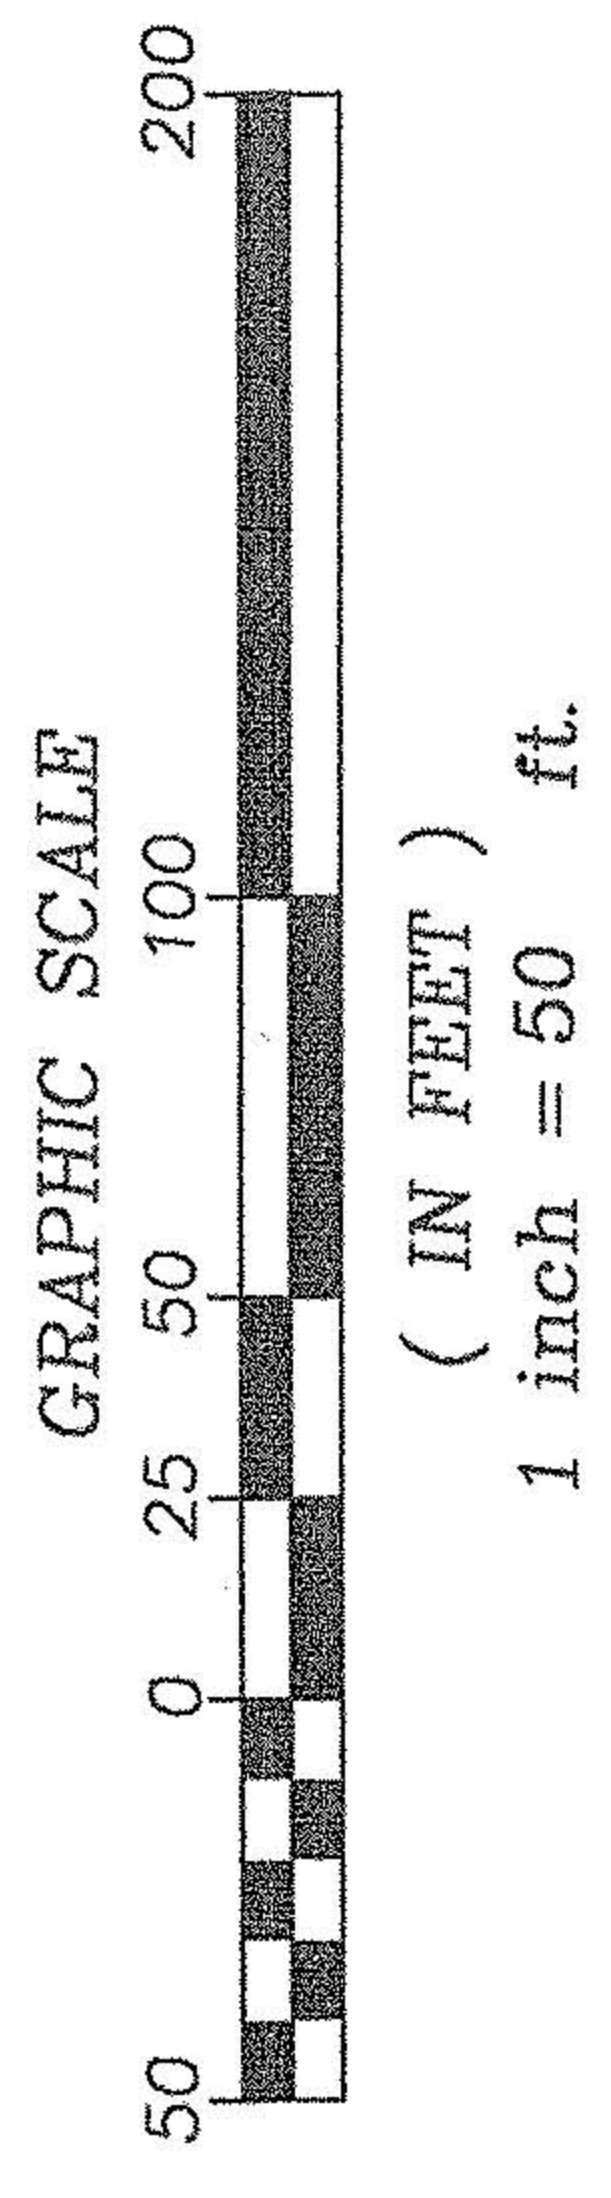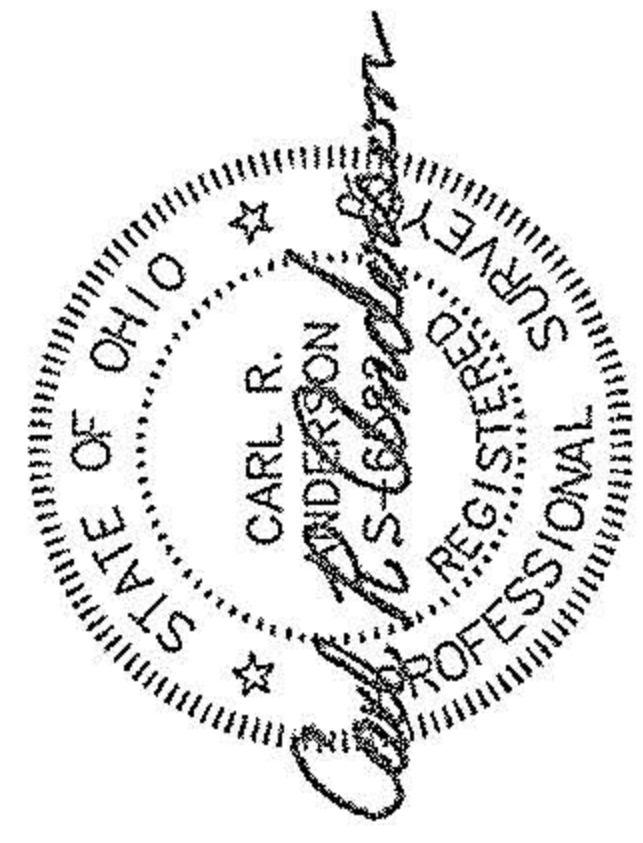

No 01389
 APPROVED
 LORAIN CO.
 MAP DEPT
 DATE 6-1-03
 PAGE 5-00-099-0
 BY J Hatfield
 # 03-01389

LEGEND

- ▲ RAILROAD SPIKE FOUND
- IRON PIN FOUND-AS NOTED
- 5/8" CAPPED REBAR SET
- PROPERTY LINE

HAYWOOD
 Civil Engineering & Land Surveying
 "Committed to Service and Quality"
 680 Cleveland Street Elyria, Ohio 44035
 Office: (440) 365-9831 Fax: (440) 365-9426
 www.haywoodcivilengineering.com