


PLAT OF BOUNDARY SURVEY
SEABOLD BROTHERS, AN OHIO PARTNERSHIP
 PART OF ORIGINAL LOT 33
 LAGRANGE TOWNSHIP,
 LORAIN COUNTY, OHIO

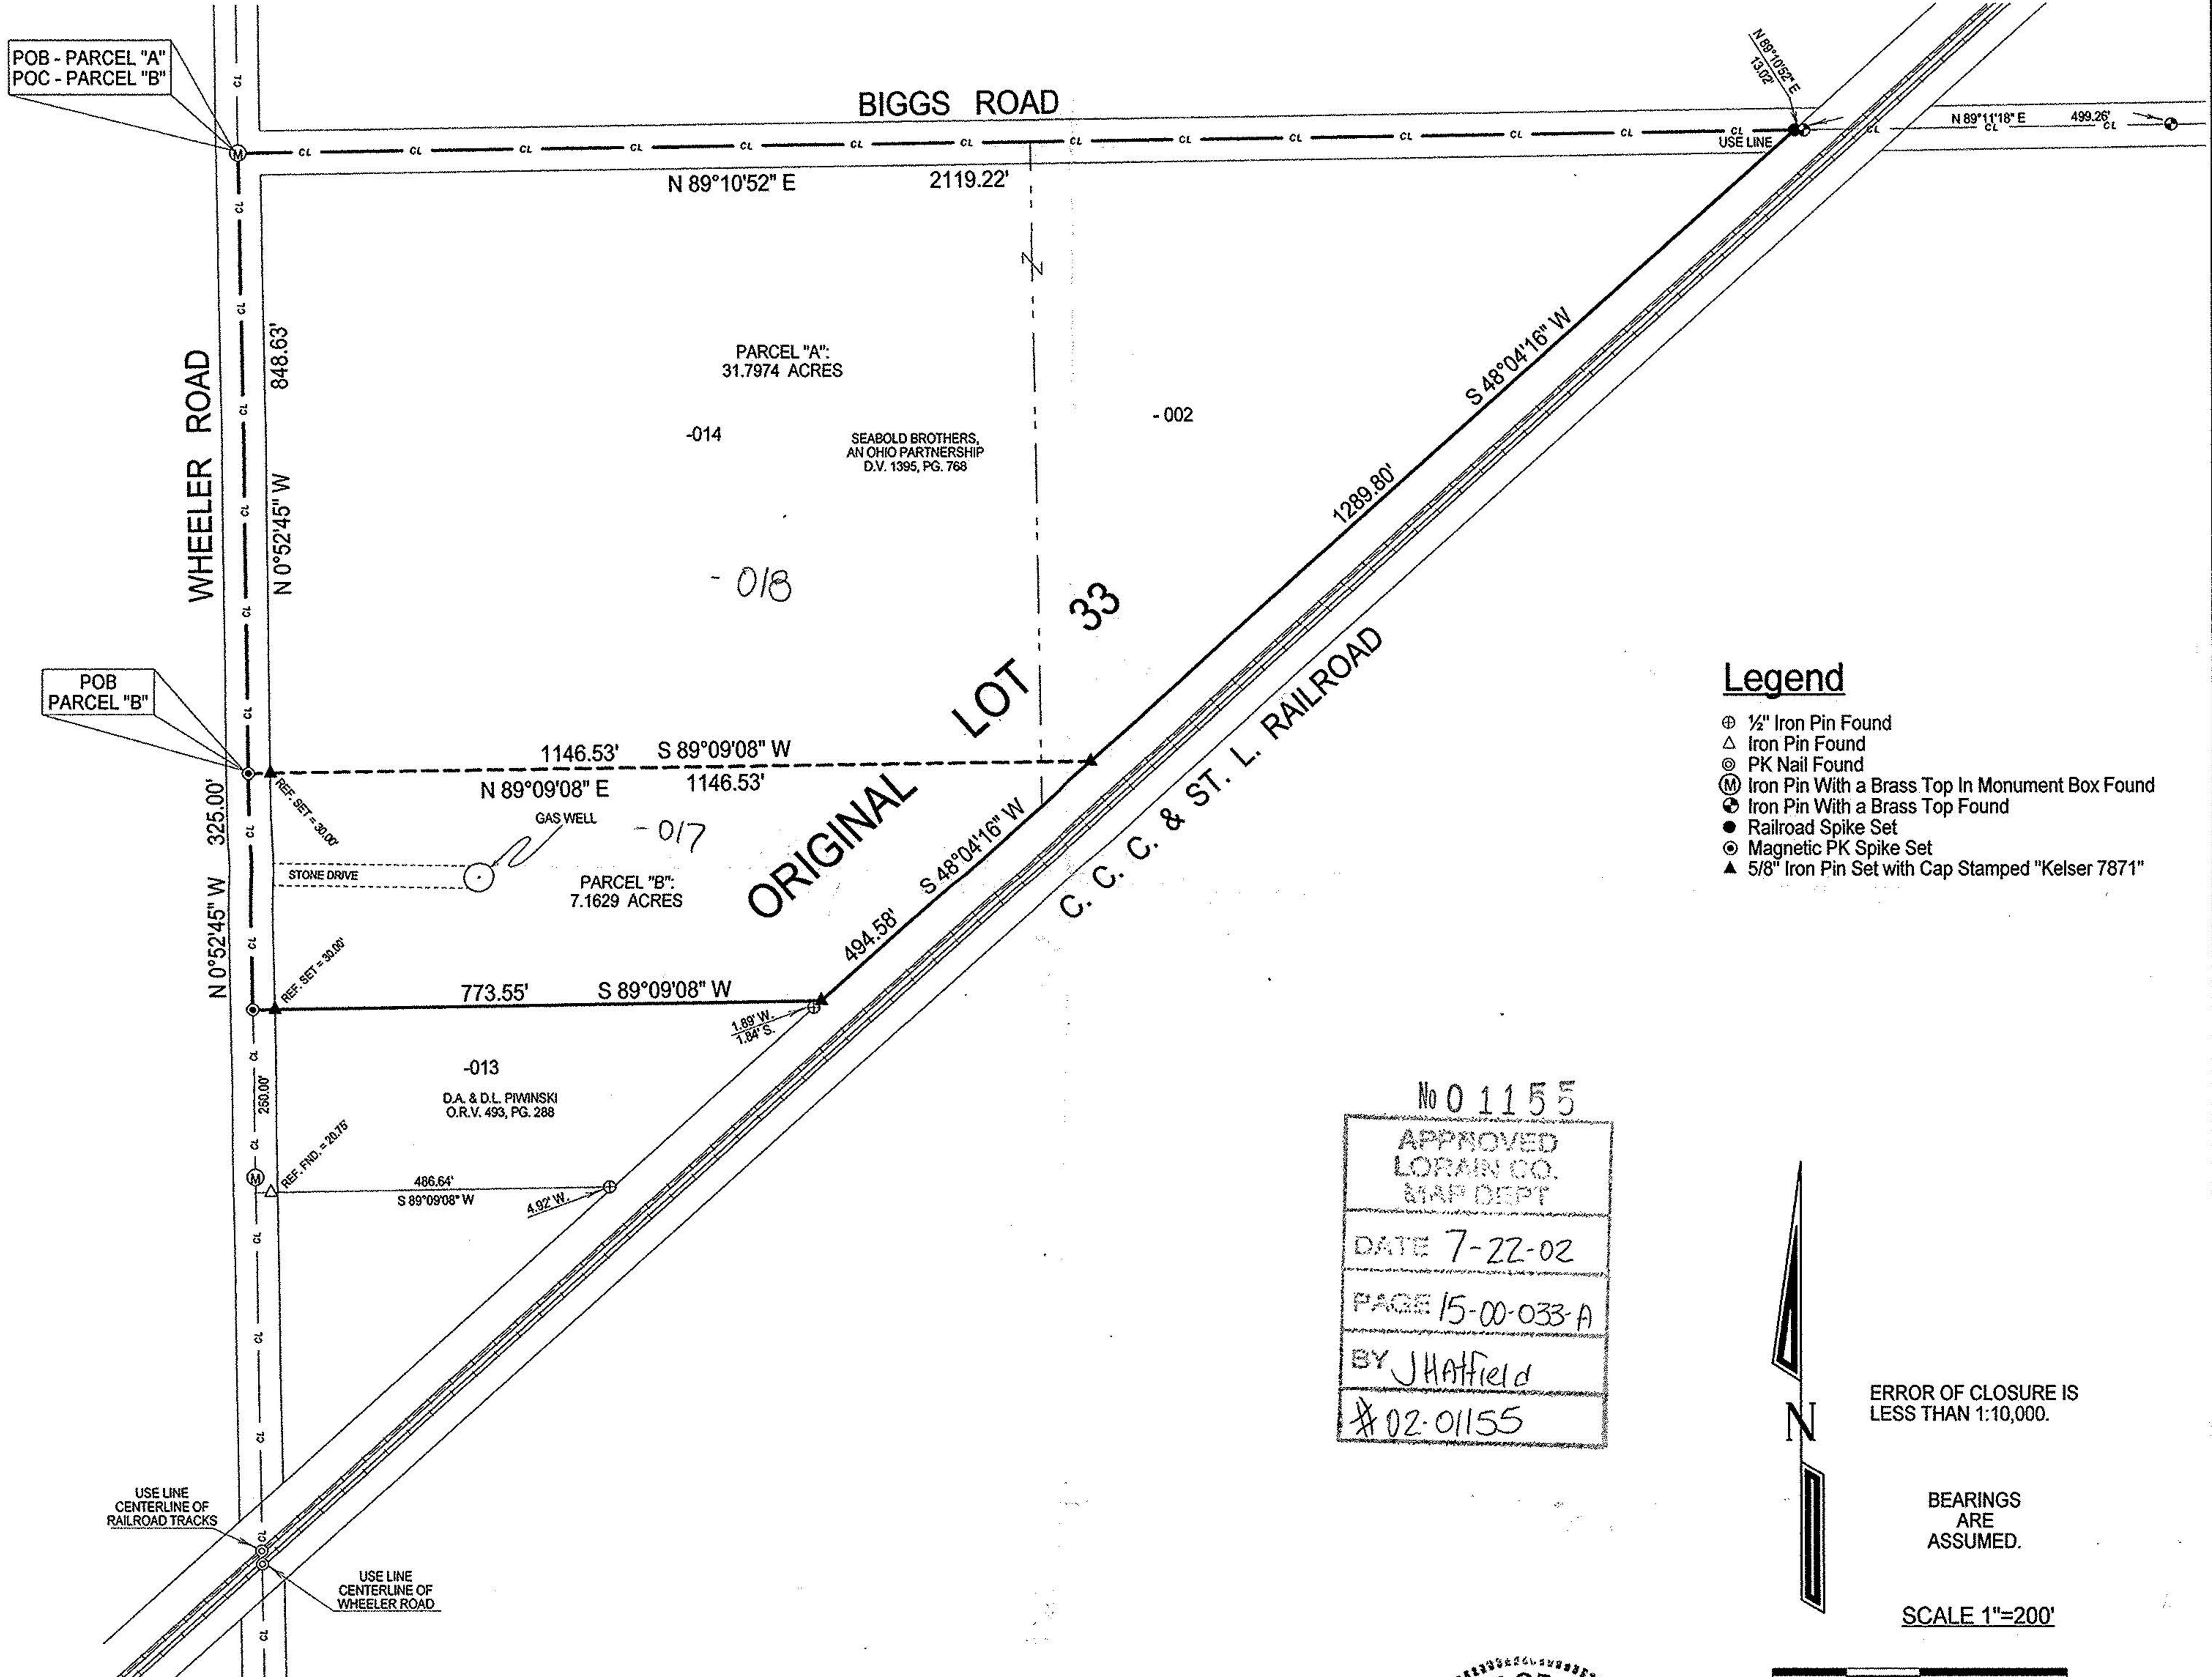

Legend

- ⊕ 1/2" Iron Pin Found
- △ Iron Pin Found
- ⊙ PK Nail Found
- Ⓜ Iron Pin With a Brass Top In Monument Box Found
- ⊗ Iron Pin With a Brass Top Found
- Railroad Spike Set
- ⊙ Magnetic PK Spike Set
- ▲ 5/8" Iron Pin Set with Cap Stamped "Kelsner 7871"


No 01155
 APPROVED
 LORAIN CO.
 MAP DEPT
 DATE 7-22-02
 PAGE 15-00-033-A
 BY JHAfield
 #02-01155



ERROR OF CLOSURE IS
 LESS THAN 1:10,000.

BEARINGS
 ARE
 ASSUMED.

SCALE 1"=200'

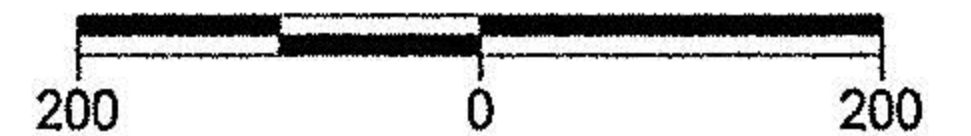

LAUNDON • SIMON • KELSER & ASSOC., INC.
 PROFESSIONAL LAND SURVEYORS
 110 MIDDLE AVE. • ELYRIA, OHIO • 44035
 PHONE (440) 322-7625
 Alex Kelsner RLS #7871

DATE:	9/26/00
JOB NO.:	003300