


June 2001  
Job No. 1501.06

This survey represents the minimum standards for boundary surveys in the State of Ohio as adopted 5-1-80 of the Administrative Code chapter 4733-37.

Assumed

Basis of bearings is the record bearing for the centerline of Indian Hollow Road as found in Deed Volume 1179 P. 689.

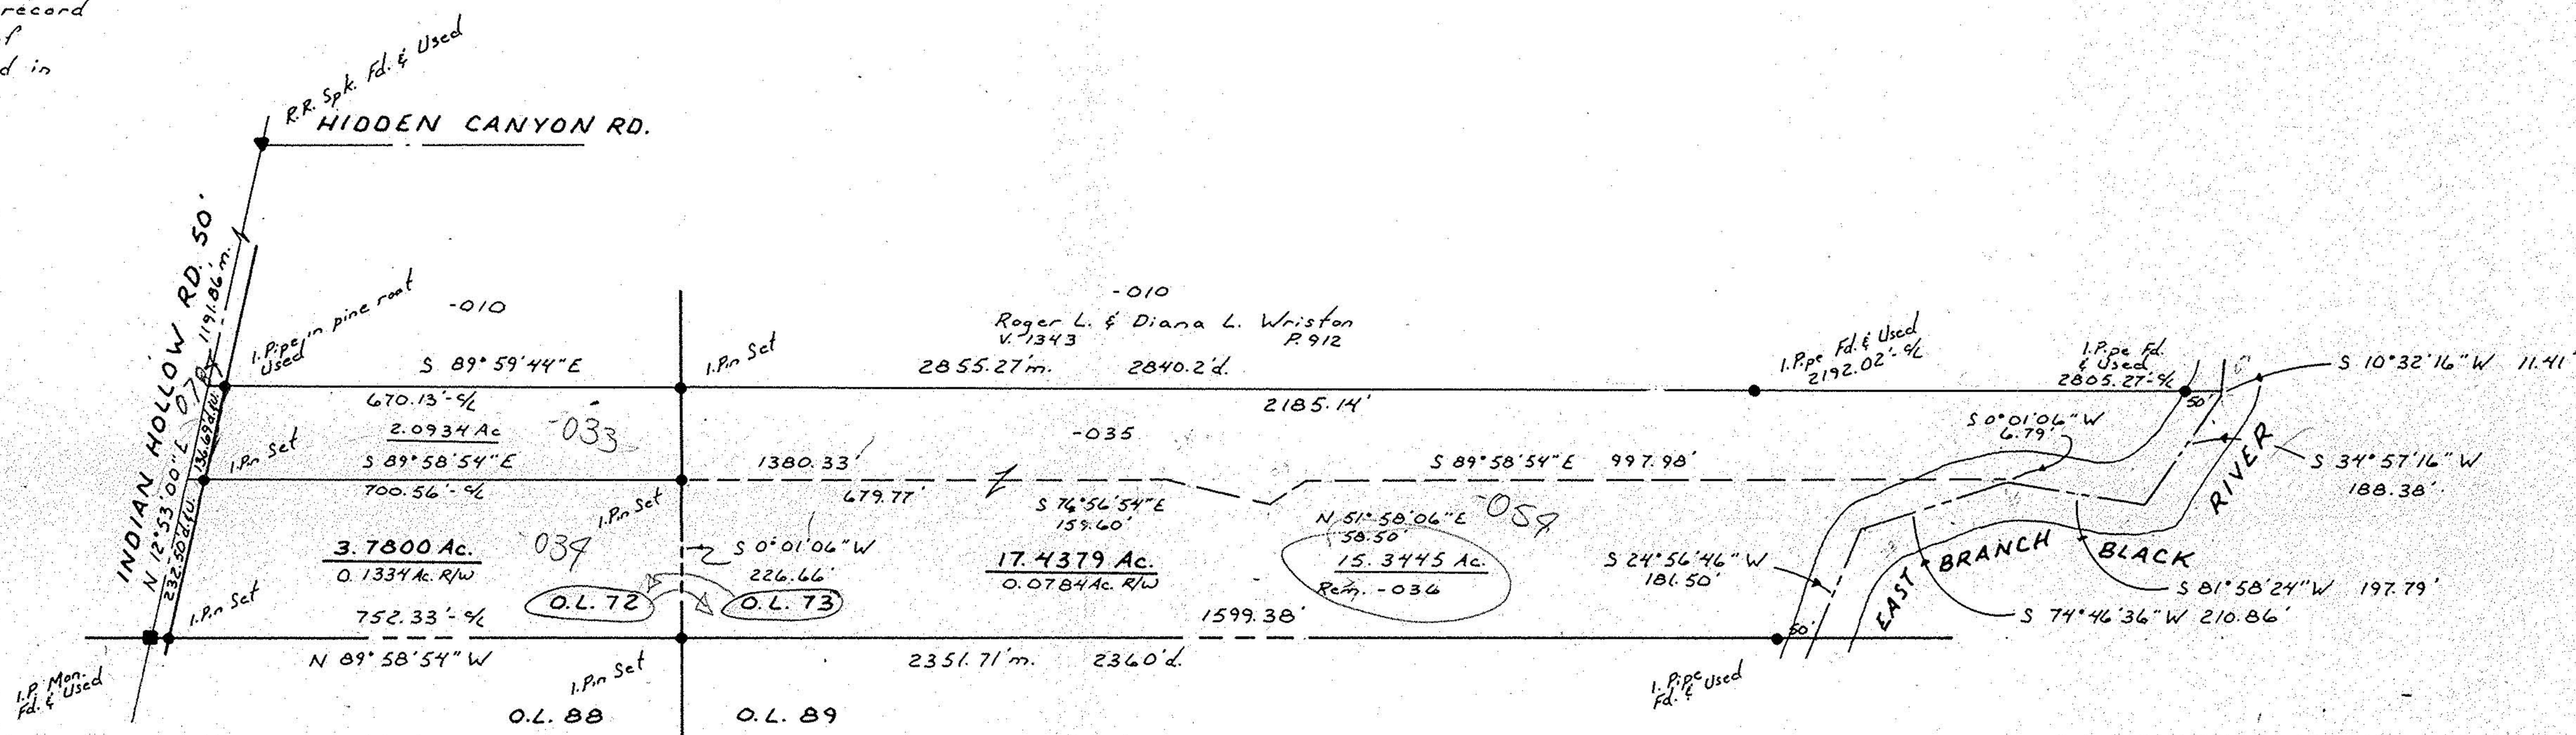

No 00941  
APPROVED  
LORAIN CO.  
MAP DEPT  
DATE 12-18-01  
PAGE 15-00-072-A  
BY JHATFIELD  
#01-00941

No 00813-A  
APPROVED  
LORAIN CO.  
MAP DEPT  
DATE 2-11-03  
PAGE 15-00-072-A  
BY JHATFIELD  
#03-00813-A



SURVEY FOR  
**BOBBY C. BARKER**

LaGrange Twp. O.L. 72 & 73  
Lorain County Ohio  
P.P. No. 15-00-072-000-035 & 036  
D.V. 1179 P. 689 & D.V. 1418 P. 21  
CARLSON SURVEYS  
440-926-0200