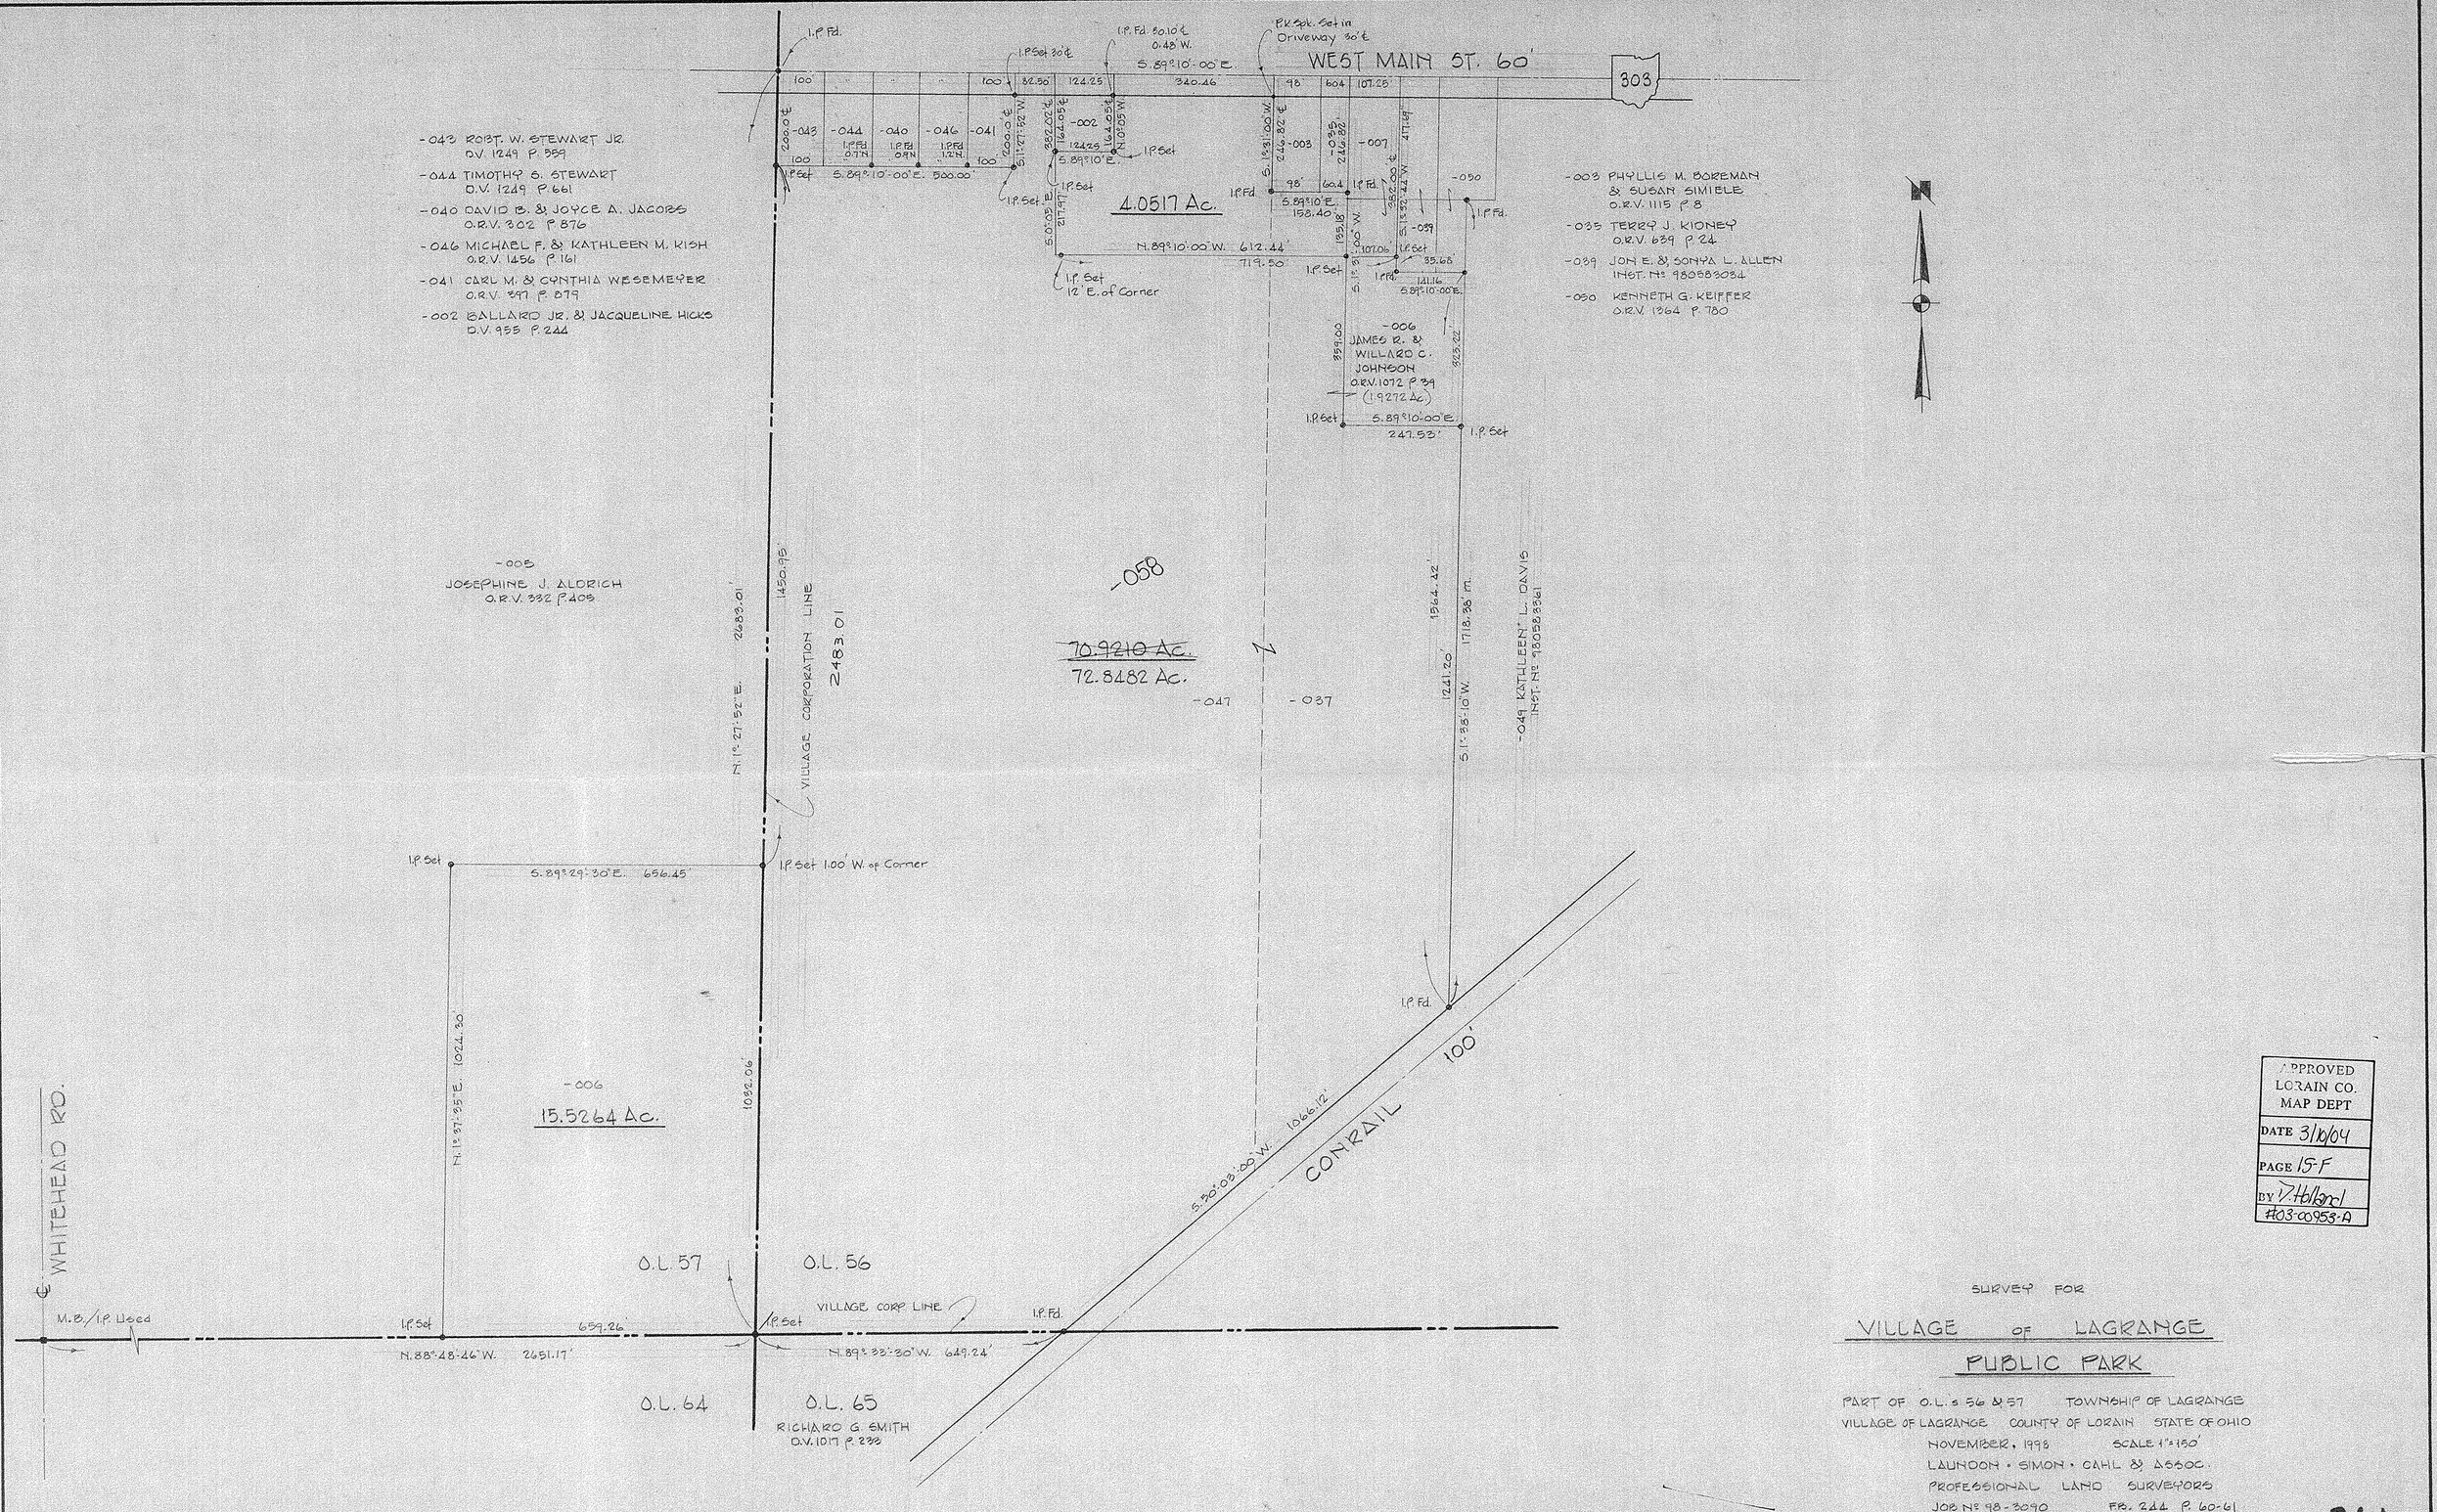
WEST MAIN ST. 60'
303
S.89°10'-00"E 340.46
S.89°10'-00"E. 500.00'
4.0517 Ac.
N.89°10'-00"W. 612.44'
719.50'
I.P. Set 12' E. of Corner
-043 ROBT. W. STEWART JR. O.V. 1249 P. 389
-044 TIMOTHY S. STEWART O.V. 1249 P. 661
-040 DAVID B. & JOYCE A. JACOBS O.R.V. 302 P. 876
-046 MICHAEL F. & KATHLEEN M. KISH O.R.V. 1456 P. 161
-041 CARL M. & CYNTHIA WESEMEYER O.R.V. 297 P. 879
-002 BALLARD JR. & JACQUELINE HICKS O.V. 955 P. 244
-003 PHYLLIS M. BOREMAN & SUSAN SIMIELE O.R.V. 1115 P. 8
-035 TERRY J. KIONEY O.R.V. 639 P. 24
-039 JON E. & SONYA L. ALLEN INST. Nº 980583034
-050 KENNETH G. KEIFFER O.R.V. 1364 P. 700
-006 JAMES R. & WILLARD C. JOHNSON O.R.V. 1072 P. 39 (1.9272 Ac.)
S.89°10'-00"E. 247.53'
-005 JOSEPHINE J. ALDRICH O.R.V. 332 P. 405
-058
~~70.9210 Ac.~~
72.8482 Ac.
-047
-037
-049 KATHLEEN L. DAVIS INST. Nº 980583061
VILLAGE CORPORATION LINE
N.1°27'-52"E. 2683.01'
1450.95'
1718.38' m.
1241.20'
S.1°35'-10"W.
S.89°29'-30"E. 656.45'
I.P. Set 1.00' W. of Corner
N.1°27'-55"E. 1024.30'
1032.06'
-006
15.5264 Ac.
WHITEHEAD RD.
CONRAIL
100'
S.50°03'-00"W. 1066.12'
O.L. 57
O.L. 56
O.L. 64
O.L. 65
RICHARD G. SMITH O.V. 1017 P. 233
M.B./I.P. Used
N.88°48'-46"W. 2651.17'
N.89°33'-30"W. 649.24'
659.26
VILLAGE CORP LINE
APPROVED LORAIN CO. MAP DEPT
DATE 3/10/04
PAGE 15-F
BY T. Holland
#03-00958-A
SURVEY FOR
VILLAGE OF LAGRANGE
PUBLIC PARK
PART OF O.L.'s 56 & 57 TOWNSHIP OF LAGRANGE
VILLAGE OF LAGRANGE COUNTY OF LORAIN STATE OF OHIO
NOVEMBER, 1998 SCALE 1"=150'
LAUNDON • SIMON • CAHL & ASSOC.
PROFESSIONAL LAND SURVEYORS
JOB Nº 98-3090 FR. 244 P. 60-61
REVISED - 8/28/00 Combine 1.9272 Ac. of Johnson Prop.
361