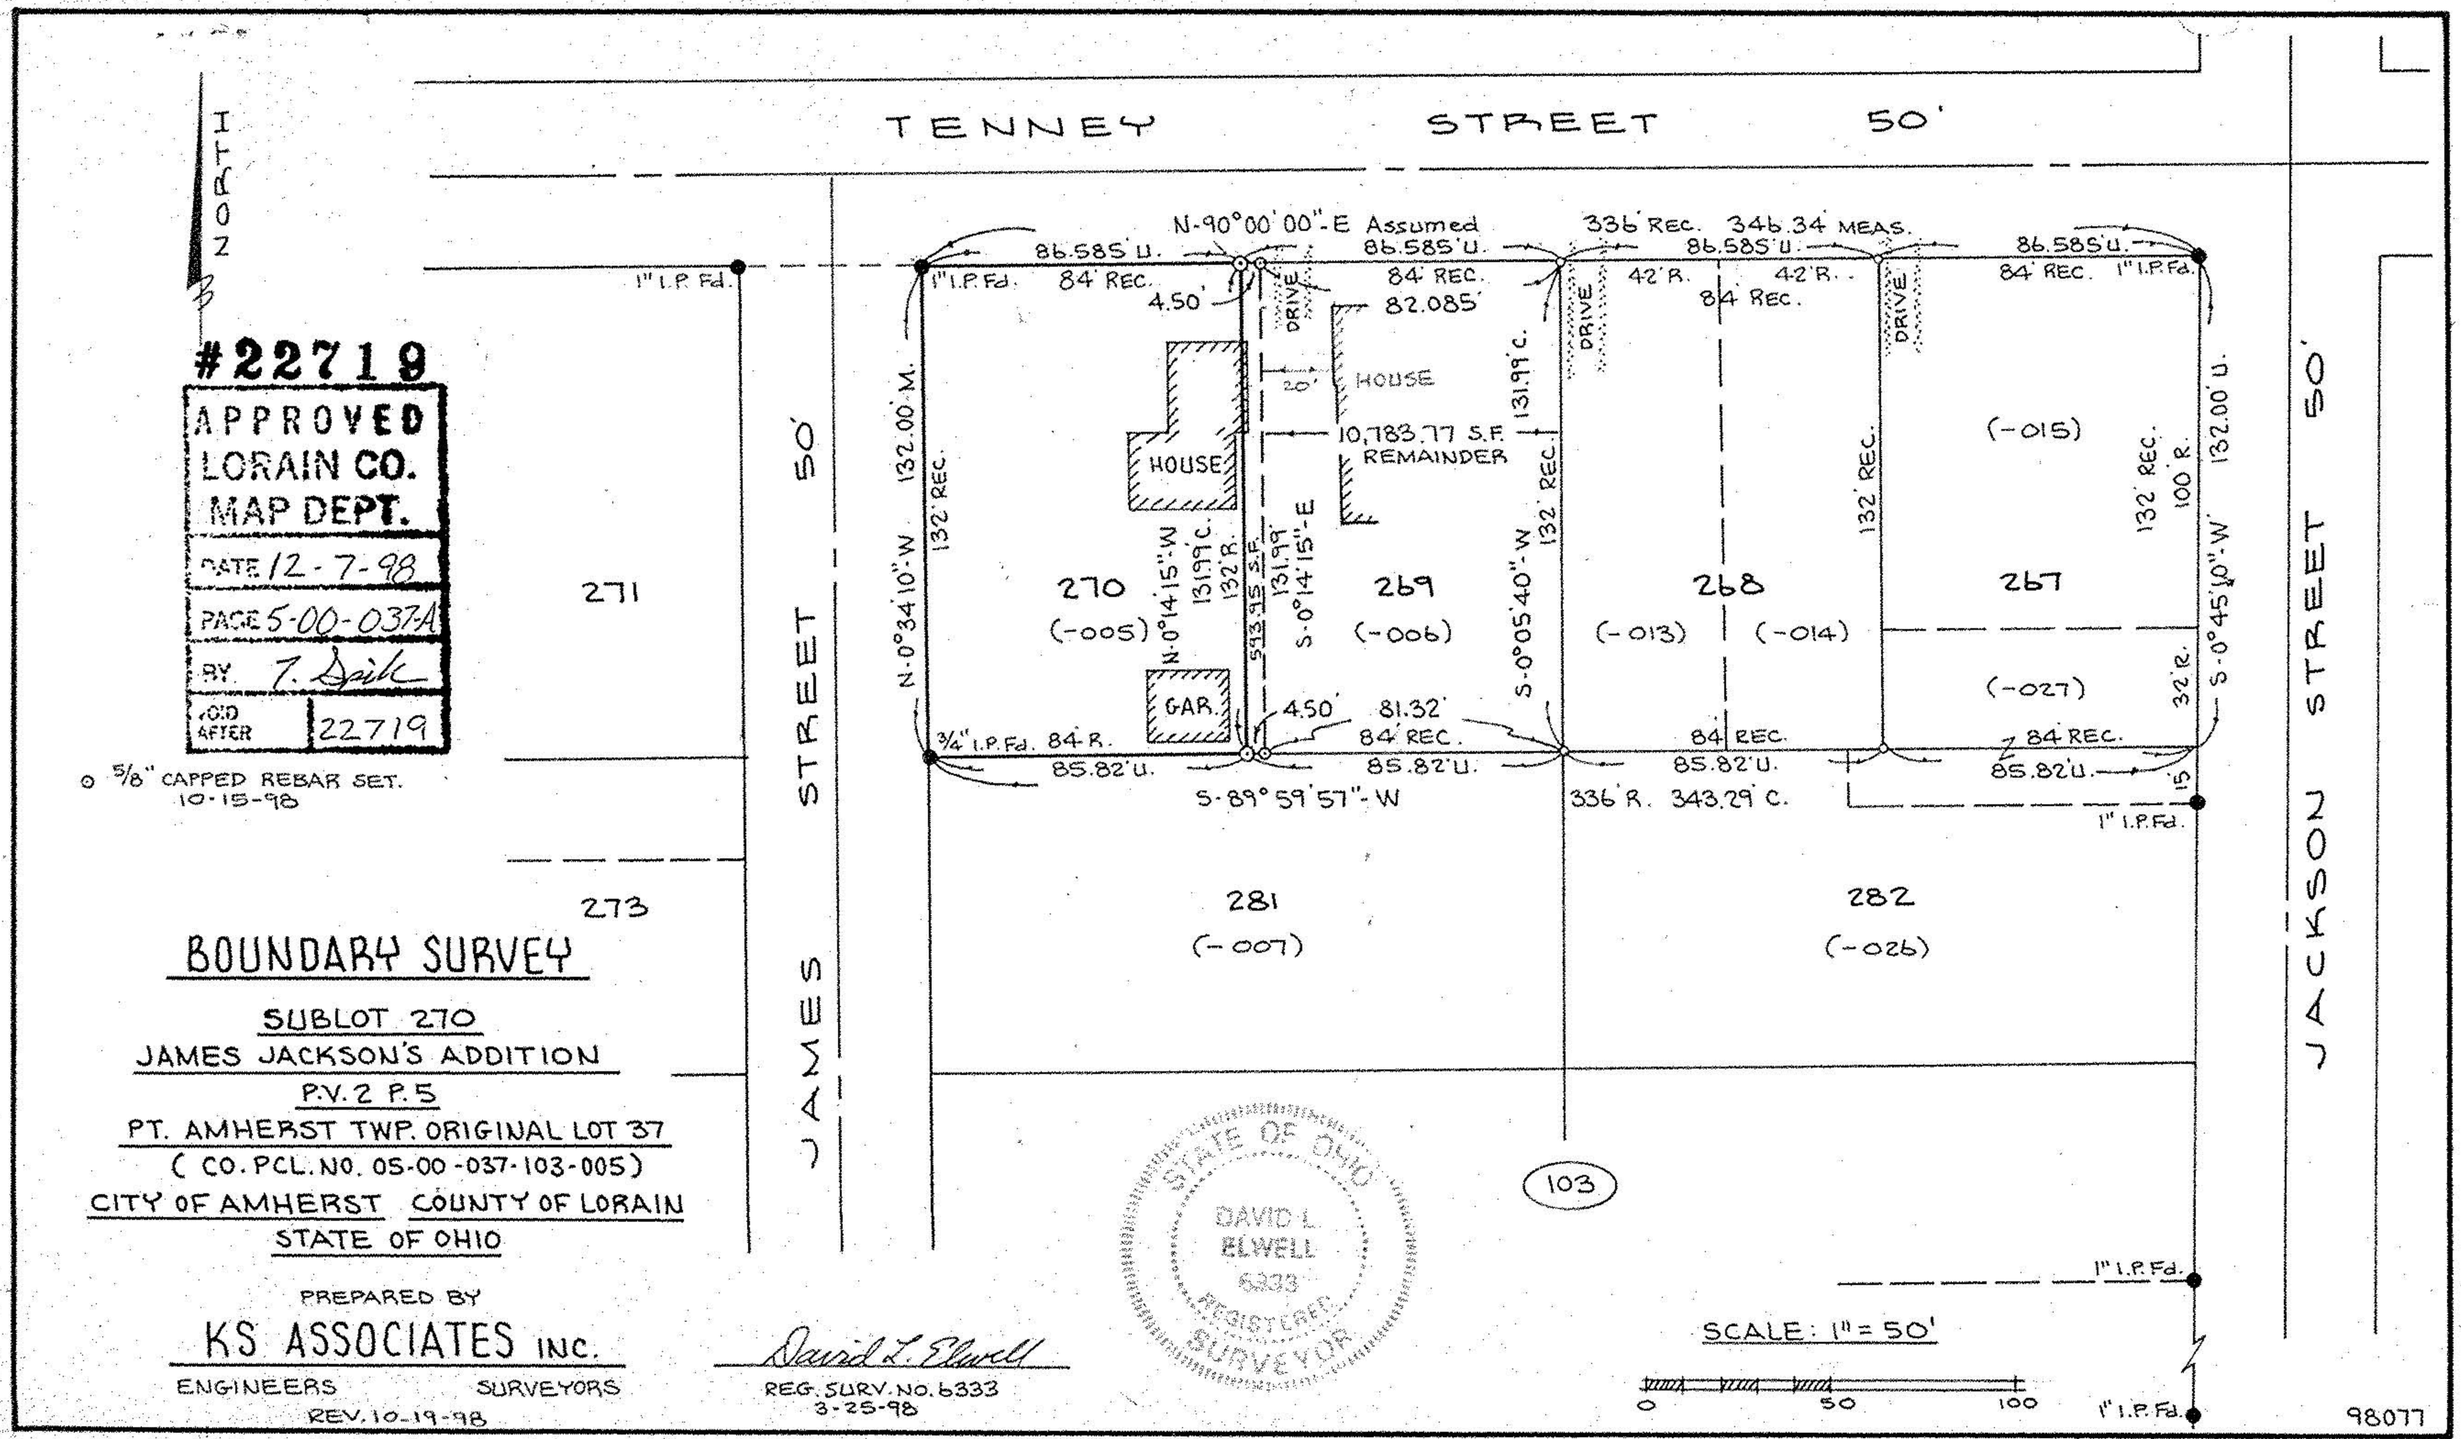

#22719

APPROVED
LORAIN CO.
MAP DEPT.
DATE 12-7-98
PAGE 5-00-037-A
BY T. Spik
VOID AFTER 22719

⊙ 5/8" CAPPED REBAR SET. 10-15-98

BOUNDARY SURVEY

SUBLOT 270
JAMES JACKSON'S ADDITION
P.V. 2 P. 5
PT. AMHERST TWP. ORIGINAL LOT 37
(CO. PCL. NO. 05-00-037-103-005)
CITY OF AMHERST COUNTY OF LORAIN
STATE OF OHIO

PREPARED BY
KS ASSOCIATES INC.
ENGINEERS SURVEYORS
REV. 10-19-98

David L. Elwell
REG. SURV. NO. 6333
3-25-98

STATE OF OHIO
DAVID L. ELWELL
6333
REGISTERED SURVEYOR

98077