


TH Pg. 8-E

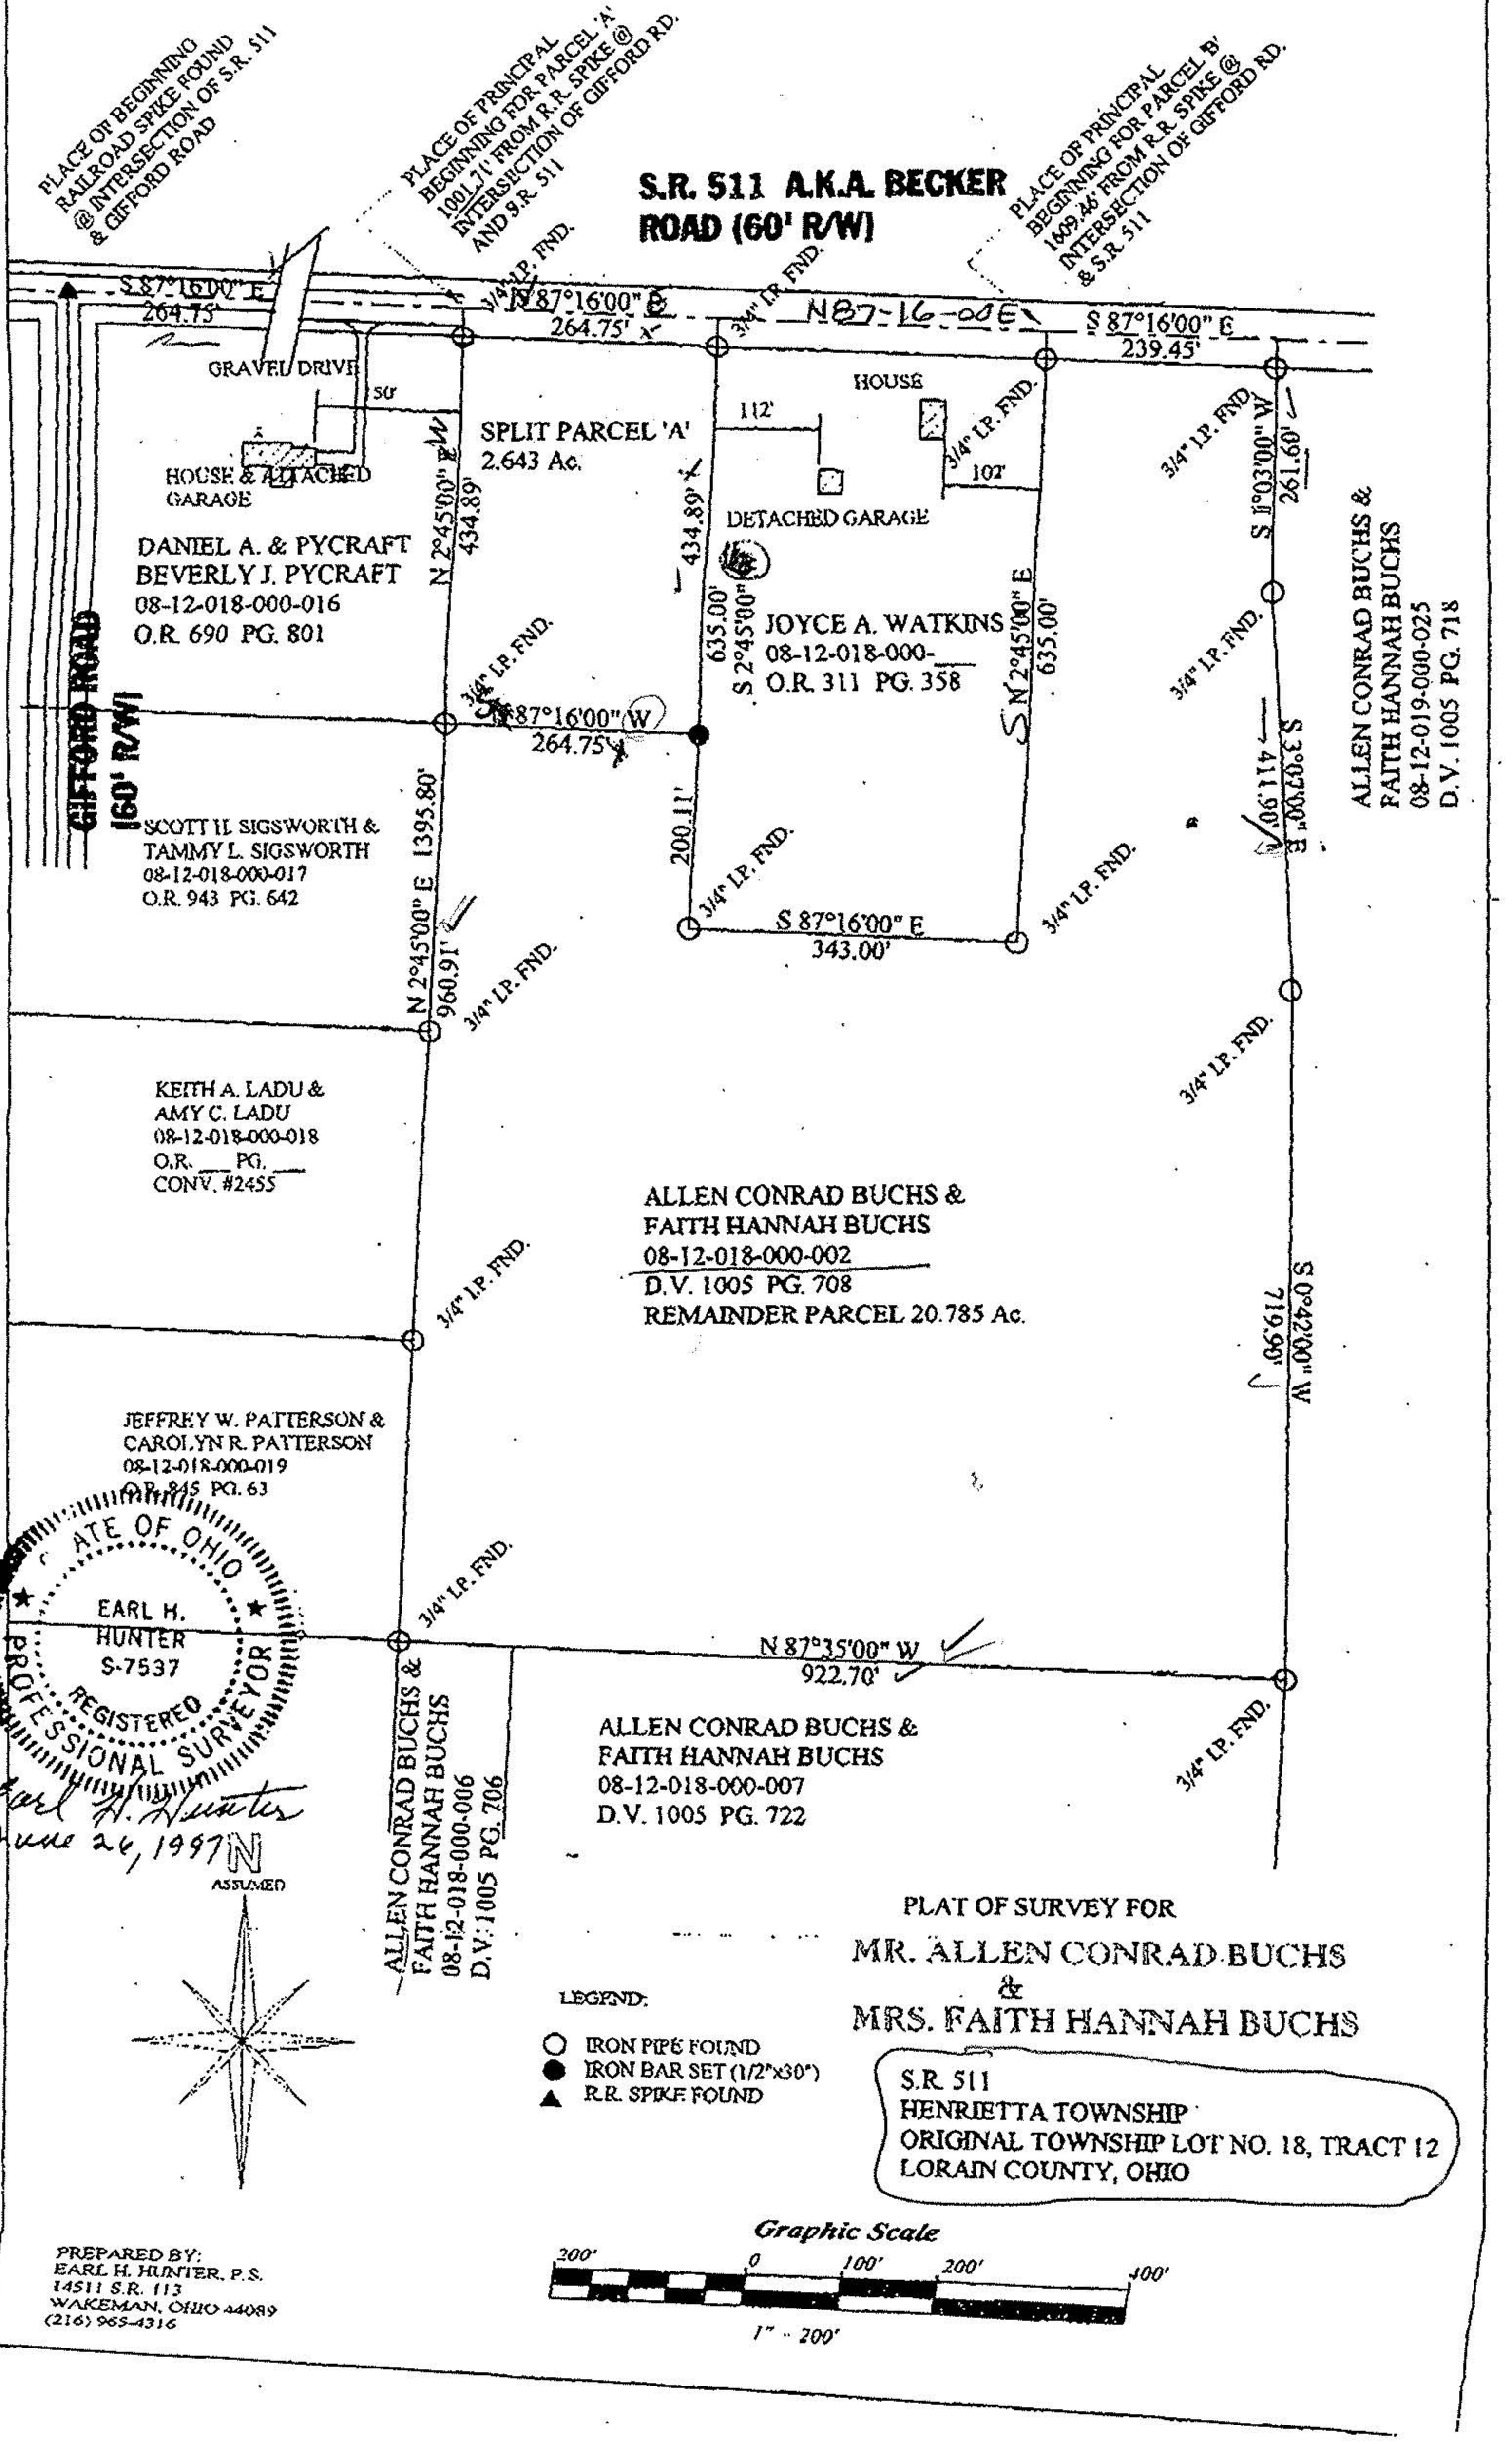

**S.R. 511 A.K.A. BECKER ROAD (60' R/W)**

DANIEL A. & PYCRAFT  
BEVERLY J. PYCRAFT  
08-12-018-000-016  
O.R. 690 PG. 801

SCOTT H. SIGSWORTH &  
TAMMY L. SIGSWORTH  
08-12-018-000-017  
O.R. 943 PG. 642

KEITH A. LADU &  
AMY C. LADU  
08-12-018-000-018  
O.R. PG.   
CONV. #2455

JEFFREY W. PATTERSON &  
CAROLYN R. PATTERSON  
08-12-018-000-019  
O.R. PG. 63

SPLIT PARCEL 'A'  
2.643 Ac.

JOYCE A. WATKINS  
08-12-018-000-  
O.R. 311 PG. 358

ALLEN CONRAD BUCHS &  
FAITH HANNAH BUCHS  
08-12-018-000-002  
D.V. 1005 PG. 708  
REMAINDER PARCEL 20.785 Ac.

ALLEN CONRAD BUCHS &  
FAITH HANNAH BUCHS  
08-12-018-000-006  
D.V. 1005 PG. 706


ALLEN CONRAD BUCHS &  
FAITH HANNAH BUCHS  
08-12-018-000-007  
D.V. 1005 PG. 722

ALLEN CONRAD BUCHS &  
FAITH HANNAH BUCHS  
08-12-019-000-025  
D.V. 1005 PG. 718


PLAT OF SURVEY FOR  
MR. ALLEN CONRAD BUCHS  
&  
MRS. FAITH HANNAH BUCHS

S.R. 511  
HENRIETTA TOWNSHIP  
ORIGINAL TOWNSHIP LOT NO. 18, TRACT 12  
LORAIN COUNTY, OHIO

STATE OF OHIO  
EARL H. HUNTER  
S-7537  
REGISTERED PROFESSIONAL SURVEYOR  
June 26, 1997

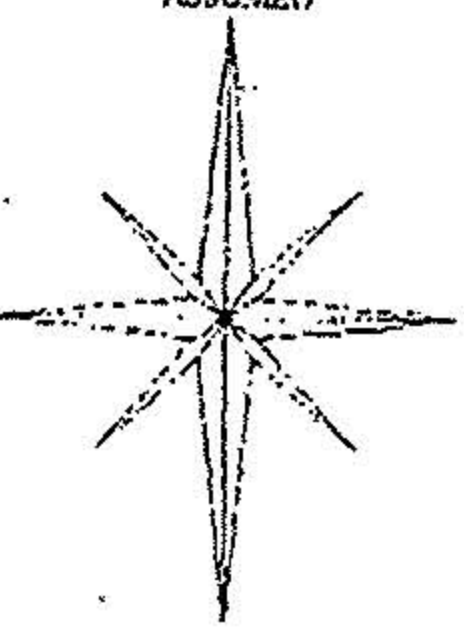

- LEGEND:
- IRON PIPE FOUND
  - IRON BAR SET (1/2"x30")
  - ▲ R.R. SPIKE FOUND

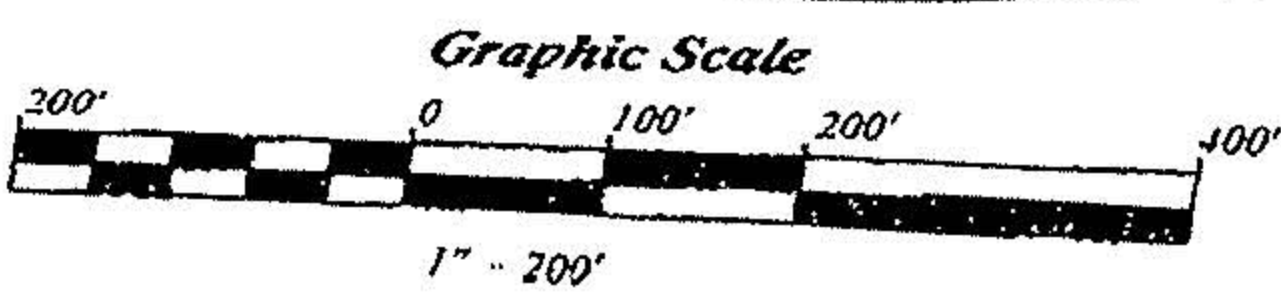

PREPARED BY:  
EARL H. HUNTER, P.S.  
14511 S.R. 113  
WAKEMAN, OHIO 44089  
(216) 965-4316