


21-17-021-000-005


21-17-021

WEST ROAD

● IRON PIV FD.
○ IRON PIV SET
SCALE: 1"=100'

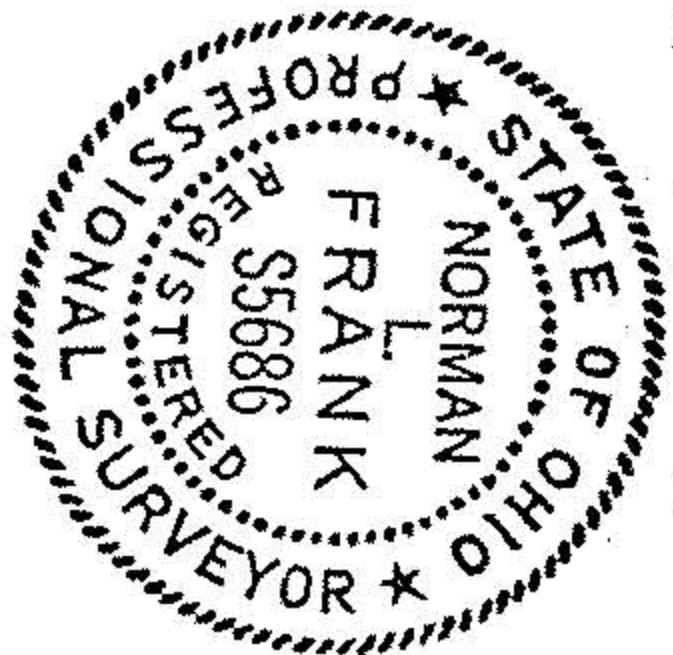

STEWART ROAD (60')

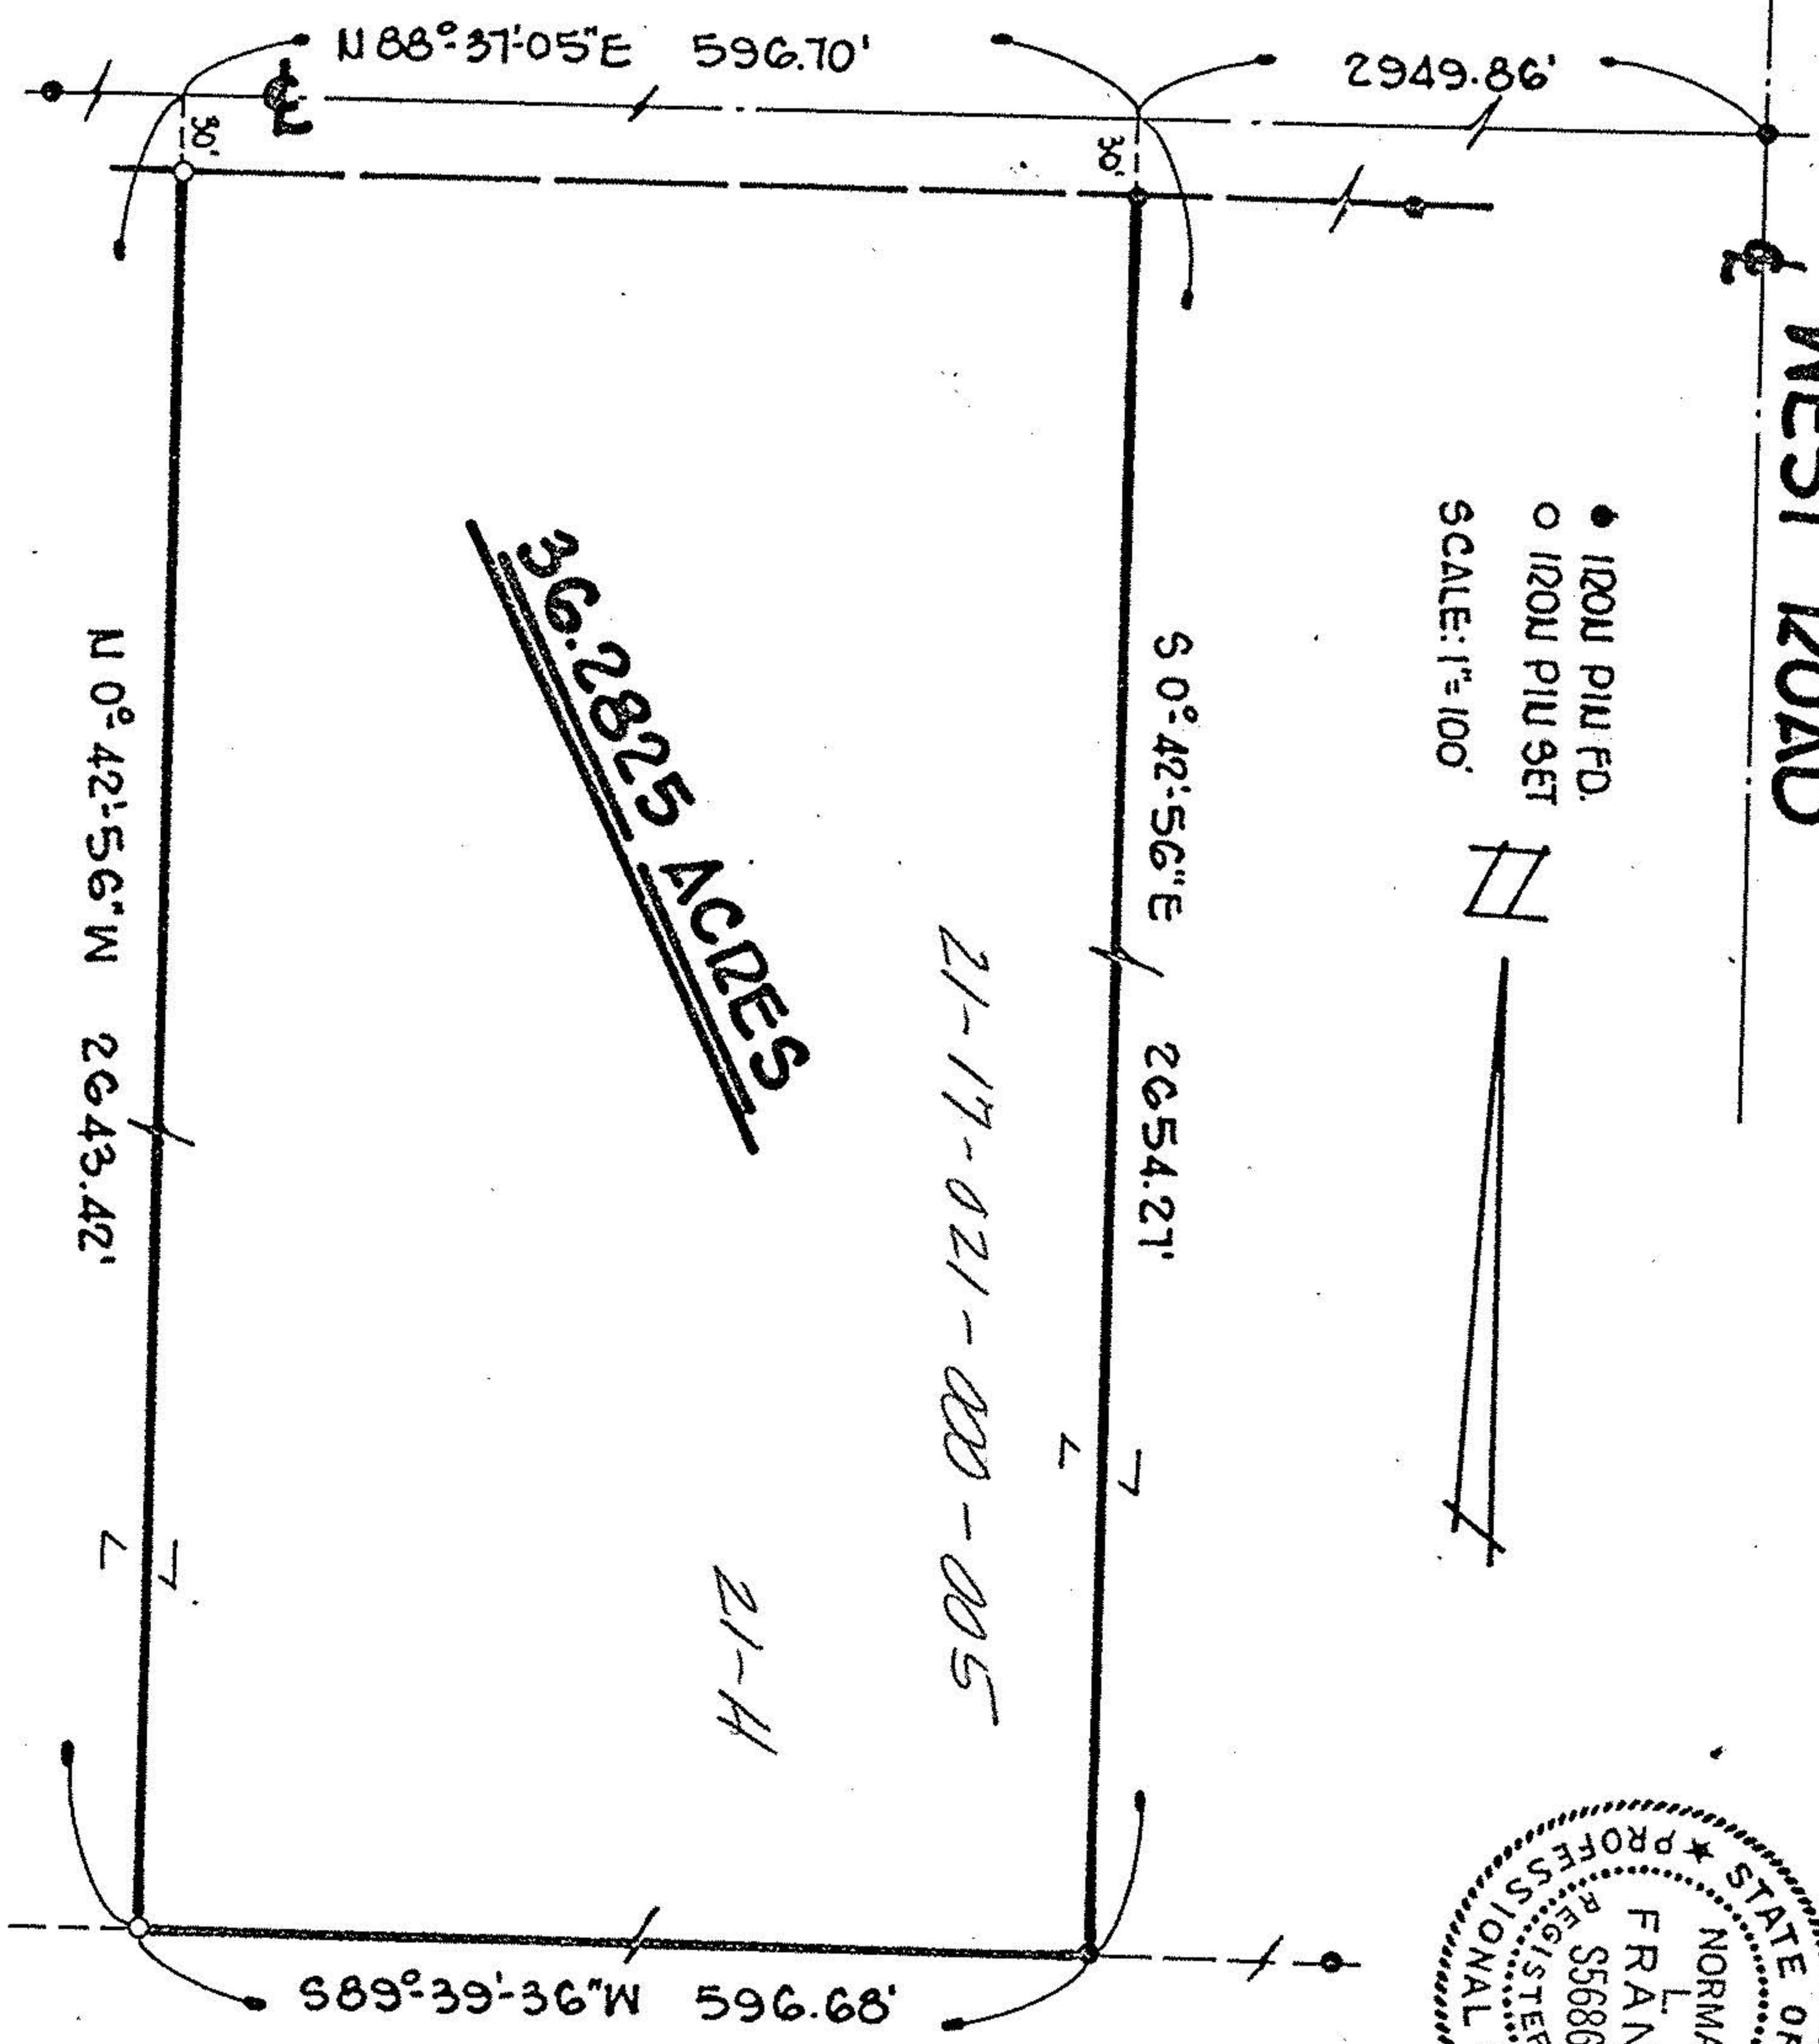

21-17-021-000-005

STATE:	OHIO	COUNTY:	LODAIN
TOWNSHIP:	HUNTINGTON		
LOT:	21	TRACT/SECTION:	17
OWNER:	RUTH D. KZUECK		
PROJECT:	76-137	DATE:	JUNE, 1976
NORMAN L. FRANK, R.S. P. O. BOX 404 4435 PEARL ROAD MEDINA, OHIO 44256 MEDINA: 725-4825			

WOOSTER: 264-4171